

RASTER



PARENT PARCEL: 04-00-015-110-042, -046, -058, -271

09-02718

CHILD PARCEL: 04-00-015-110-273 THRU -276

STARTING POINT: INT CL S.R.83 AND DETROIT RD

CORR PER SURVEY
T. BIXLER

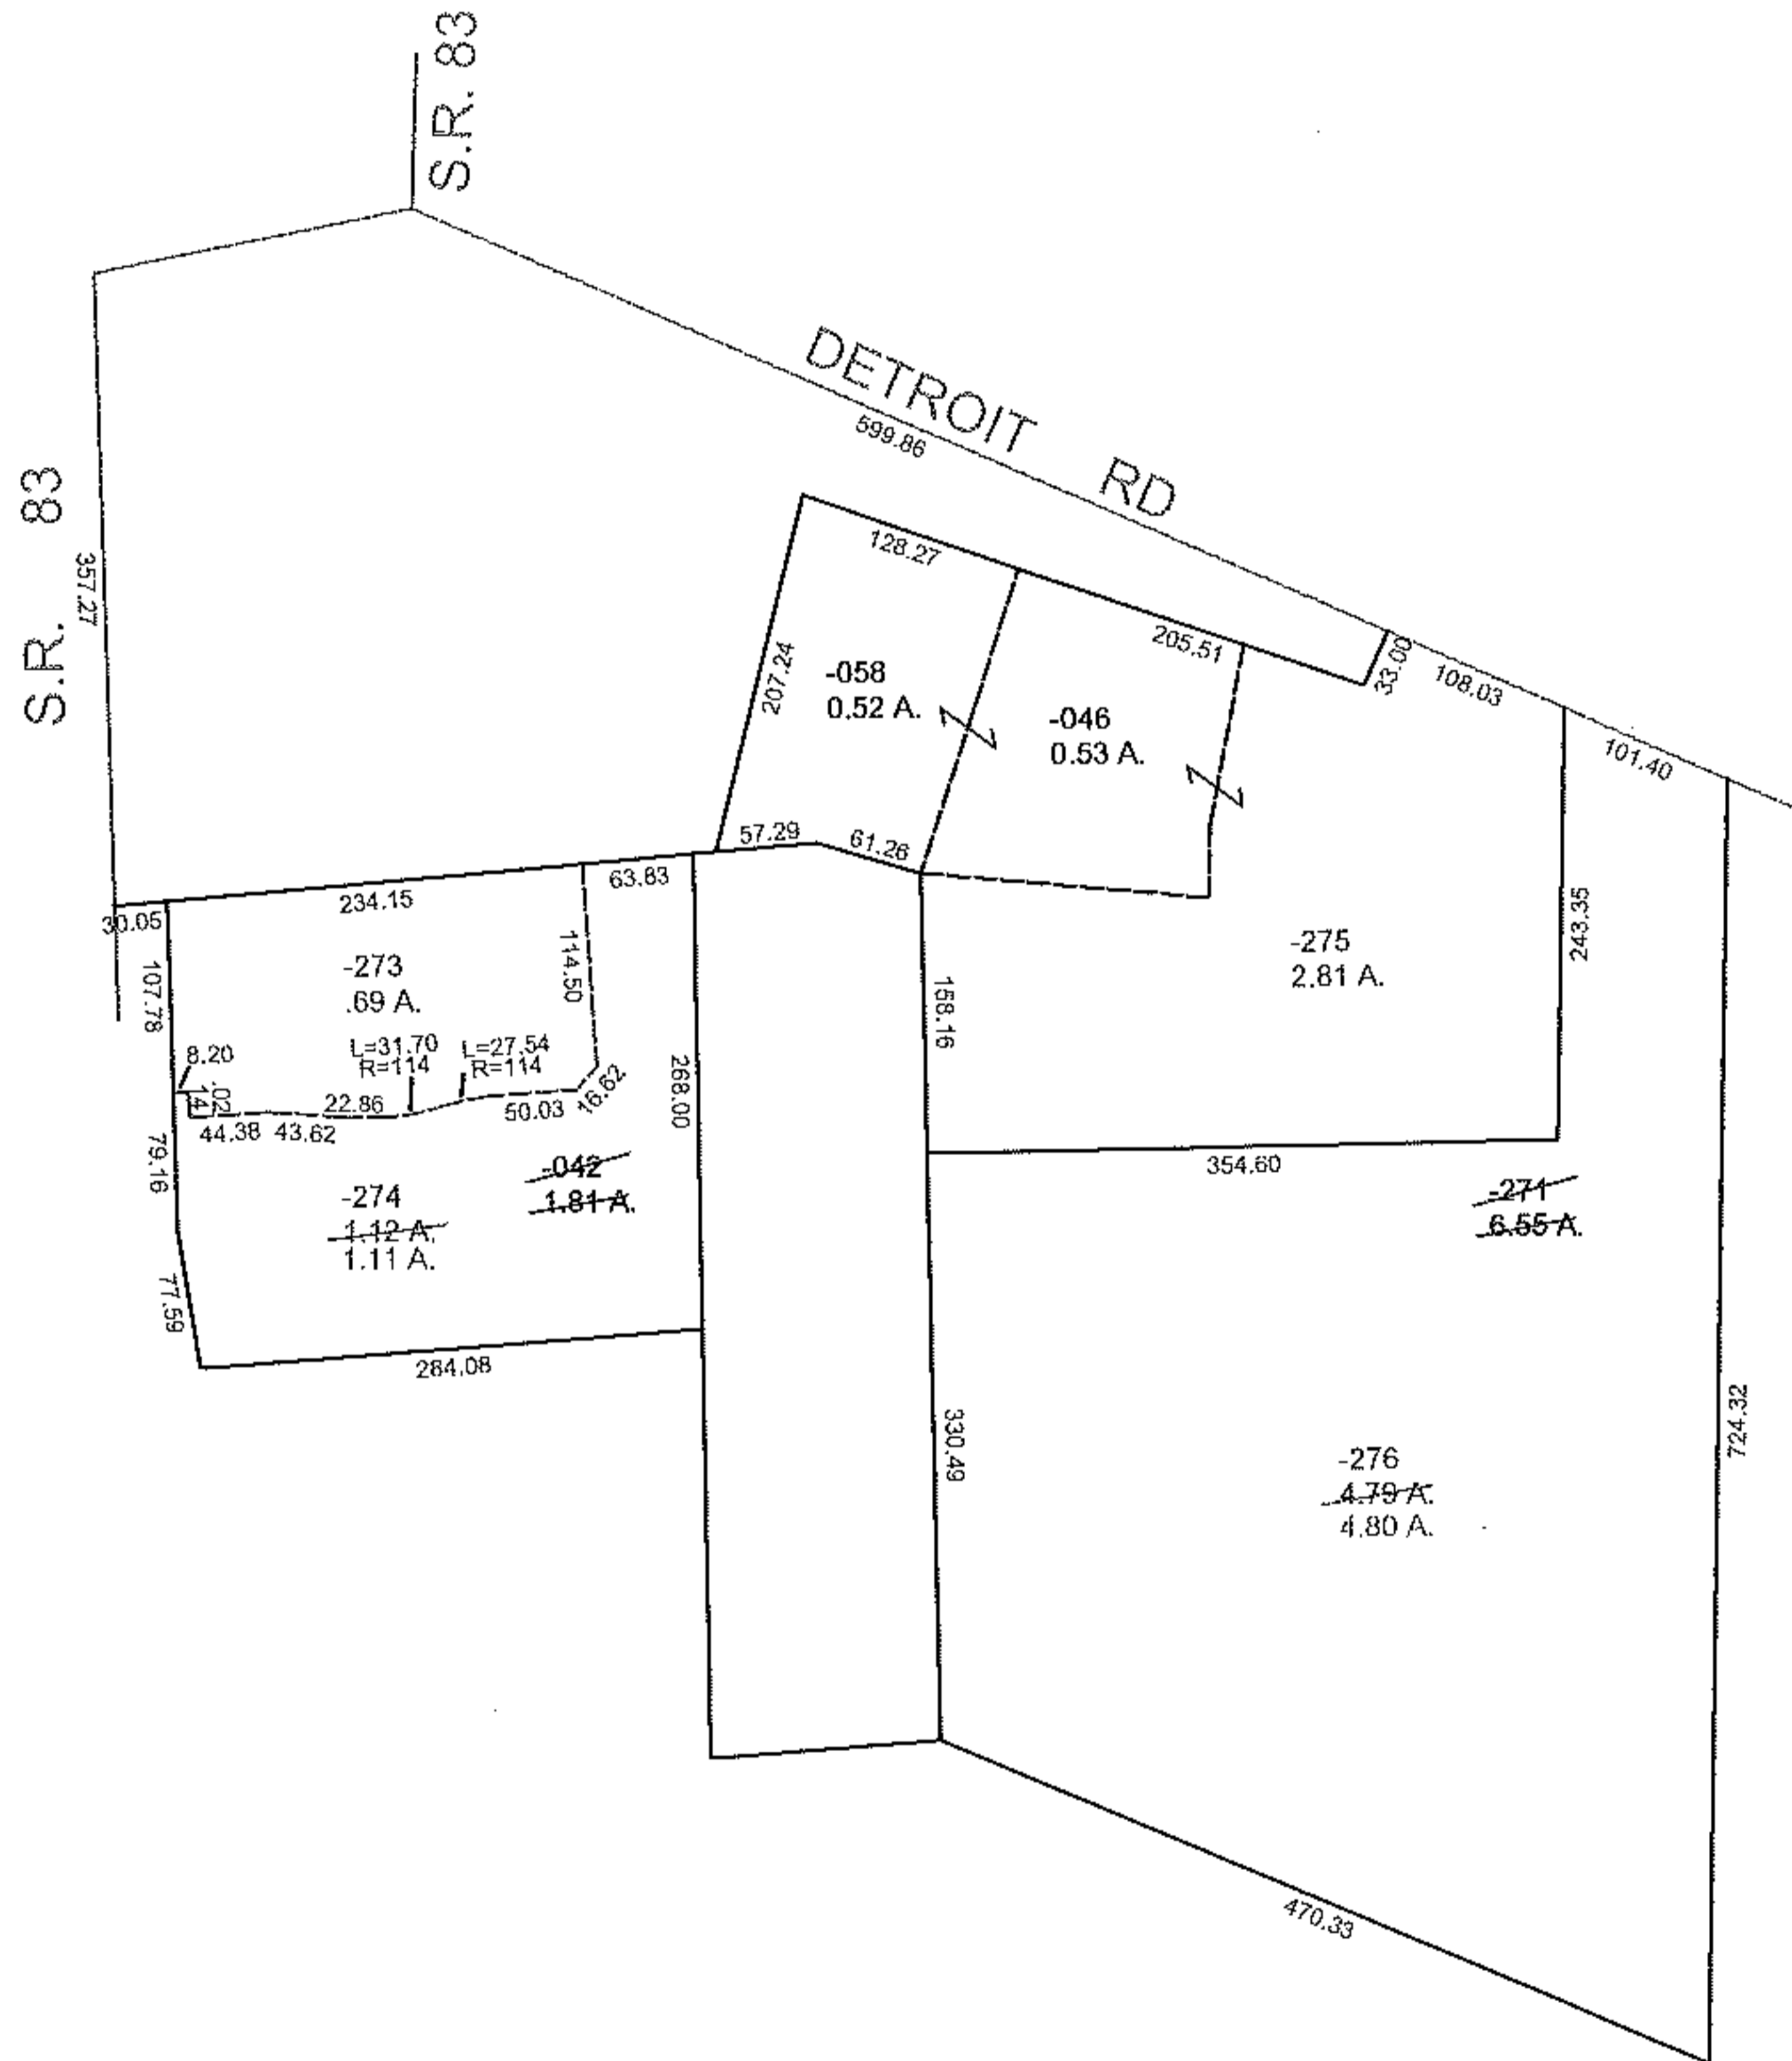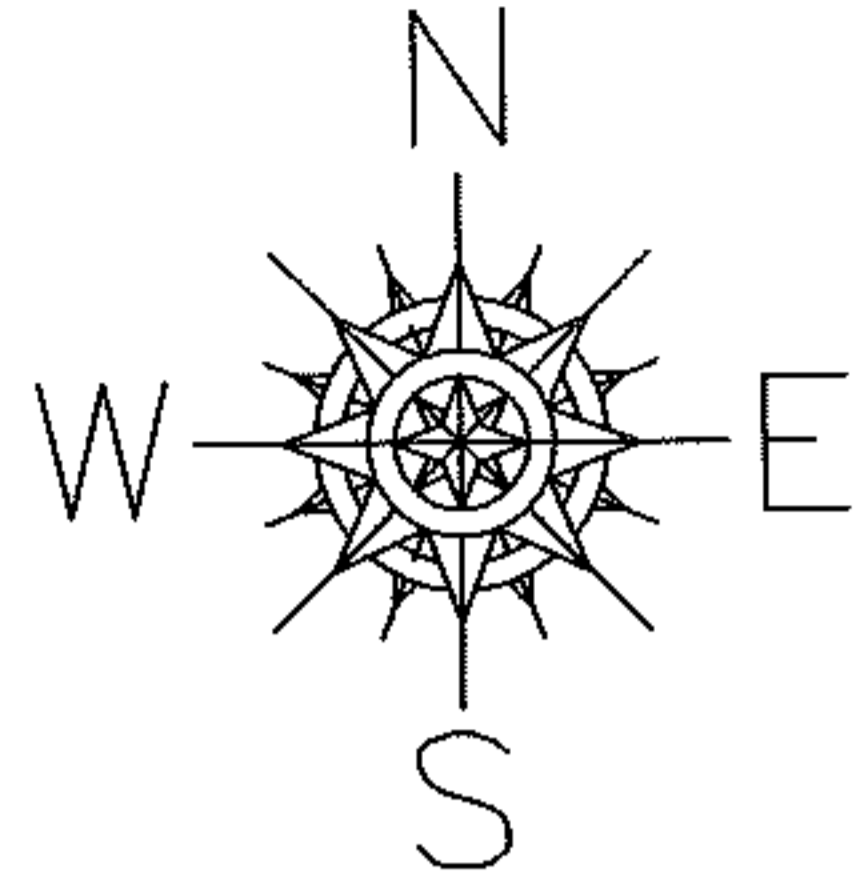

PRIOR INST.: 20080268241
PRIOR INST.: 20090293411

SPLITS/DEEDS PROCESSED

LORAIN COUNTY TAX MAP DEPARTMENT
226 MIDDLE AVE. ELYRIA, OHIO

SURVEYED BY: TREVOR BIXLER

CLOSURE: 1:10,000

MAP PAGE(S): 04-00-015-C

APPROVED BY: DRH DATE: 7/14/2009

SCALE: 1"=200

