


PARENT PARCEL: 10-00-015-109-009

CHILD PARCEL: \_\_\_\_\_


13-02722-A

STARTING POINT: INTERSECTION OF SOUTH LINE OF LAKEVIEW DR. AND EAST LINE OF EDGEWOOD DR.

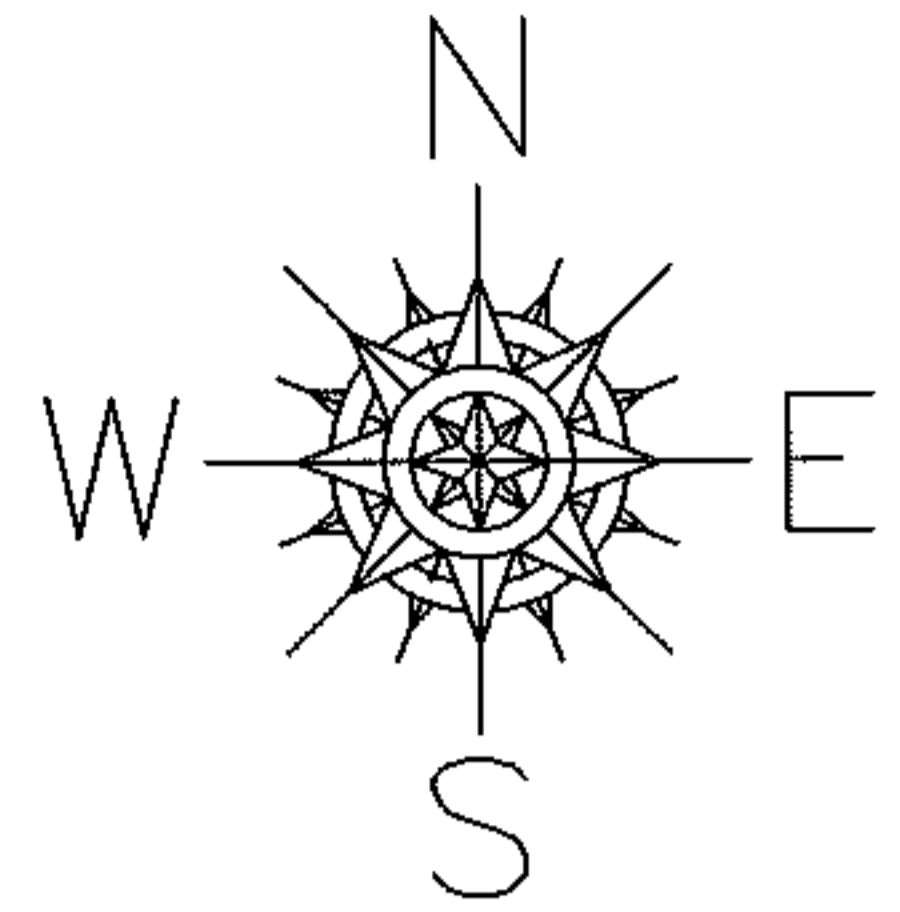


LAKEVIEW DR.

EDGEWOOD DR.

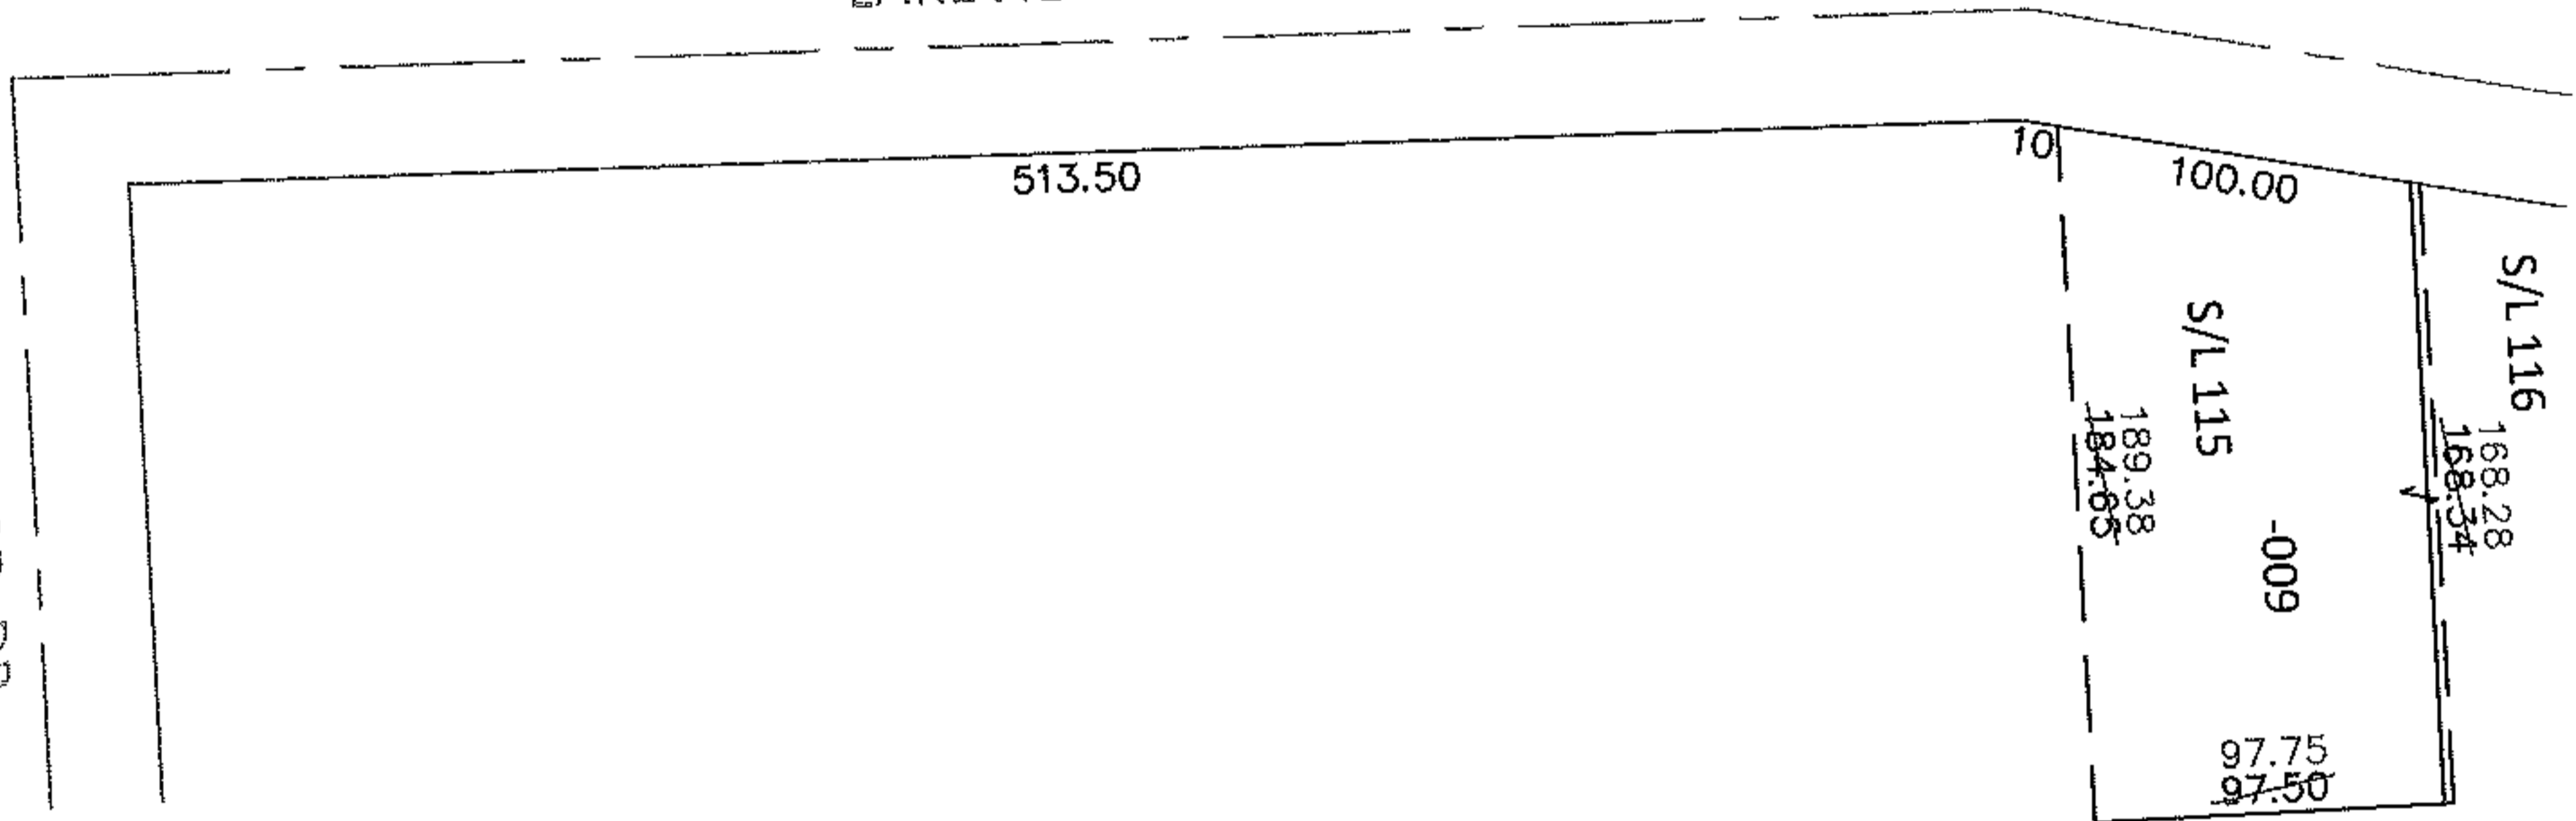

DEPTH CORRECTION

10-00-015-109-009  
100 X 189.38  
~~100 X 184.65~~  
PER. SURV. D.HAYWOOD

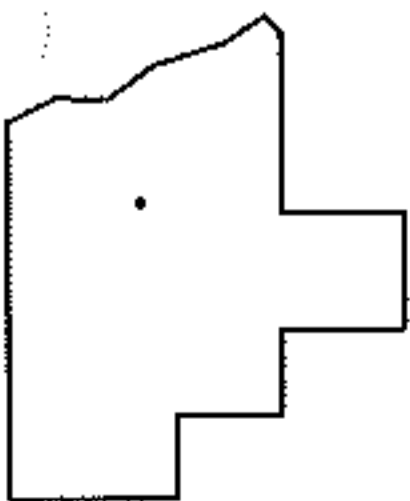

SPLITS/DEEDS PROCESSED

LORAIN COUNTY TAX MAP DEPARTMENT  
226 MIDDLE AVE. ELYRIA, OHIO

SURVEYED BY: DALE R. HAYWOOD

CLOSURE: .01:10,000

MAP PAGE(S): 10-00-015-C

APPROVED BY: RRM DATE: 5-7-13

SCALE: 1"= 100 PRIOR INST.: 20130446632