
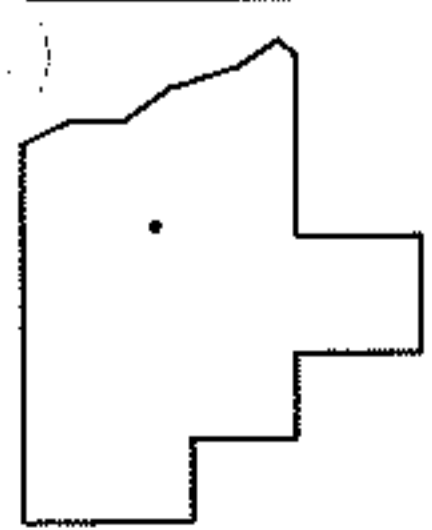
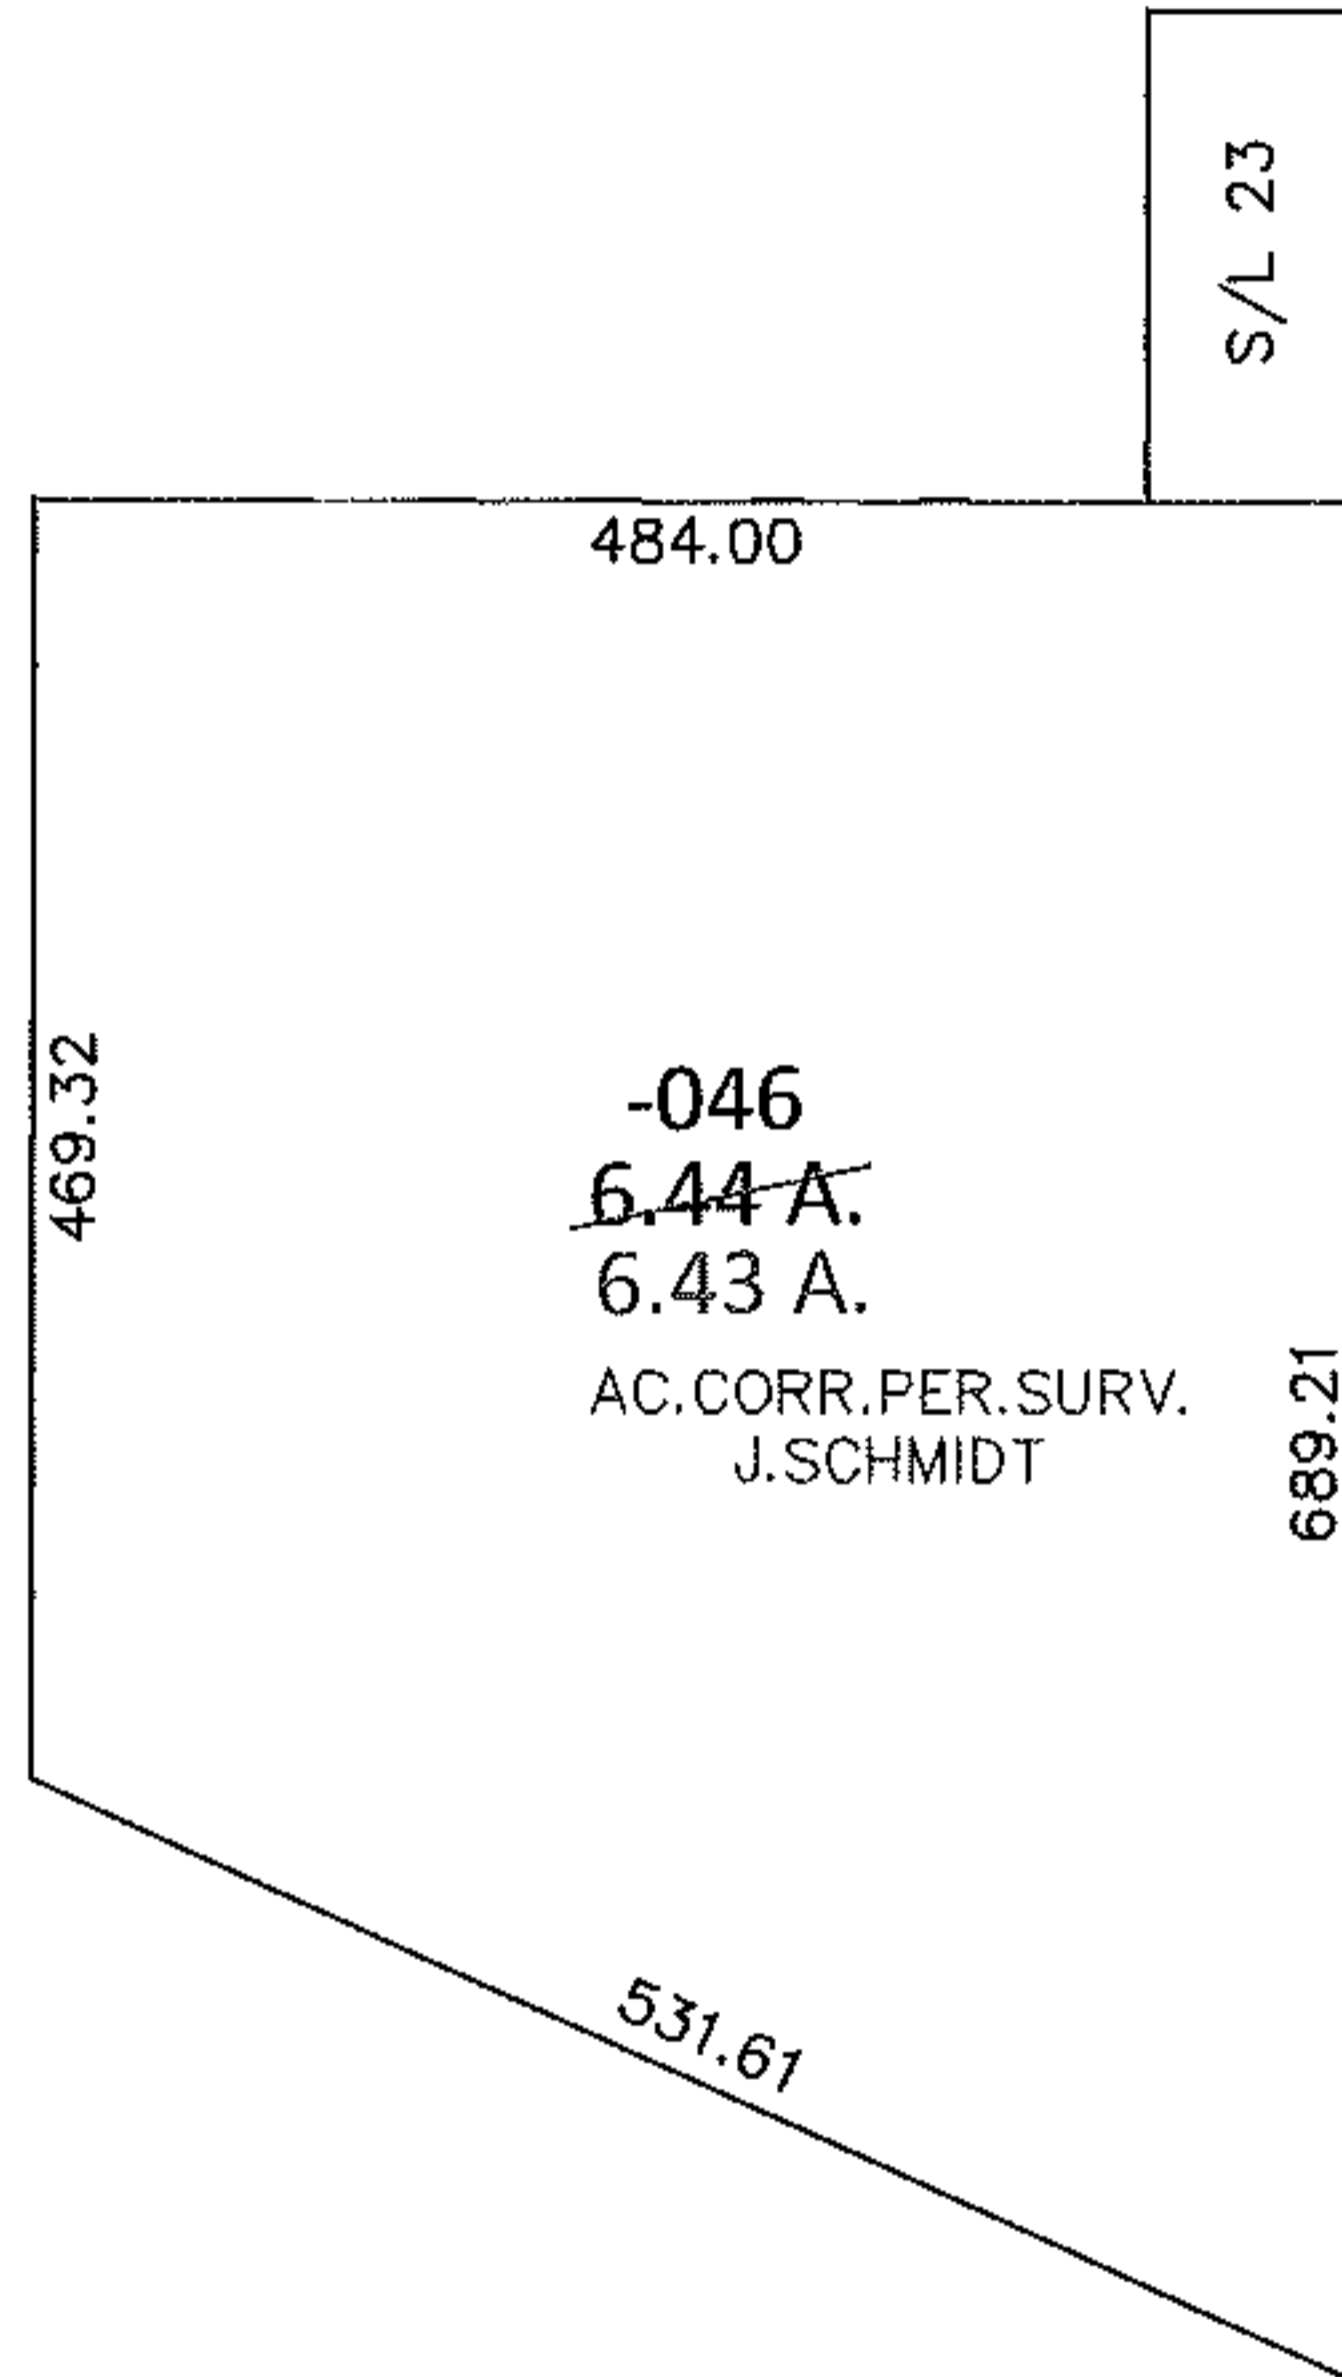


PARENT PARCEL: 07-00-008-117-046

CHILD PARCEL: _____

13-02724-A

STARTING POINT: SOUTHEAST CORNER OF S/L 23 IN MEADOW RIDGE ALLOT. NO.2 (VOL.25 PG.8)

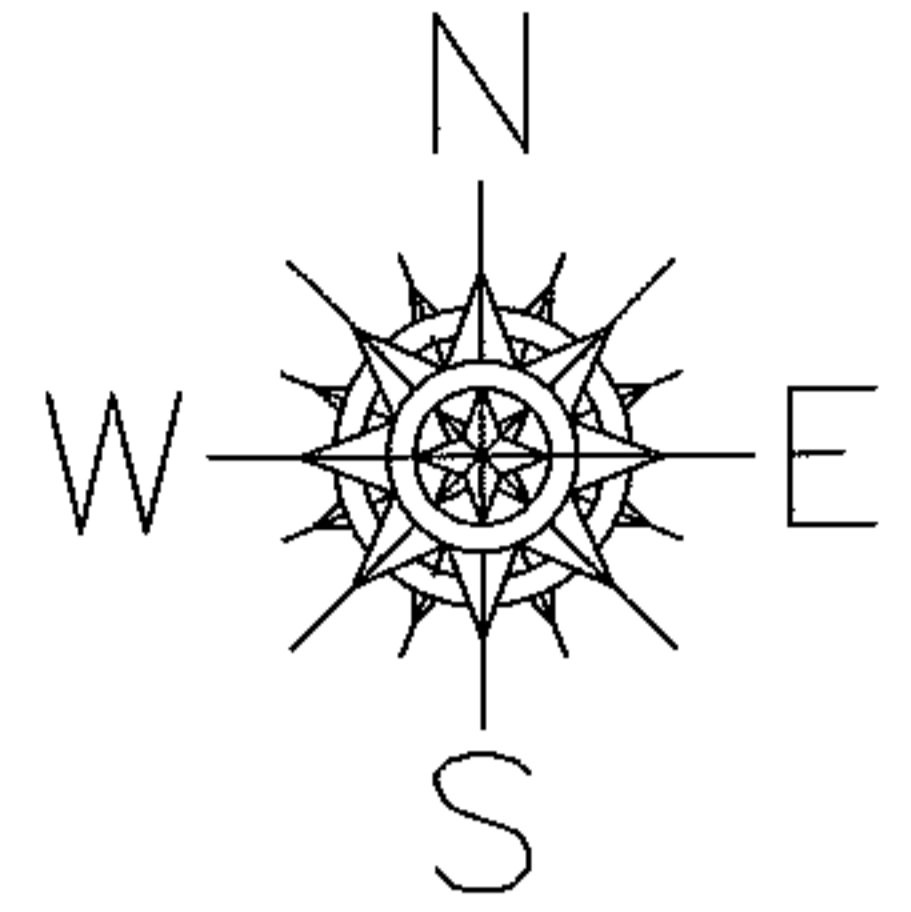

SPLITS/DEEDS PROCESSED

LORAIN COUNTY TAX MAP DEPARTMENT
226 MIDDLE AVE. ELYRIA, OHIO

SURVEYED BY: JAMES H. SCHMIDT
 CLOSURE: .01:10,000
 MAP PAGE(S): 7-00-008-C
 APPROVED BY: RRM DATE: 5-7-13
 SCALE: 1"= 200 PRIOR INST.: 20120417648