
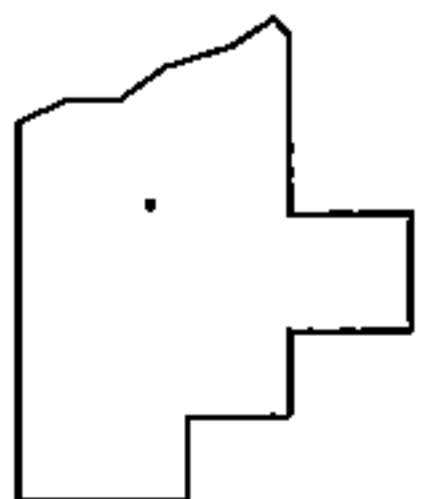
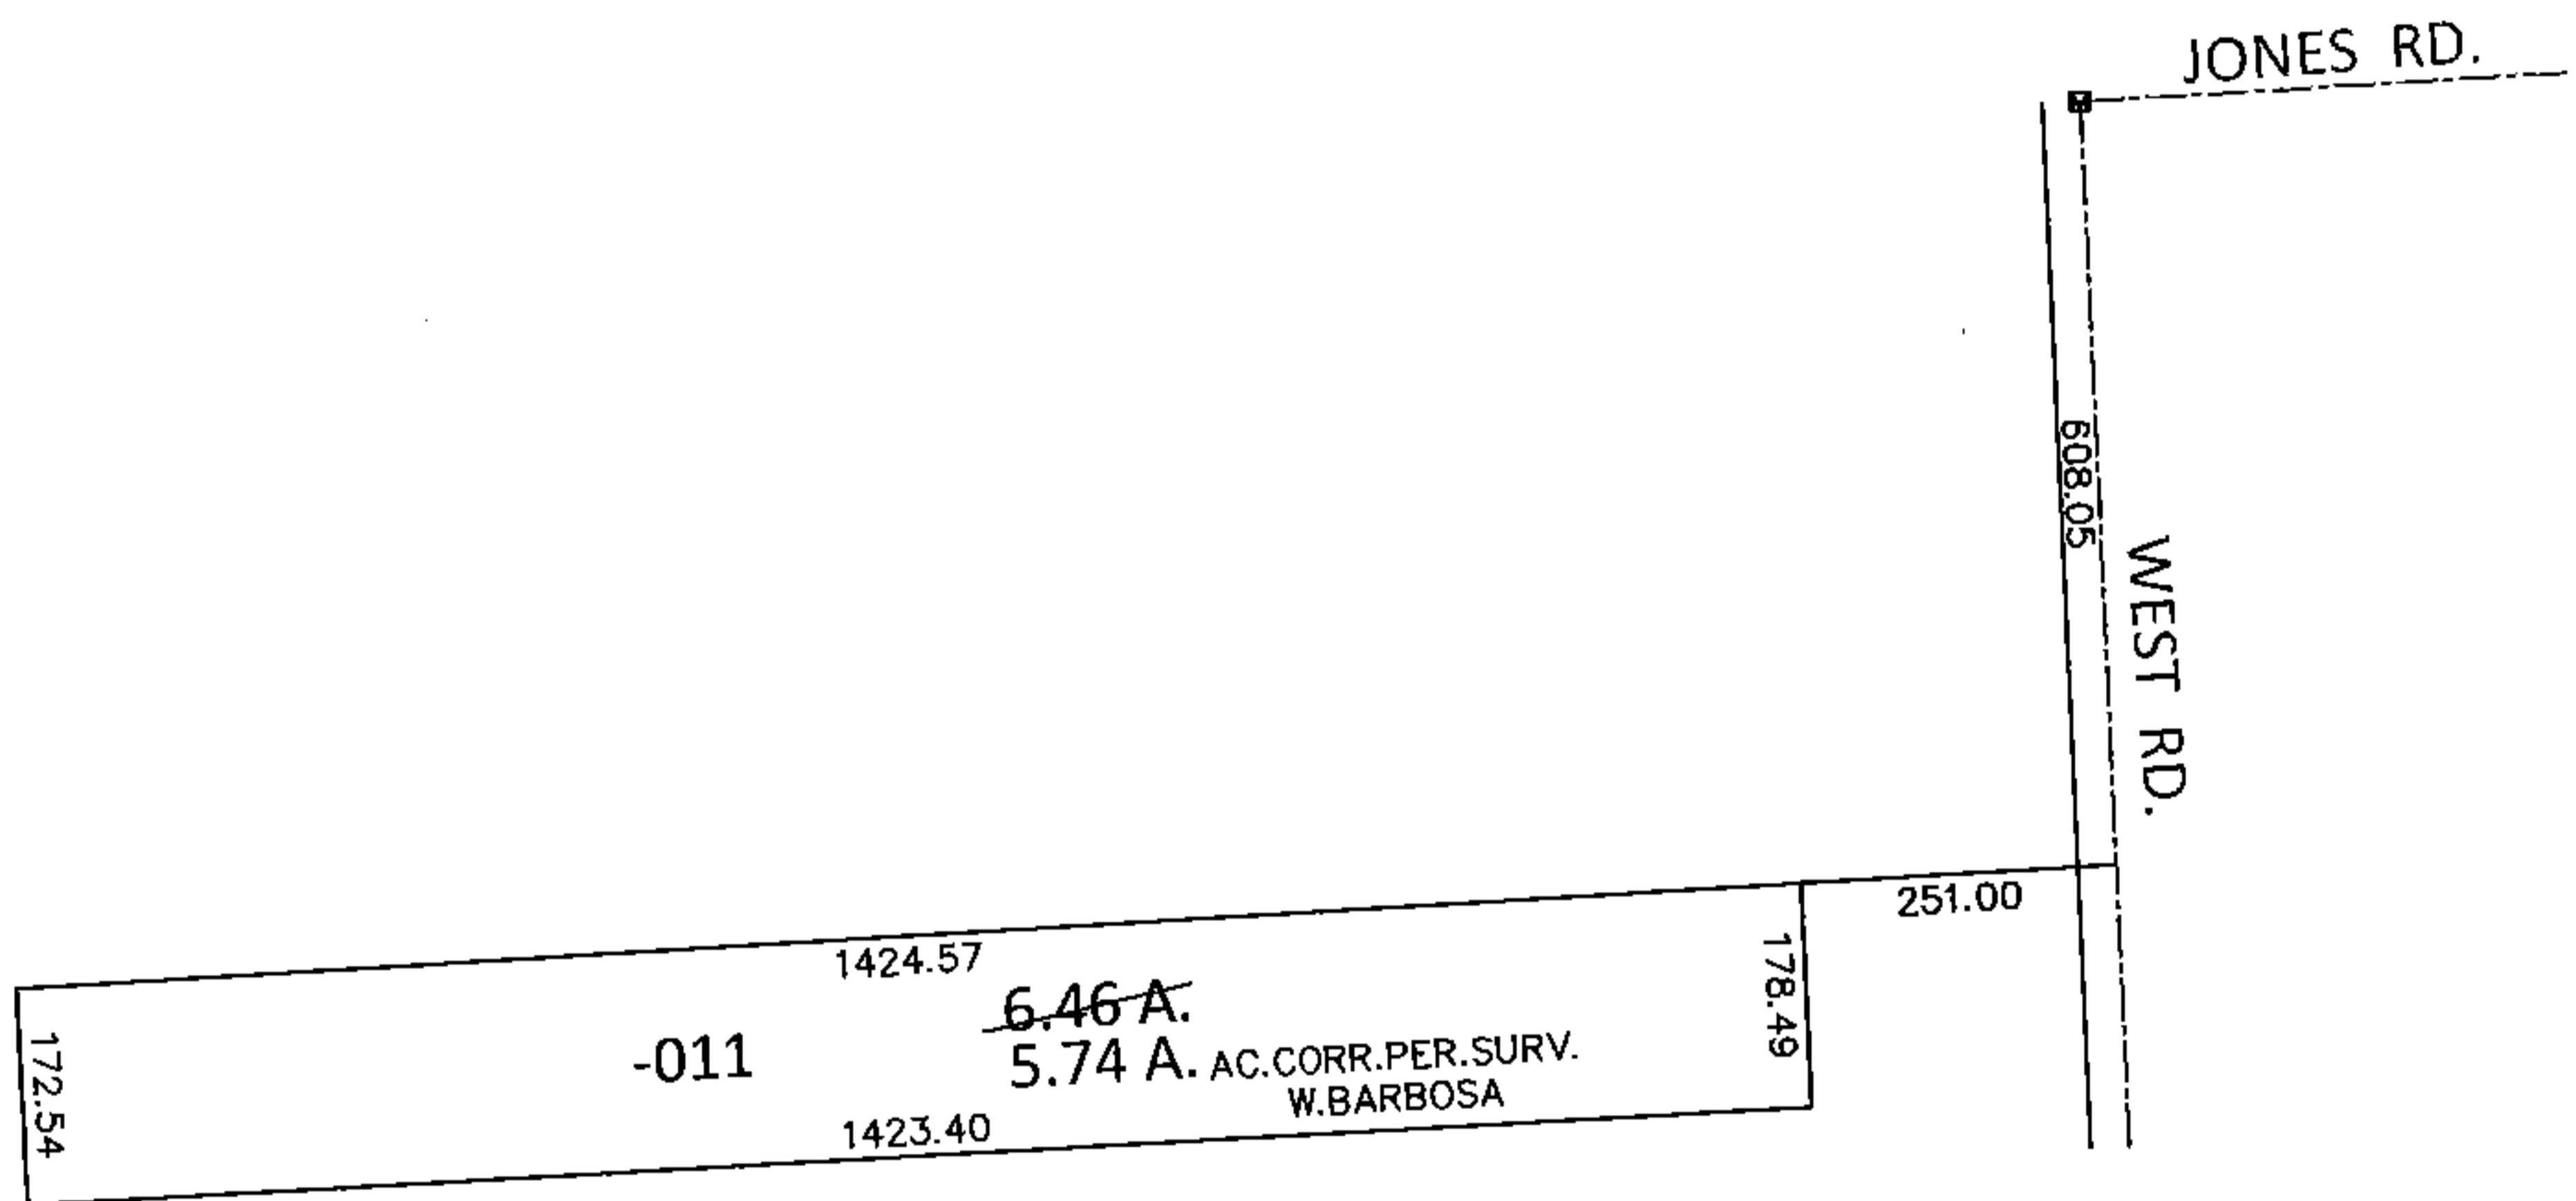


PARENT PARCEL: 18-00-002-000-011

CHILD PARCEL: _____

STARTING POINT: AT A MON BOX AT THE INTERSECTION OF C/L OF WEST RD. AND C/L OF JONES RD.

13-02726-A

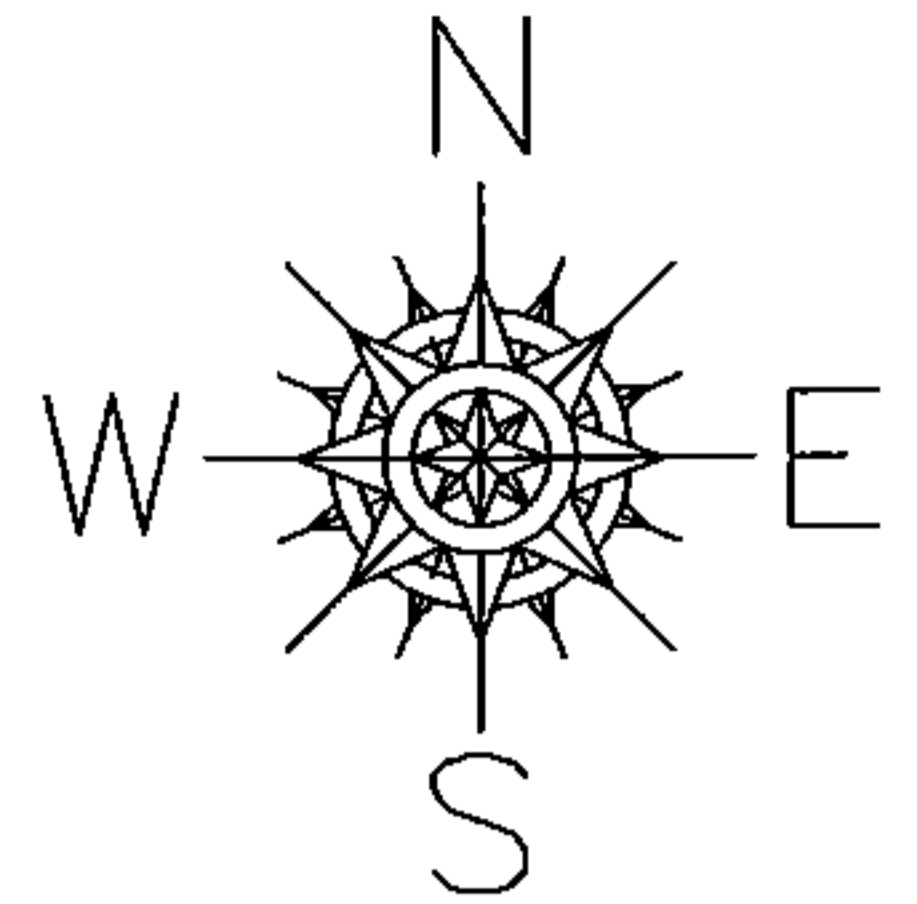

SPLITS/DEEDS PROCESSED

LORAIN COUNTY TAX MAP DEPARTMENT
226 MIDDLE AVE. ELYRIA, OHIO

SURVEYED BY: WILFREDO BARBOSA

CLOSURE: .01:10,000

MAP PAGE(S): 18-H

APPROVED BY: RRM DATE: 5-9-13

SCALE: 1"= 300 PRIOR INST.: N/A