

PARENT PARCEL: 09-00-084-101-028

CHILD PARCEL: 09-00-084-101-097 & -098

STARTING POINT: XXXXXX

13-02727-U

UNCOMBINATION

~~09-00-084-101-028~~

~~93 X 480~~



09-00-084-101-097

60 X 480

&

09-00-084-101-098

33 X 480

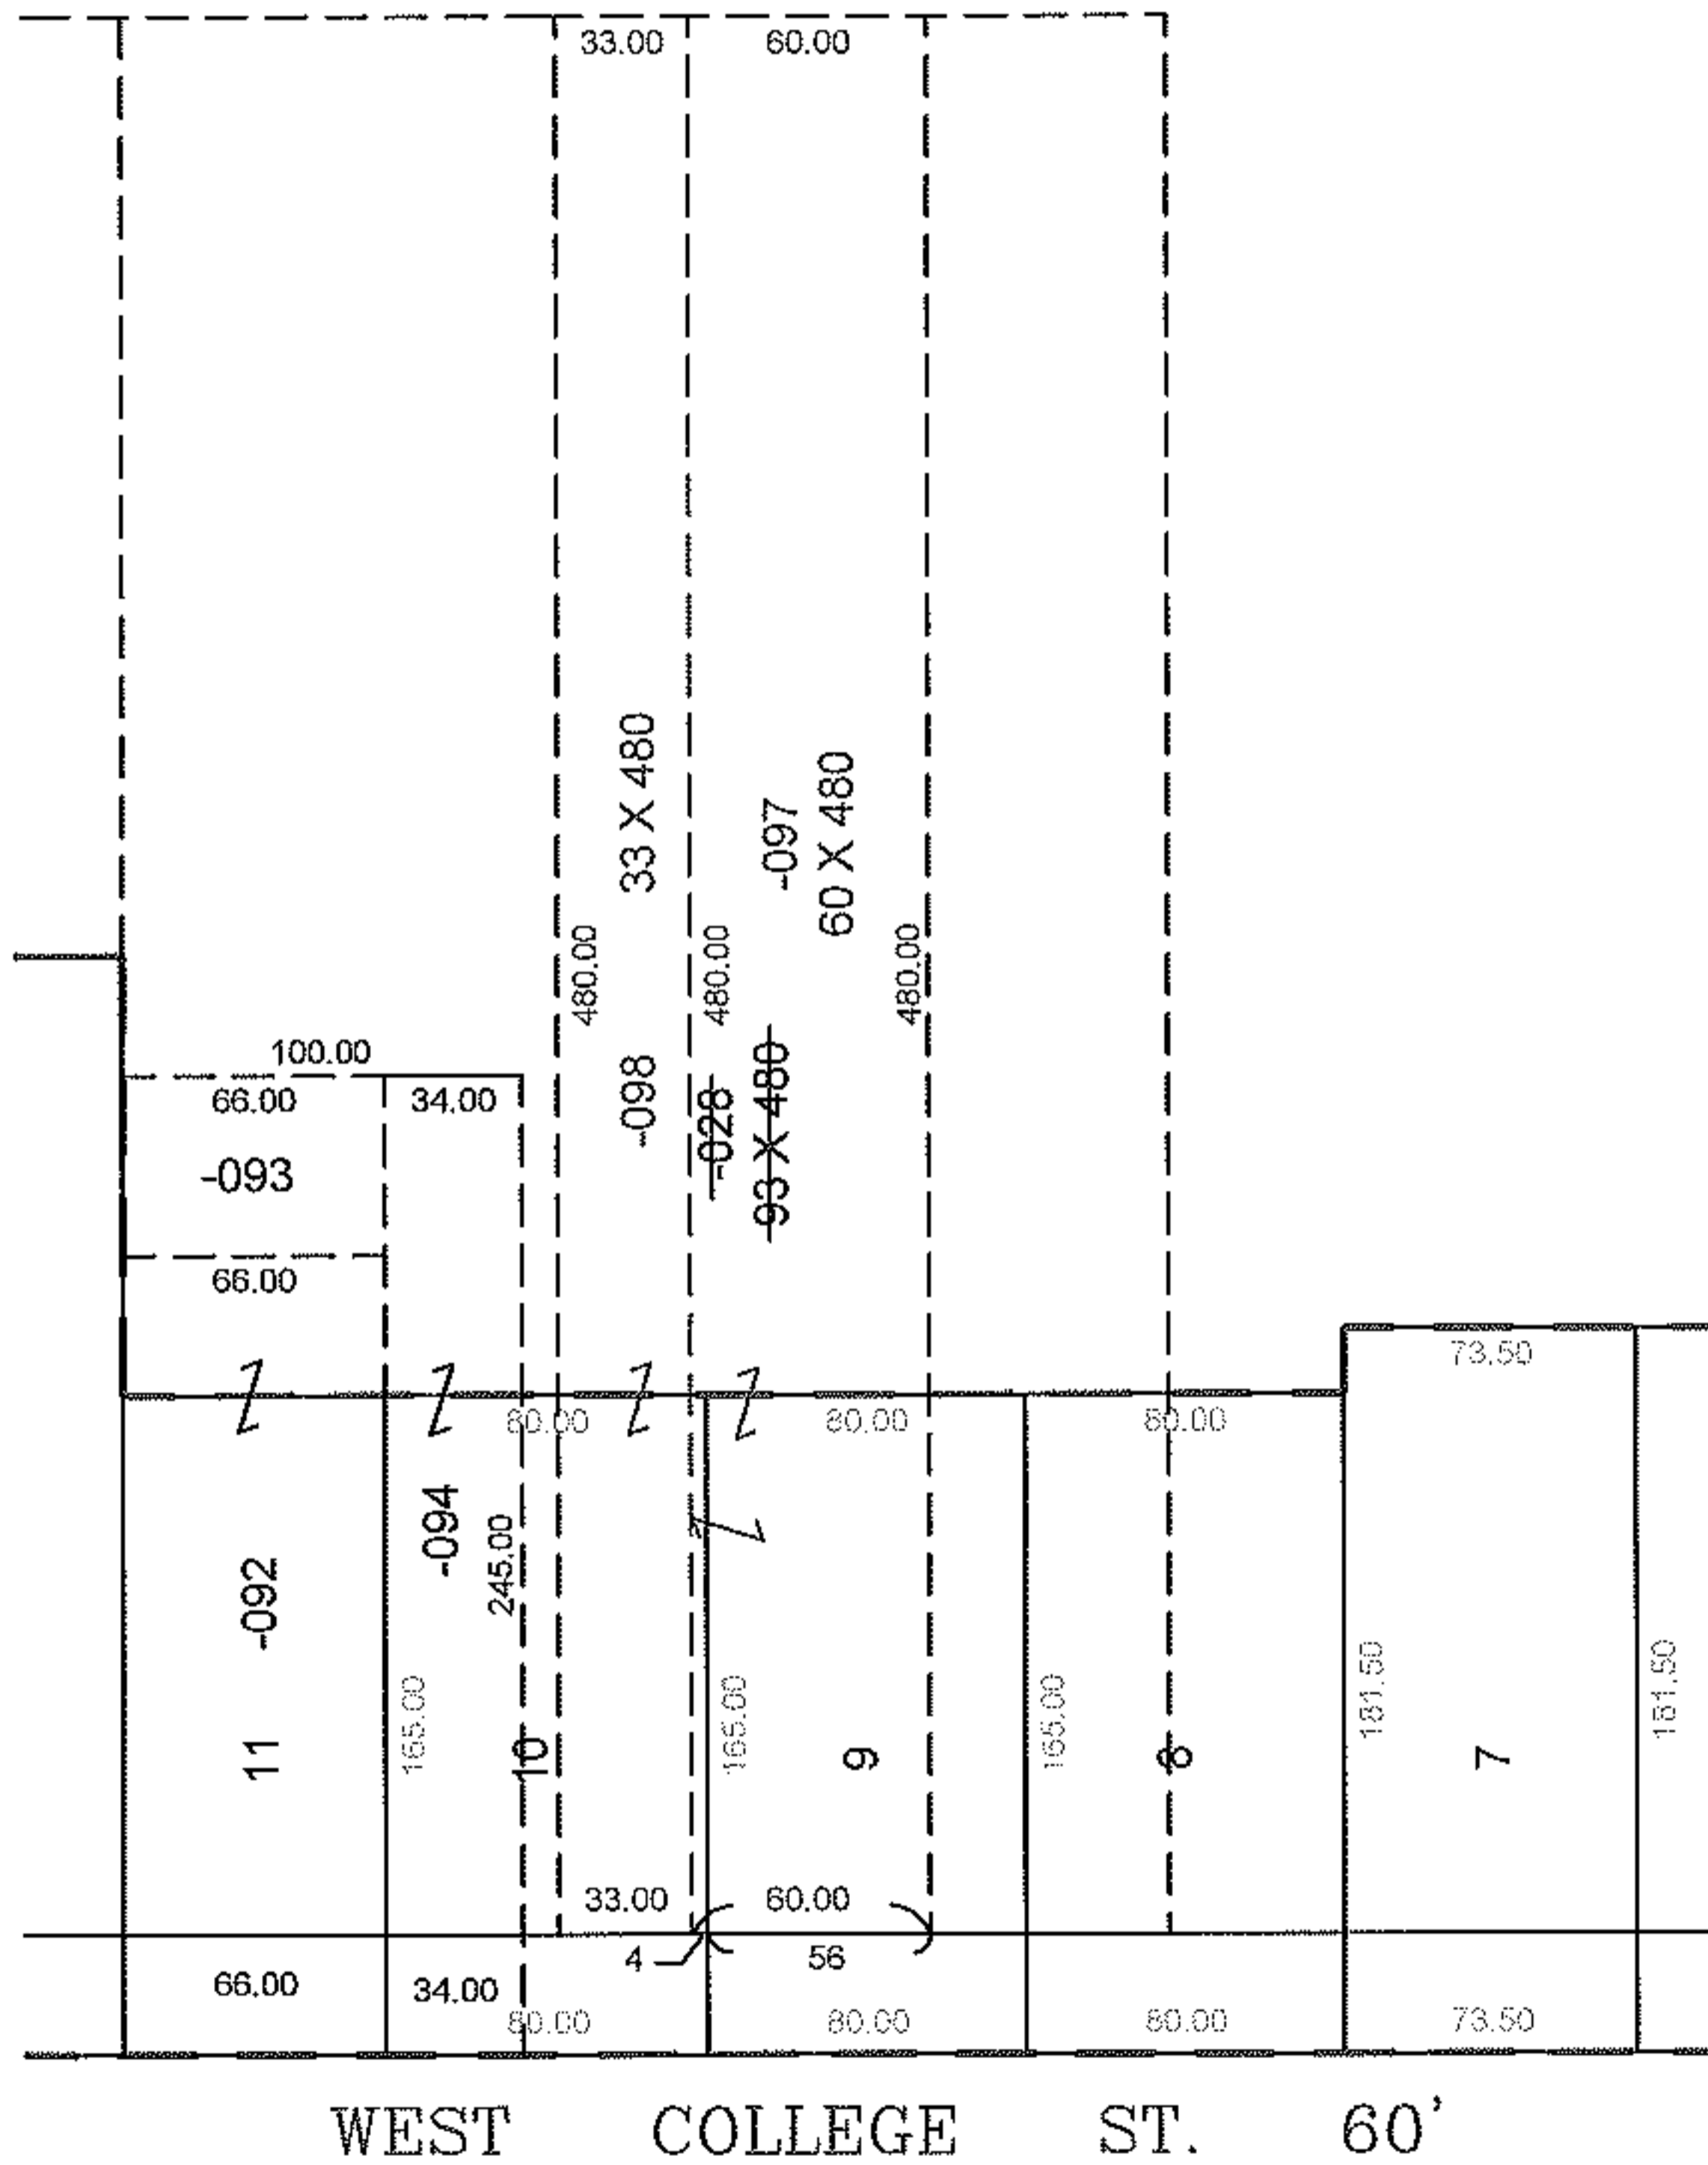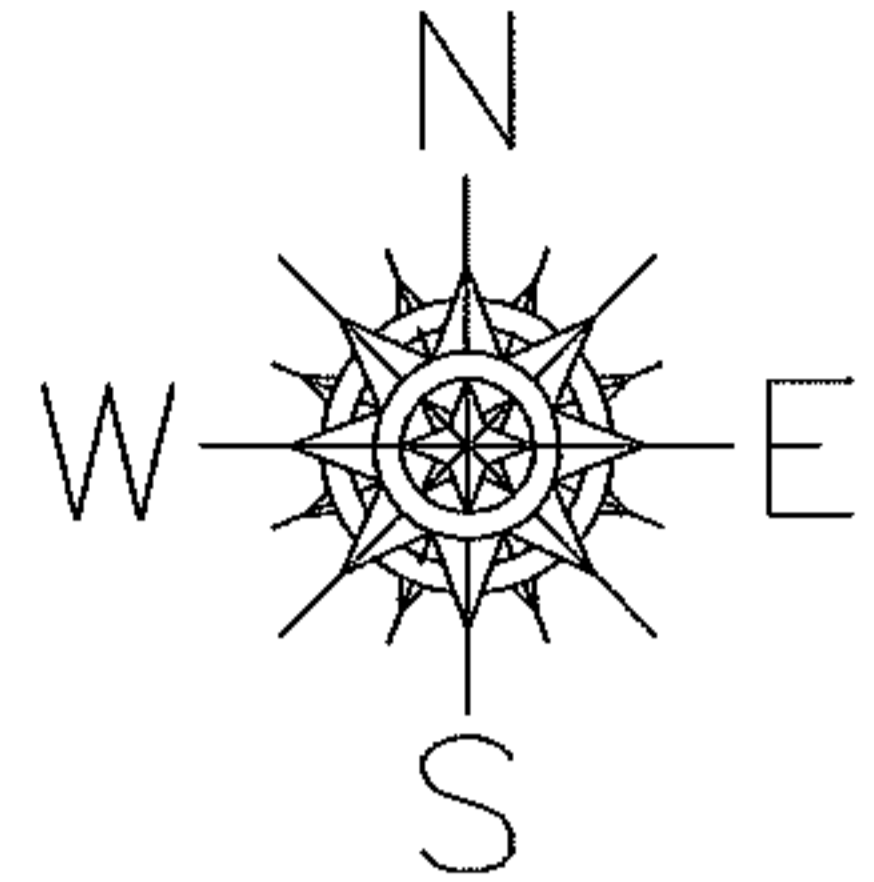

SPLITS/DEEDS PROCESSED

LORAIN COUNTY TAX MAP DEPARTMENT
226 MIDDLE AVE. ELYRIA, OHIO

SURVEYED BY: NONE

CLOSURE: NONE

MAP PAGE(S): 9-00-084-B

APPROVED BY: TJS DATE: 5/9/13

SCALE: 1" = 100 PRIOR INSTRUMENT: 20130448609