



RASTER

PARENT PARCEL: 06-22-006-102-014, 024, -019, -020

CHILD PARCEL: 06-22-006-102-097 THRU -101

STARTING POINT: CENTERLINE OF FORD RD & LUCAS CT

09-02727

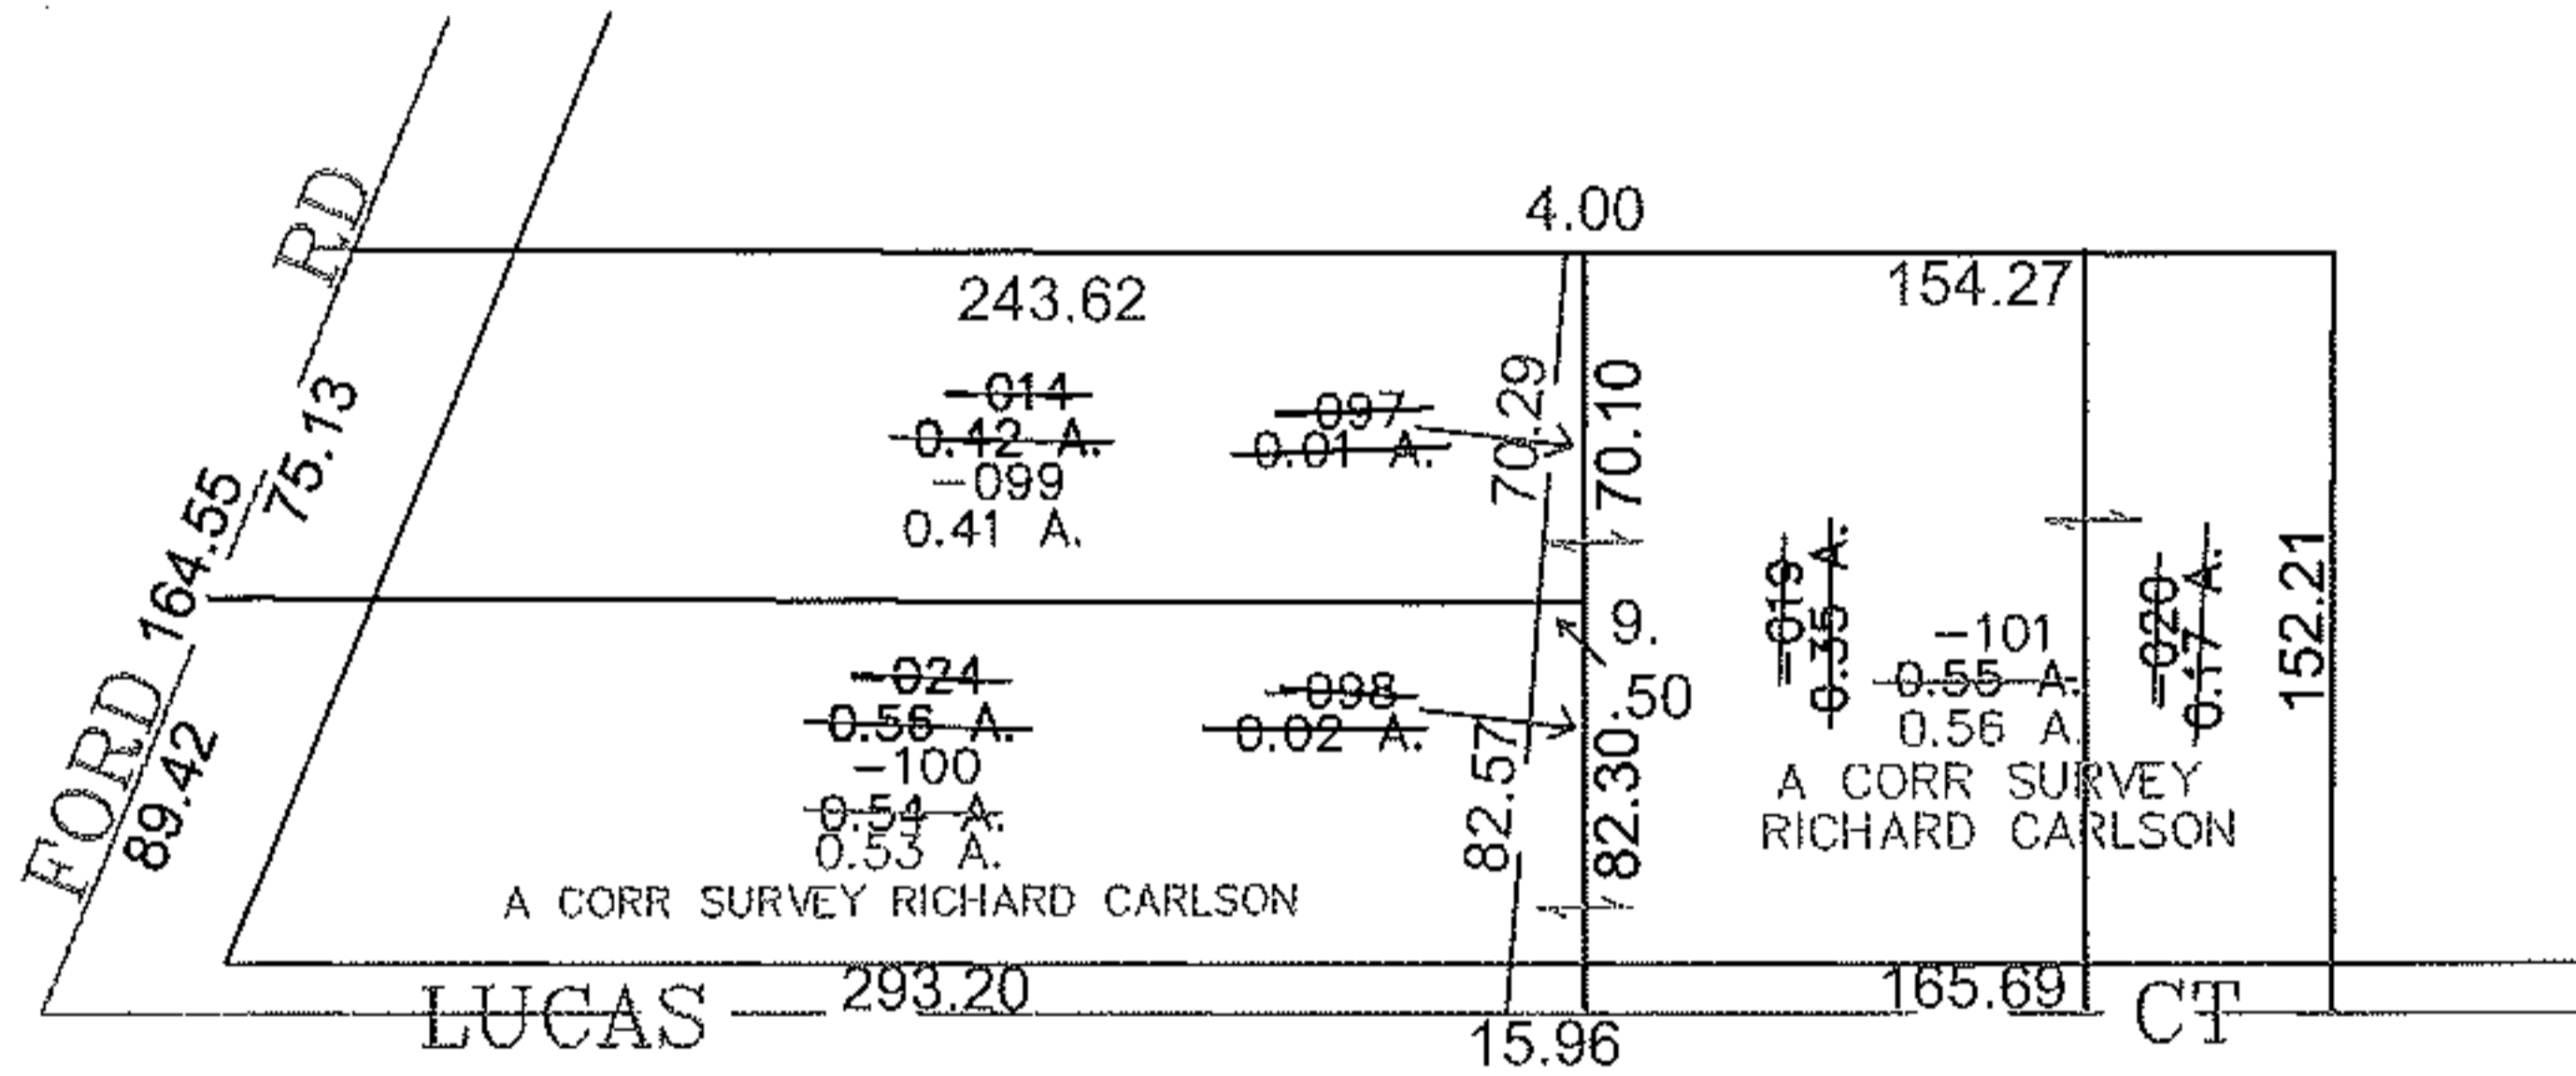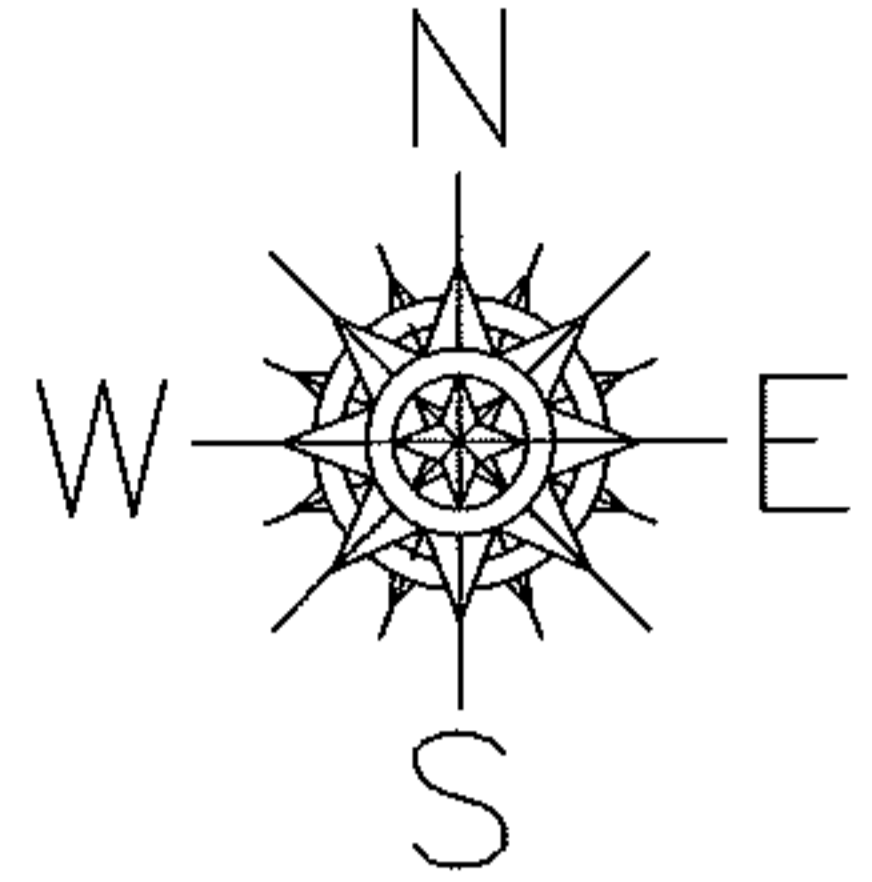

SPLITS/DEEDS PROCESSED

LORAIN COUNTY TAX MAP DEPARTMENT
226 MIDDLE AVE. ELYRIA, OHIO

SURVEYED BY: RICHARD CARLSON

CLOSURE: 0.00 : 10,000

MAP PAGE(S): 6-13

APPROVED BY: JAH DATE: 8-10-09

SCALE: 1" = 100 PRIOR INSTRUMENT: 20080251843