



RASTER

PARENT PARCEL: 12-00-001-000-042

CHILD PARCEL: 12-00-001-000-044, -045

STARTING POINT: CENTERLINE OF SPRAGUE RD & MARKS RD

09-02732

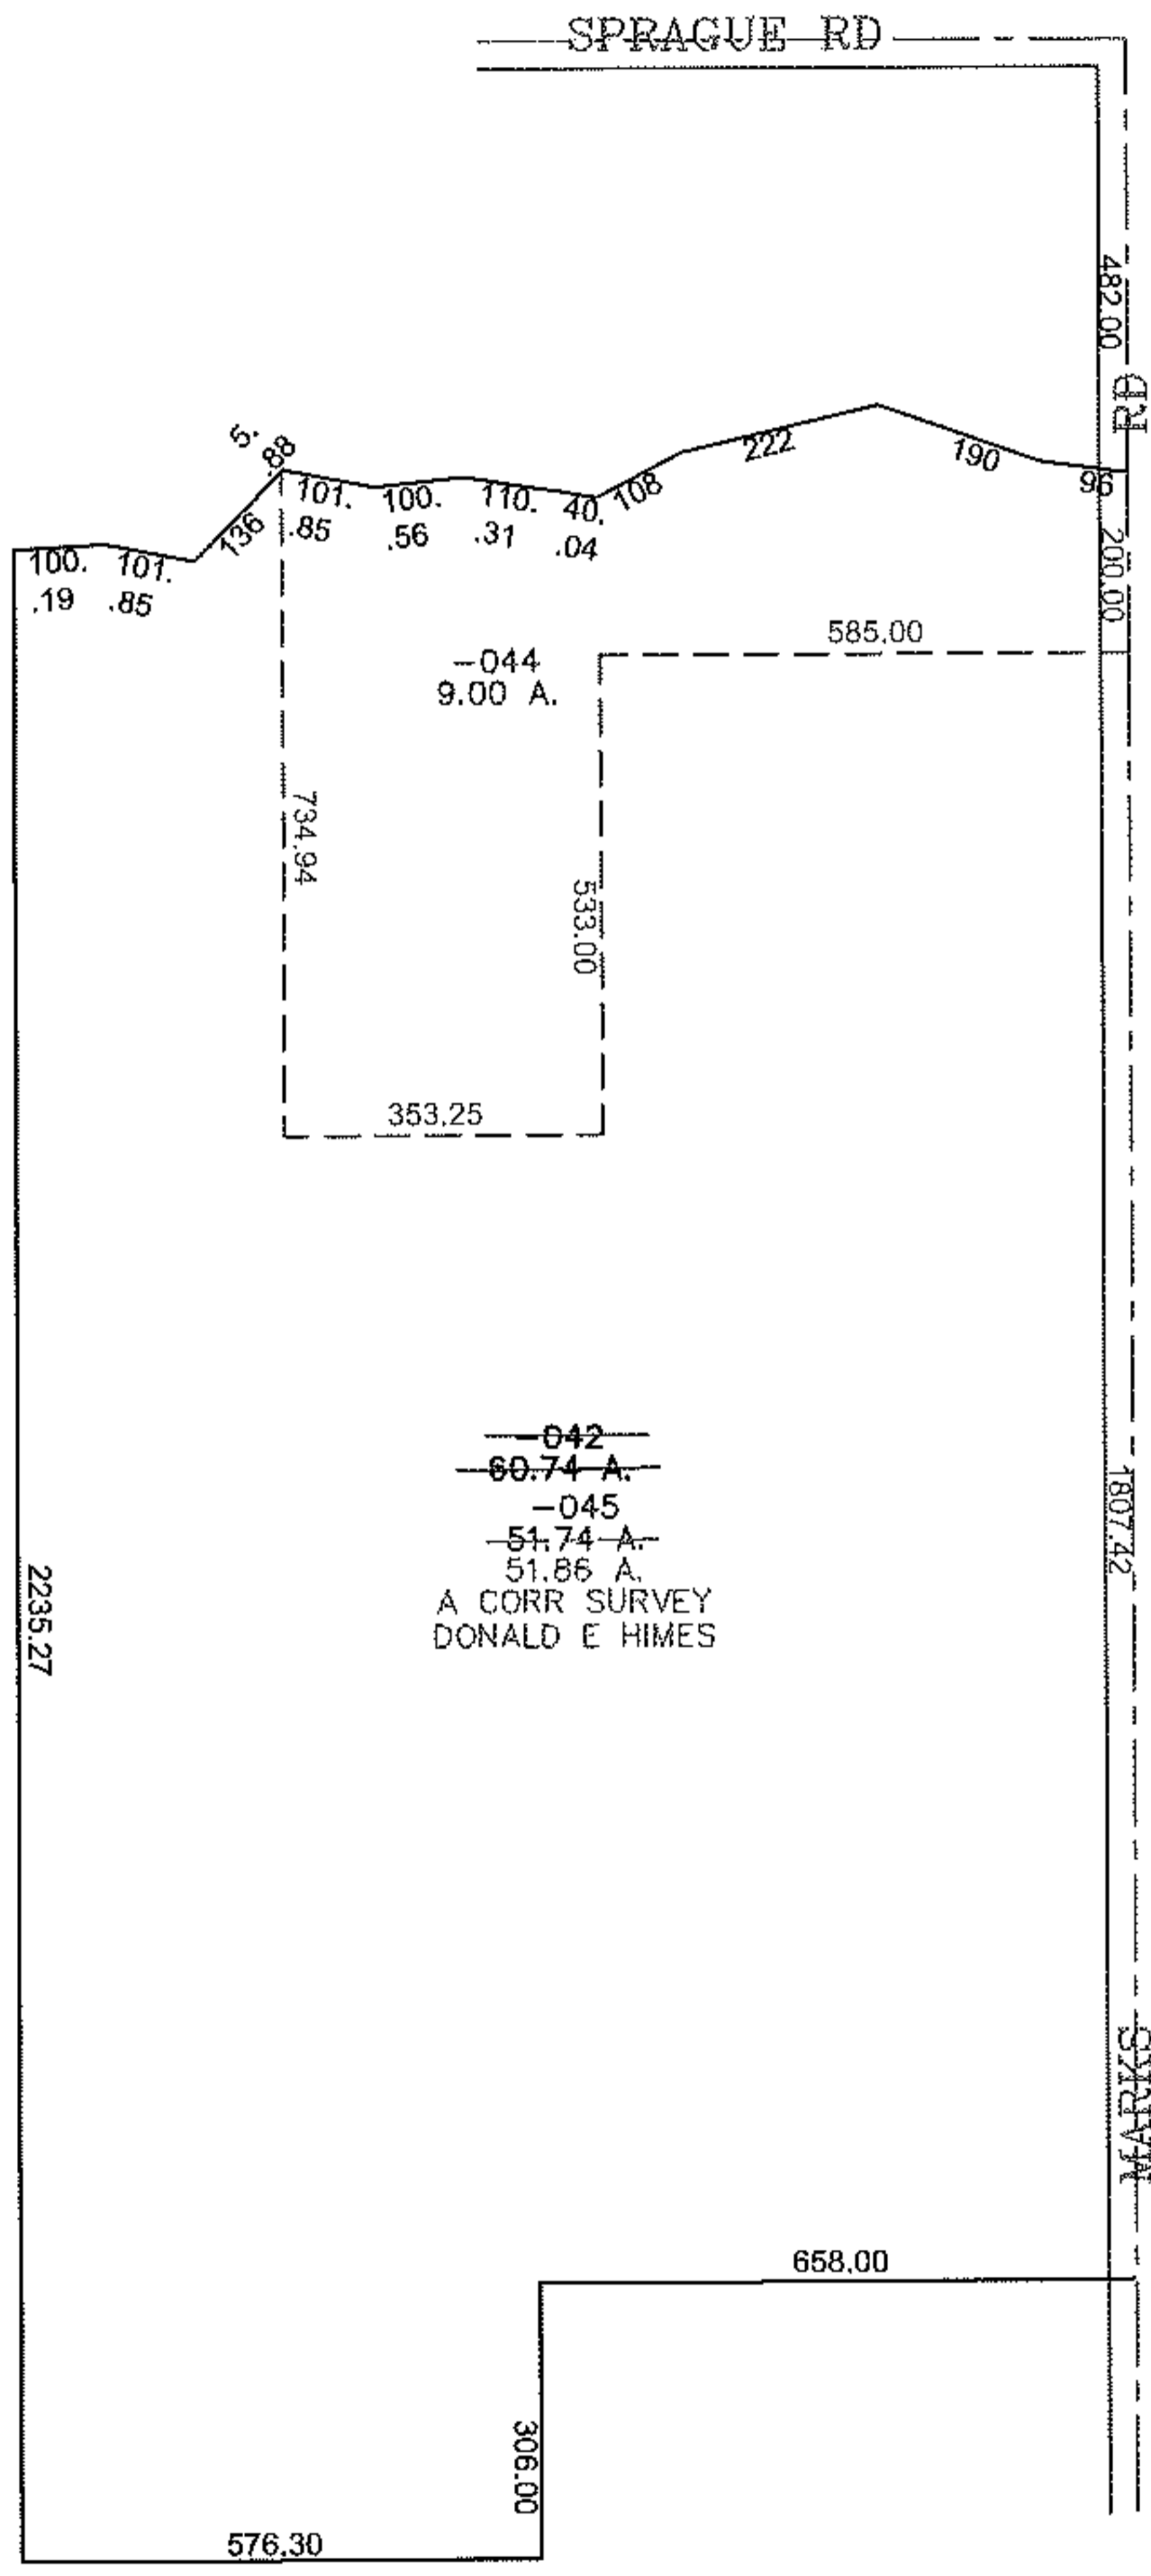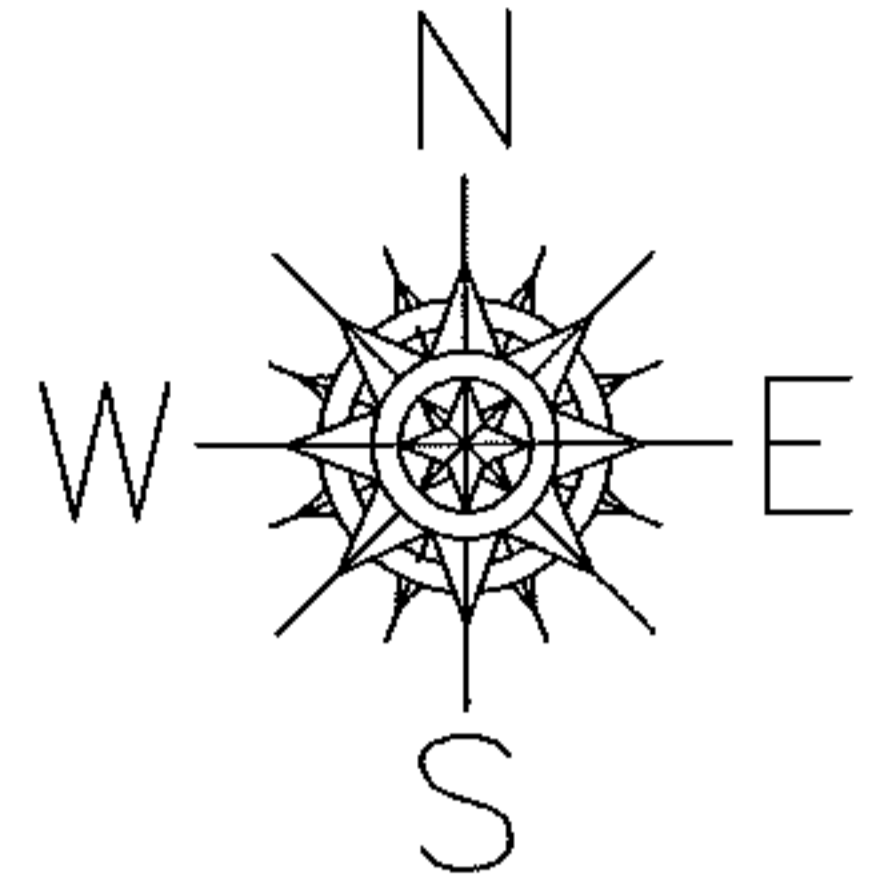

~~—042—~~
~~60.74 A.~~
~~—045—~~
~~51.74 A.~~
 51.86 A.
 A CORR SURVEY
 DONALD E HIMES

SPLITS/DEEDS PROCESSED

LORAIN COUNTY TAX MAP DEPARTMENT
226 MIDDLE AVE. ELYRIA, OHIO

SURVEYED BY: DONALD HIMES
 CLOSURE: 0.00 : 10.000
 MAP PAGE(S): 12-00-001-B
 APPROVED BY: JAH DATE: 8-18-09
 SCALE: 1" = 400 PRIOR INSTRUMENT: 20060166690