
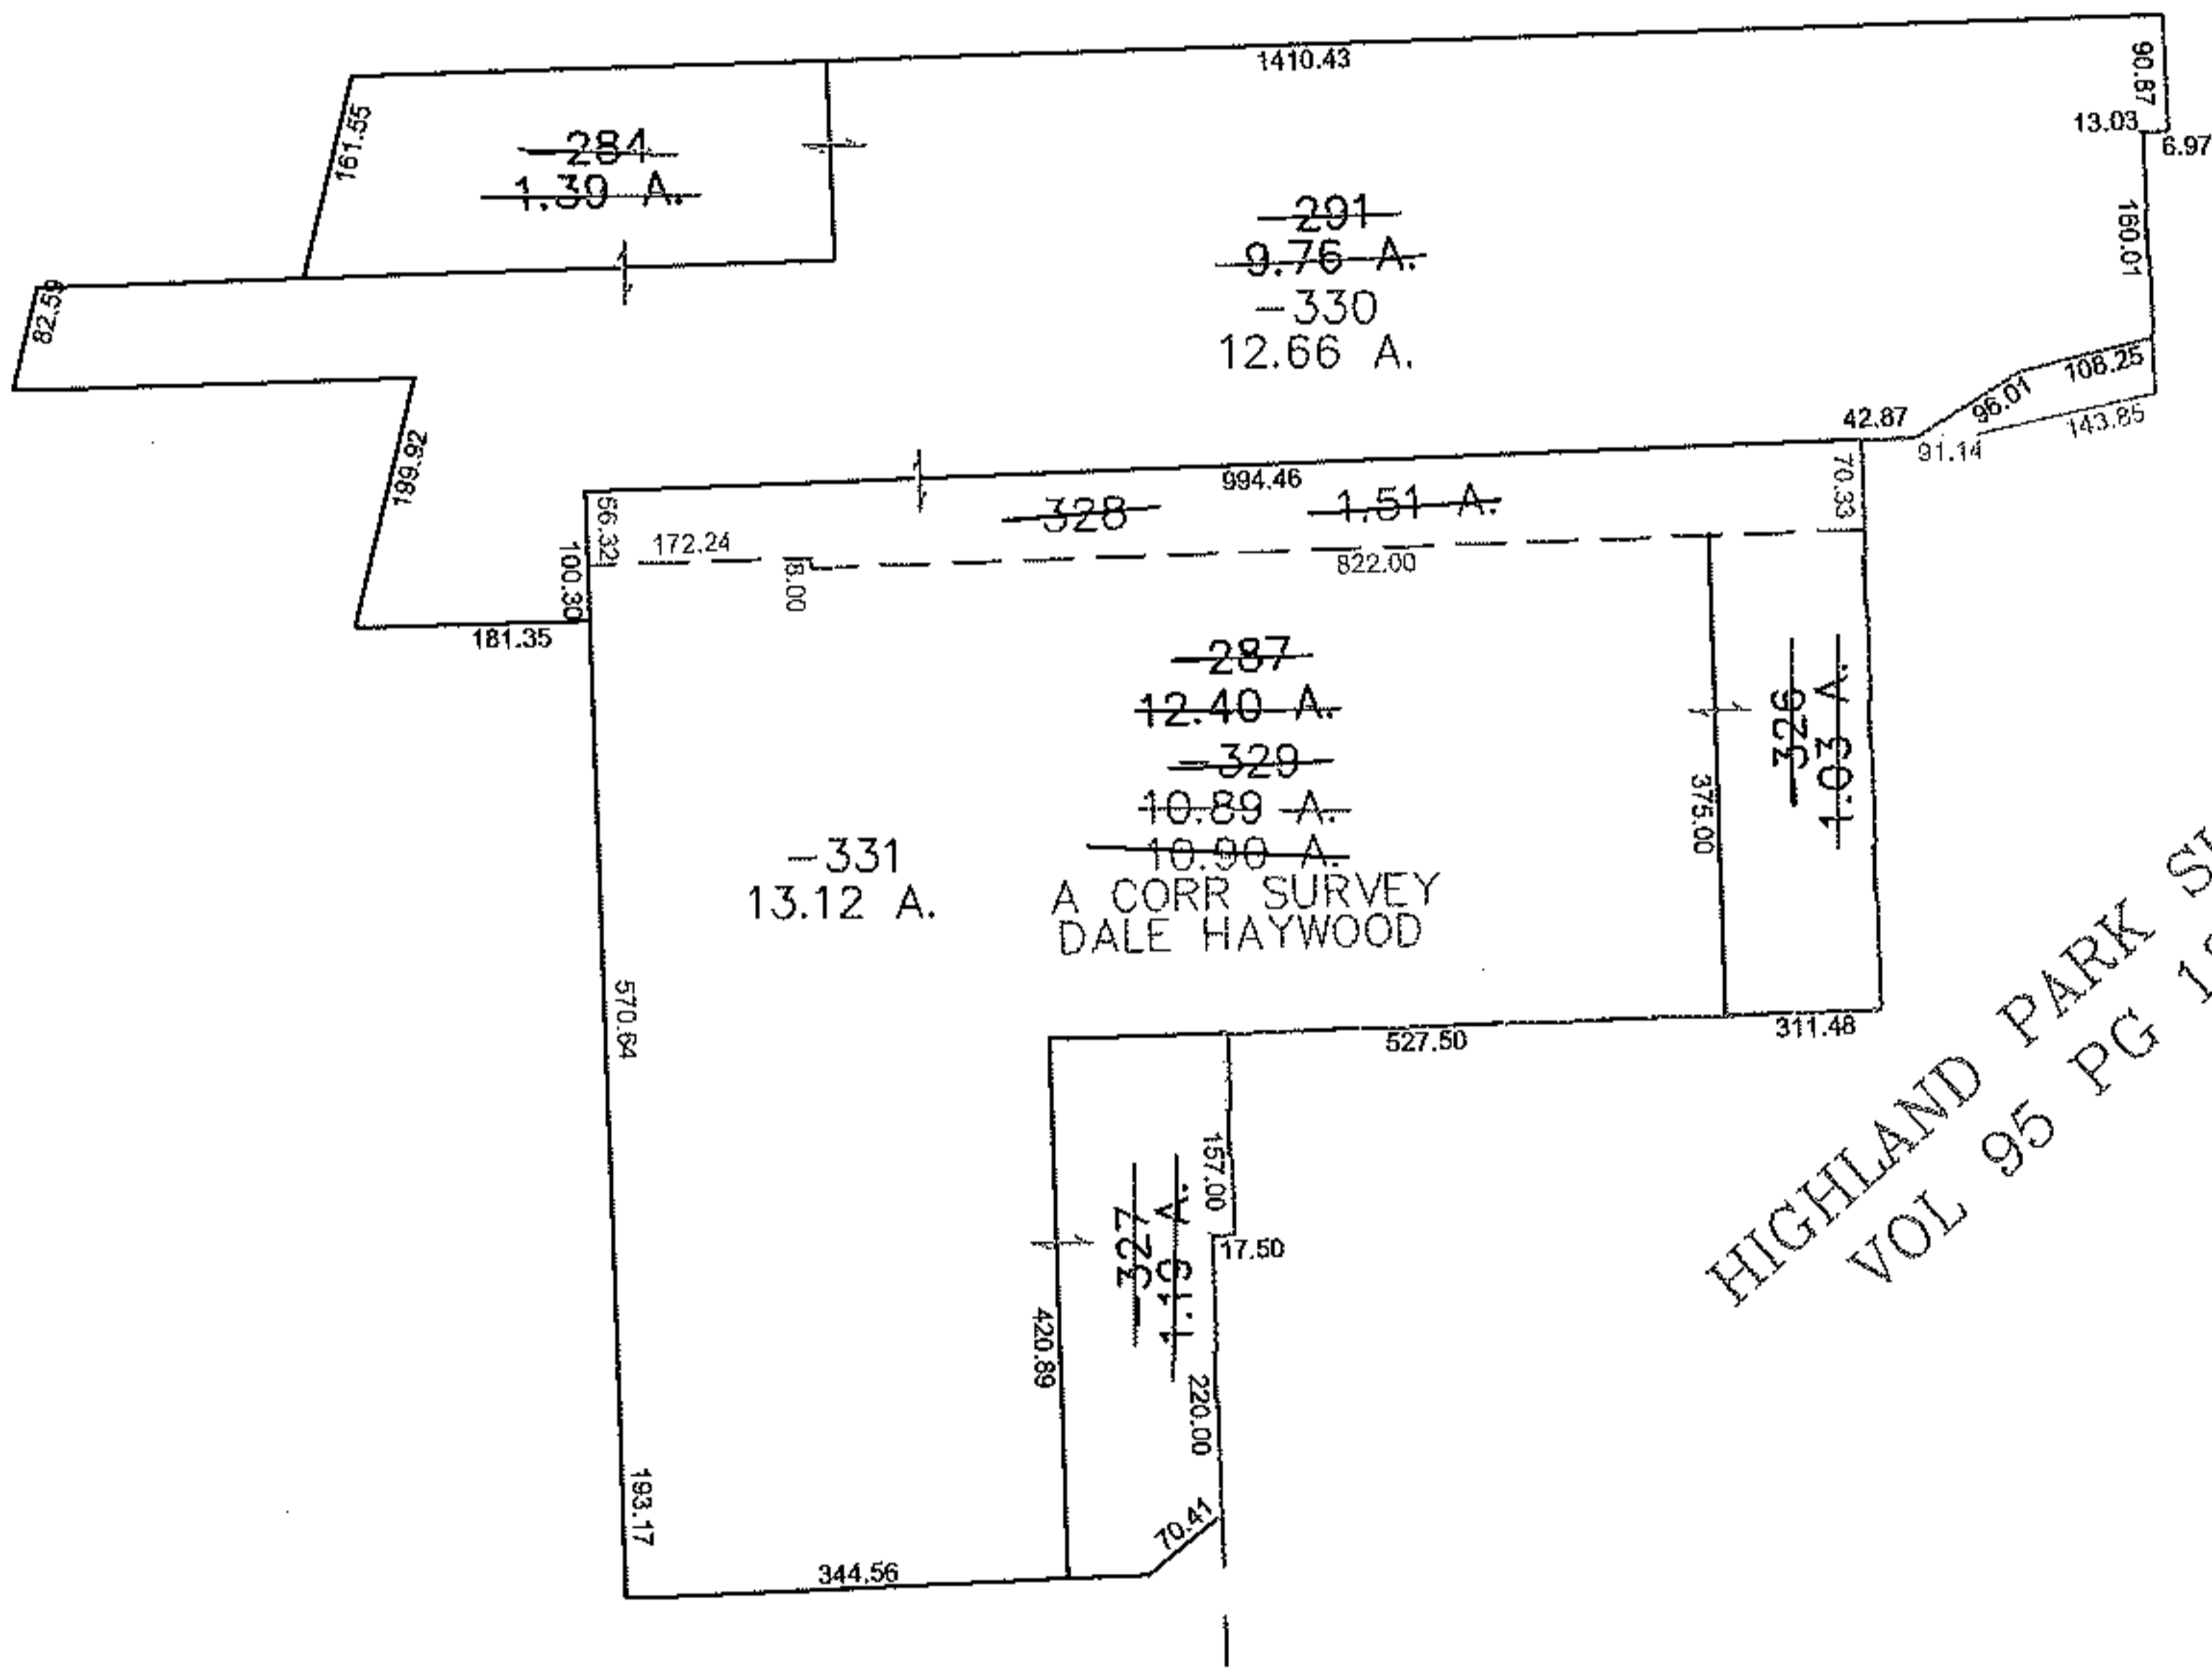



RASTER

PARENT PARCEL: 04-00-012-103-287, -284, 291, -326, -327
CHILD PARCEL: 04-00-012-103-328 THRU -331
STARTING POINT: NORTHWEST CORNER OF SL 501 IN HIGHLAND PARK SUB 17 VL 95/18

09-02733

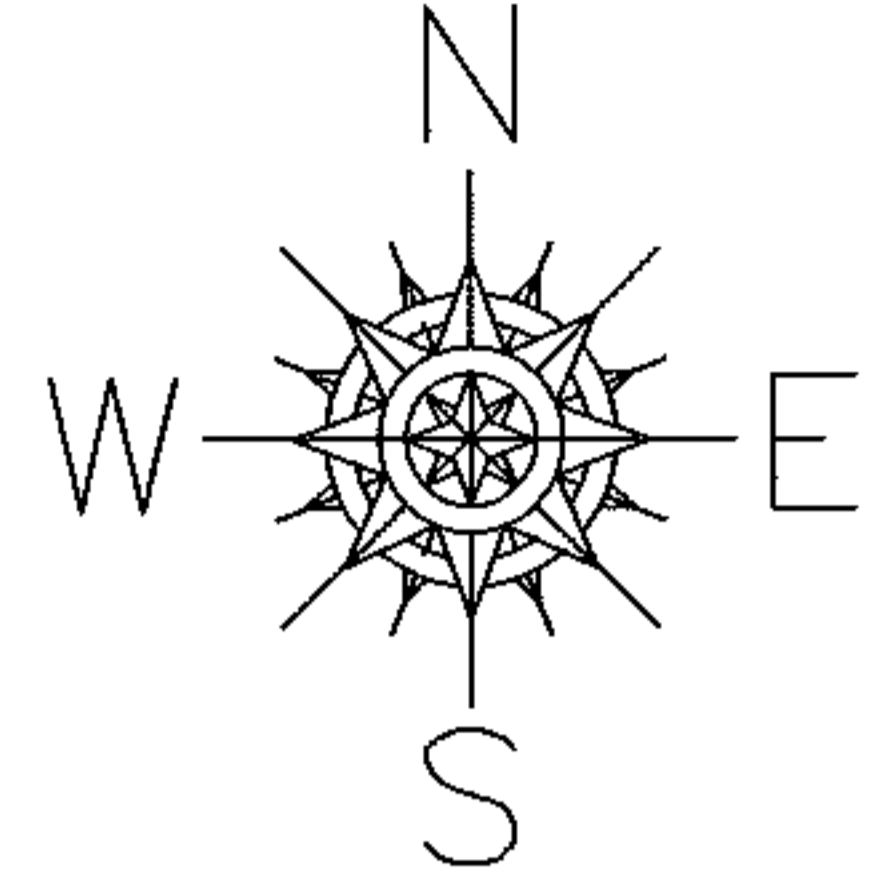

HIGHLAND PARK SUB NO 17
VOL 95 PG 18-20

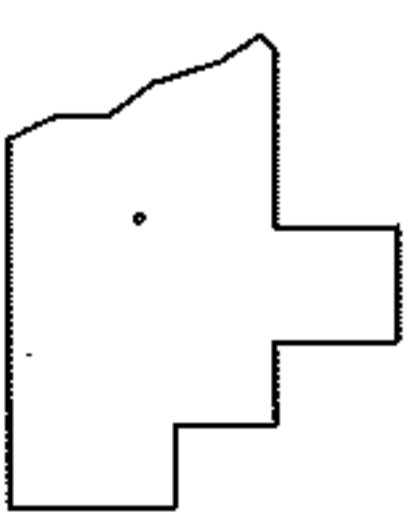

SPLITS/DEEDS PROCESSED
LORAIN COUNTY TAX MAP DEPARTMENT
226 MIDDLE AVE. ELYRIA, OHIO

SURVEYED BY: DALE HAYWOOD
CLOSURE: 0.00 : 10.000
MAP PAGE(S): 04-00-012-C
APPROVED BY: JAH DATE: 8-20-09
SCALE: 1" = 300 PRIOR INSTRUMENT: 20080259880