
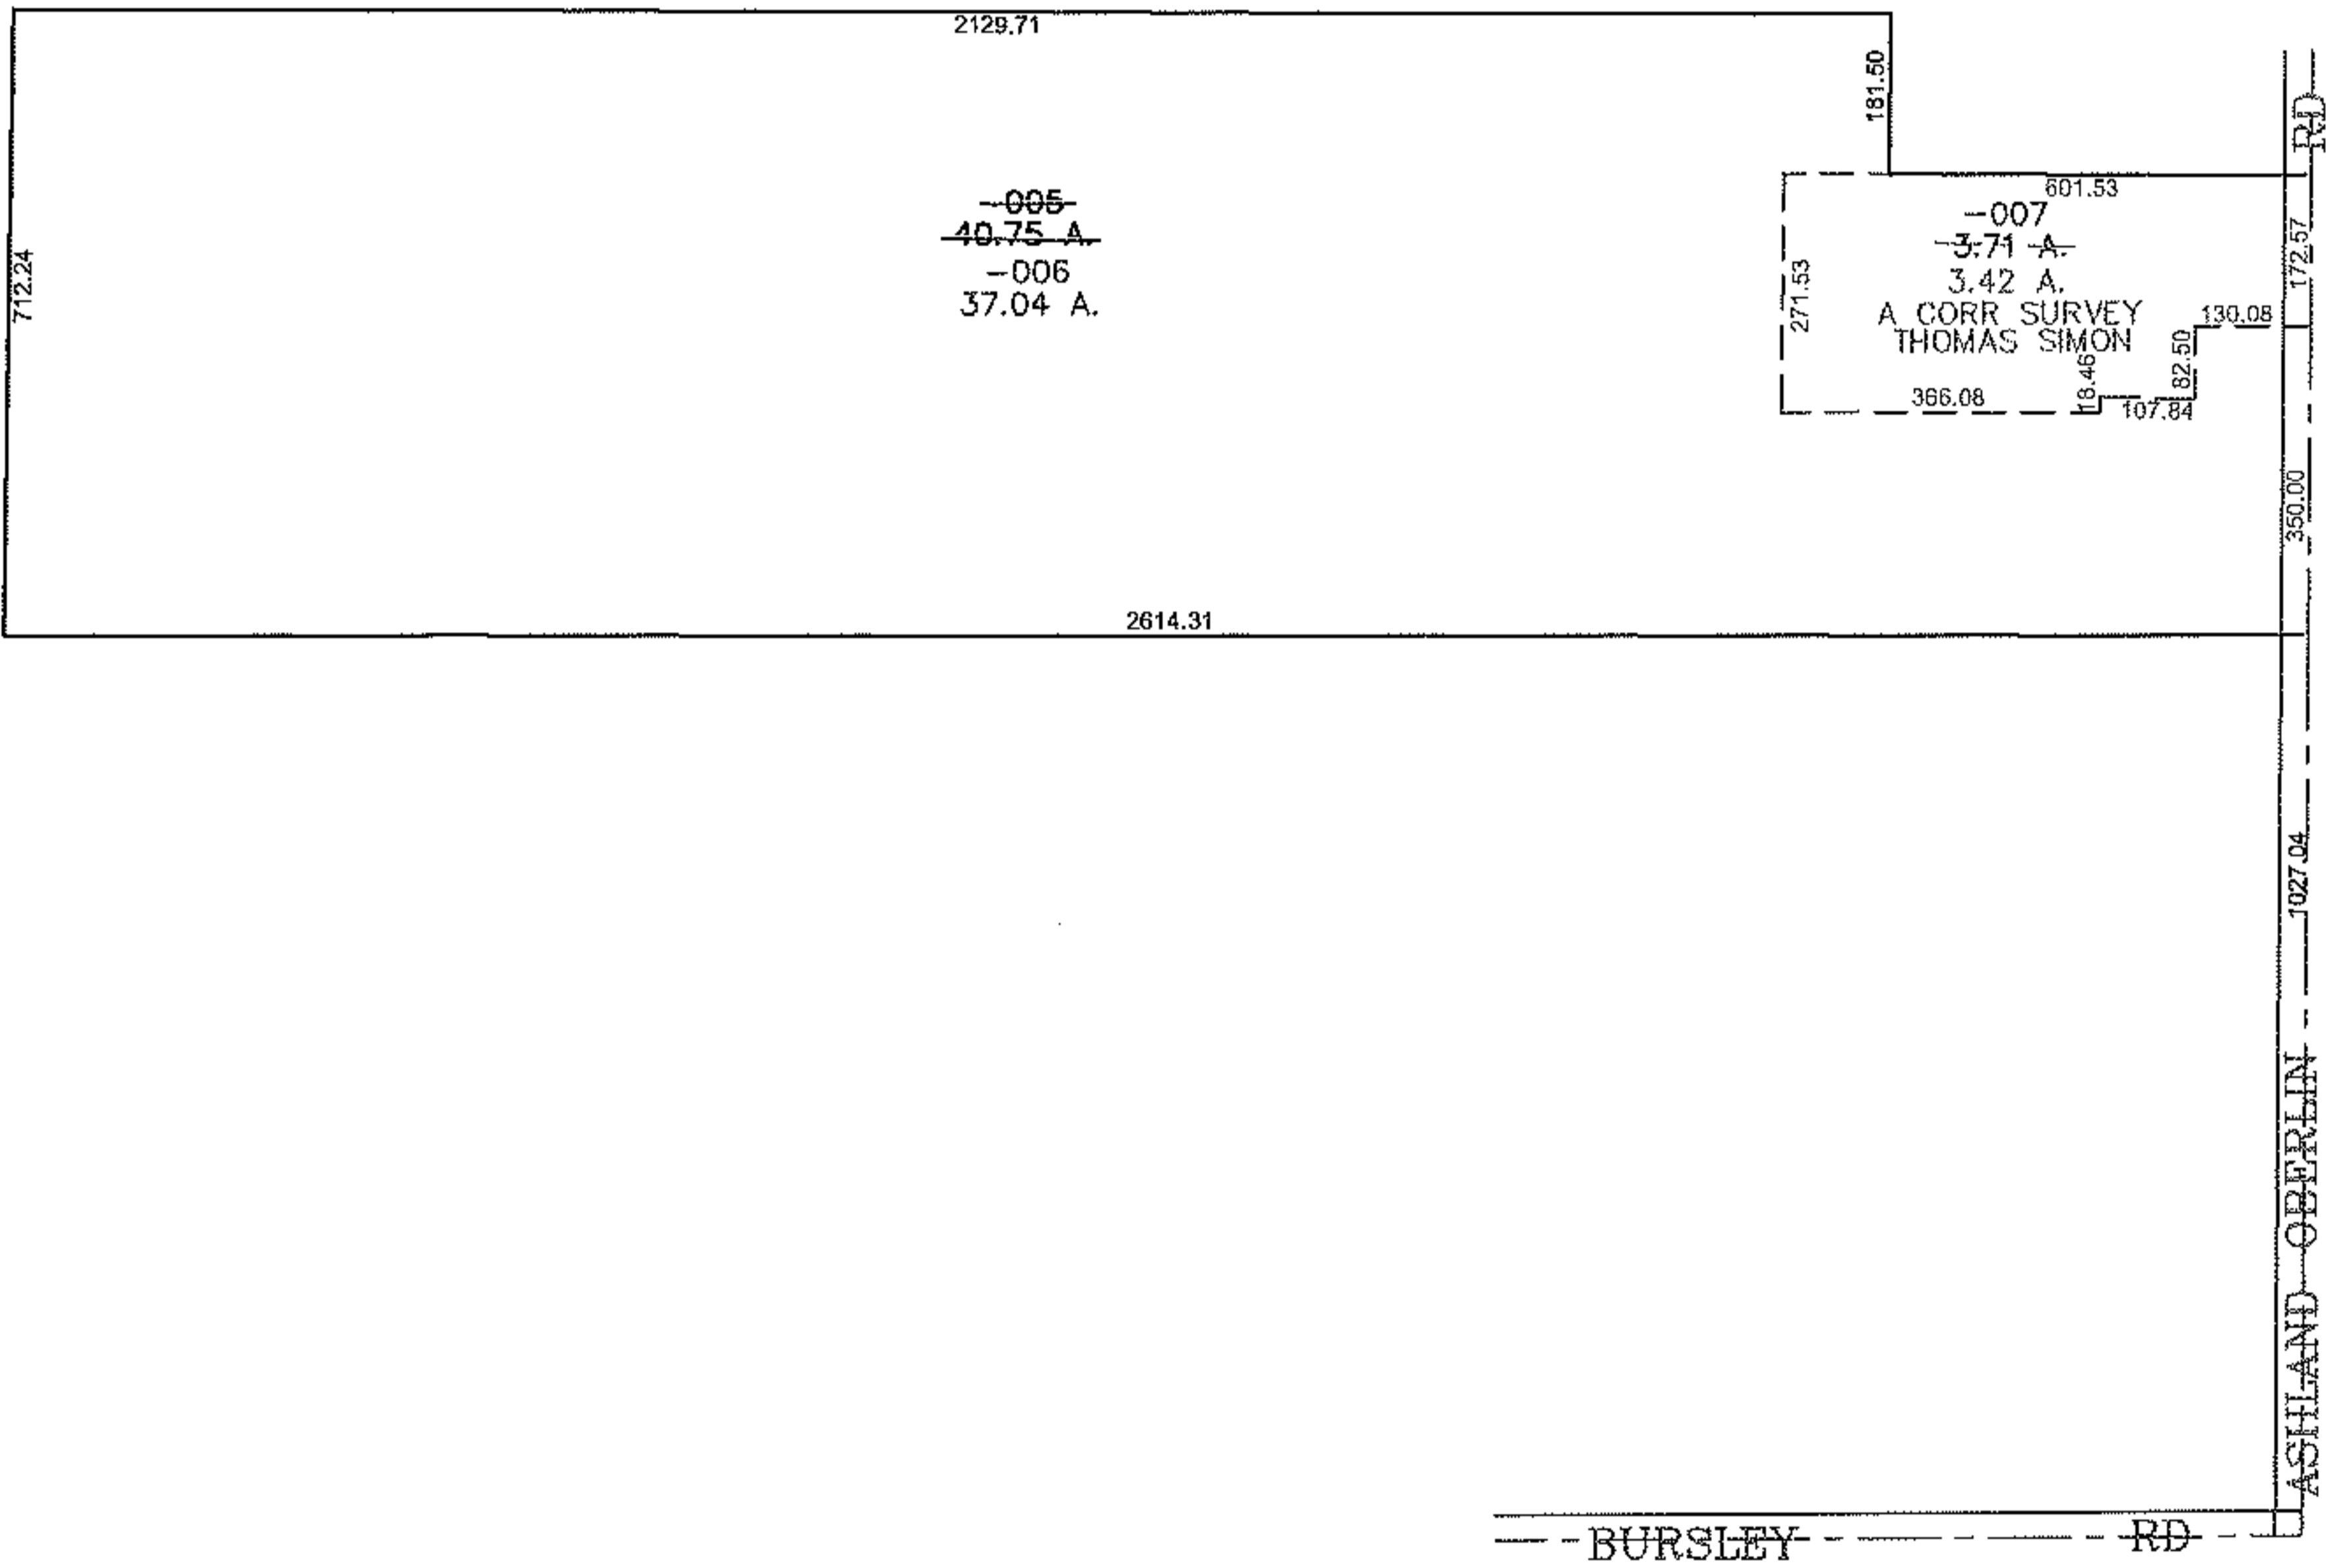


RASTER

PARENT PARCEL: 21-05-005-000-005
CHILD PARCEL: 21-05-005-000-006, -007
STARTING POINT: CENTERLINE OF BURSLEY RD & ASHLAND-OBERLIN RD

09-02736

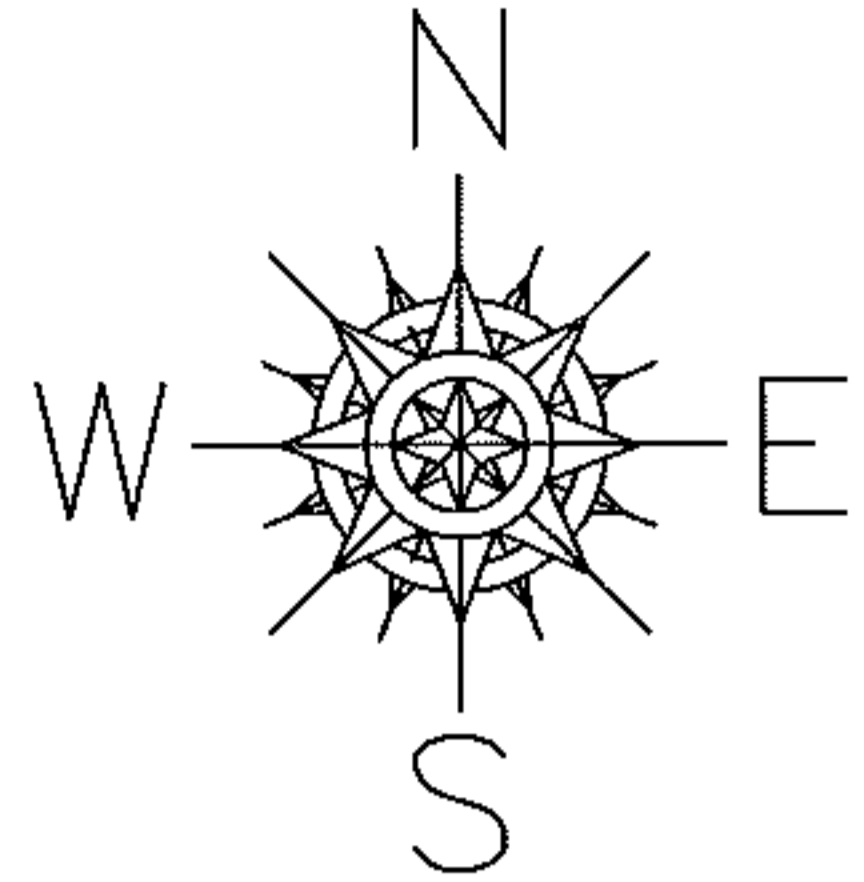


~~-005~~
~~40.75 A.~~
~~-006~~
37.04 A.

601.53
~~-007~~
~~3.71 A.~~
3.42 A.
A CORR SURVEY
THOMAS SIMON
130.08
82.50
107.84
366.08

ASHLAND-OBERLIN RD

BURSLEY RD

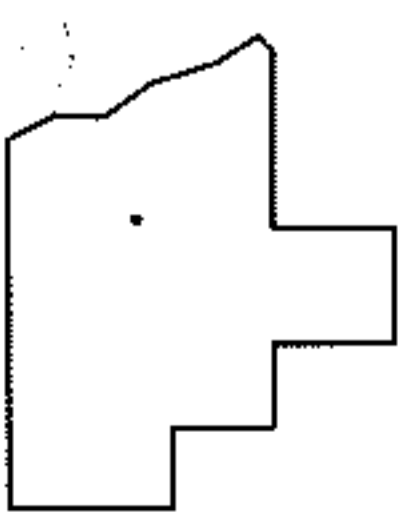

SPLITS/DEEDS PROCESSED
LORAIN COUNTY TAX MAP DEPARTMENT
226 MIDDLE AVE. ELYRIA, OHIO

SURVEYED BY: THOMAS SIMON
CLOSURE: 0.00 : 10,000
MAP PAGE(S): 21-B
APPROVED BY: JAH DATE: 9-8-09
SCALE: 1"= 400 PRIOR INST.: 20060880686