



RASTER

PARENT PARCEL: 06-25-001-000-106

CHILD PARCEL: 06-25-001-000-238, -239

STARTING POINT: CENTERLINE OF QUEEN ANNE CIRCLE & OAKDALE CIRCLE

09-02737

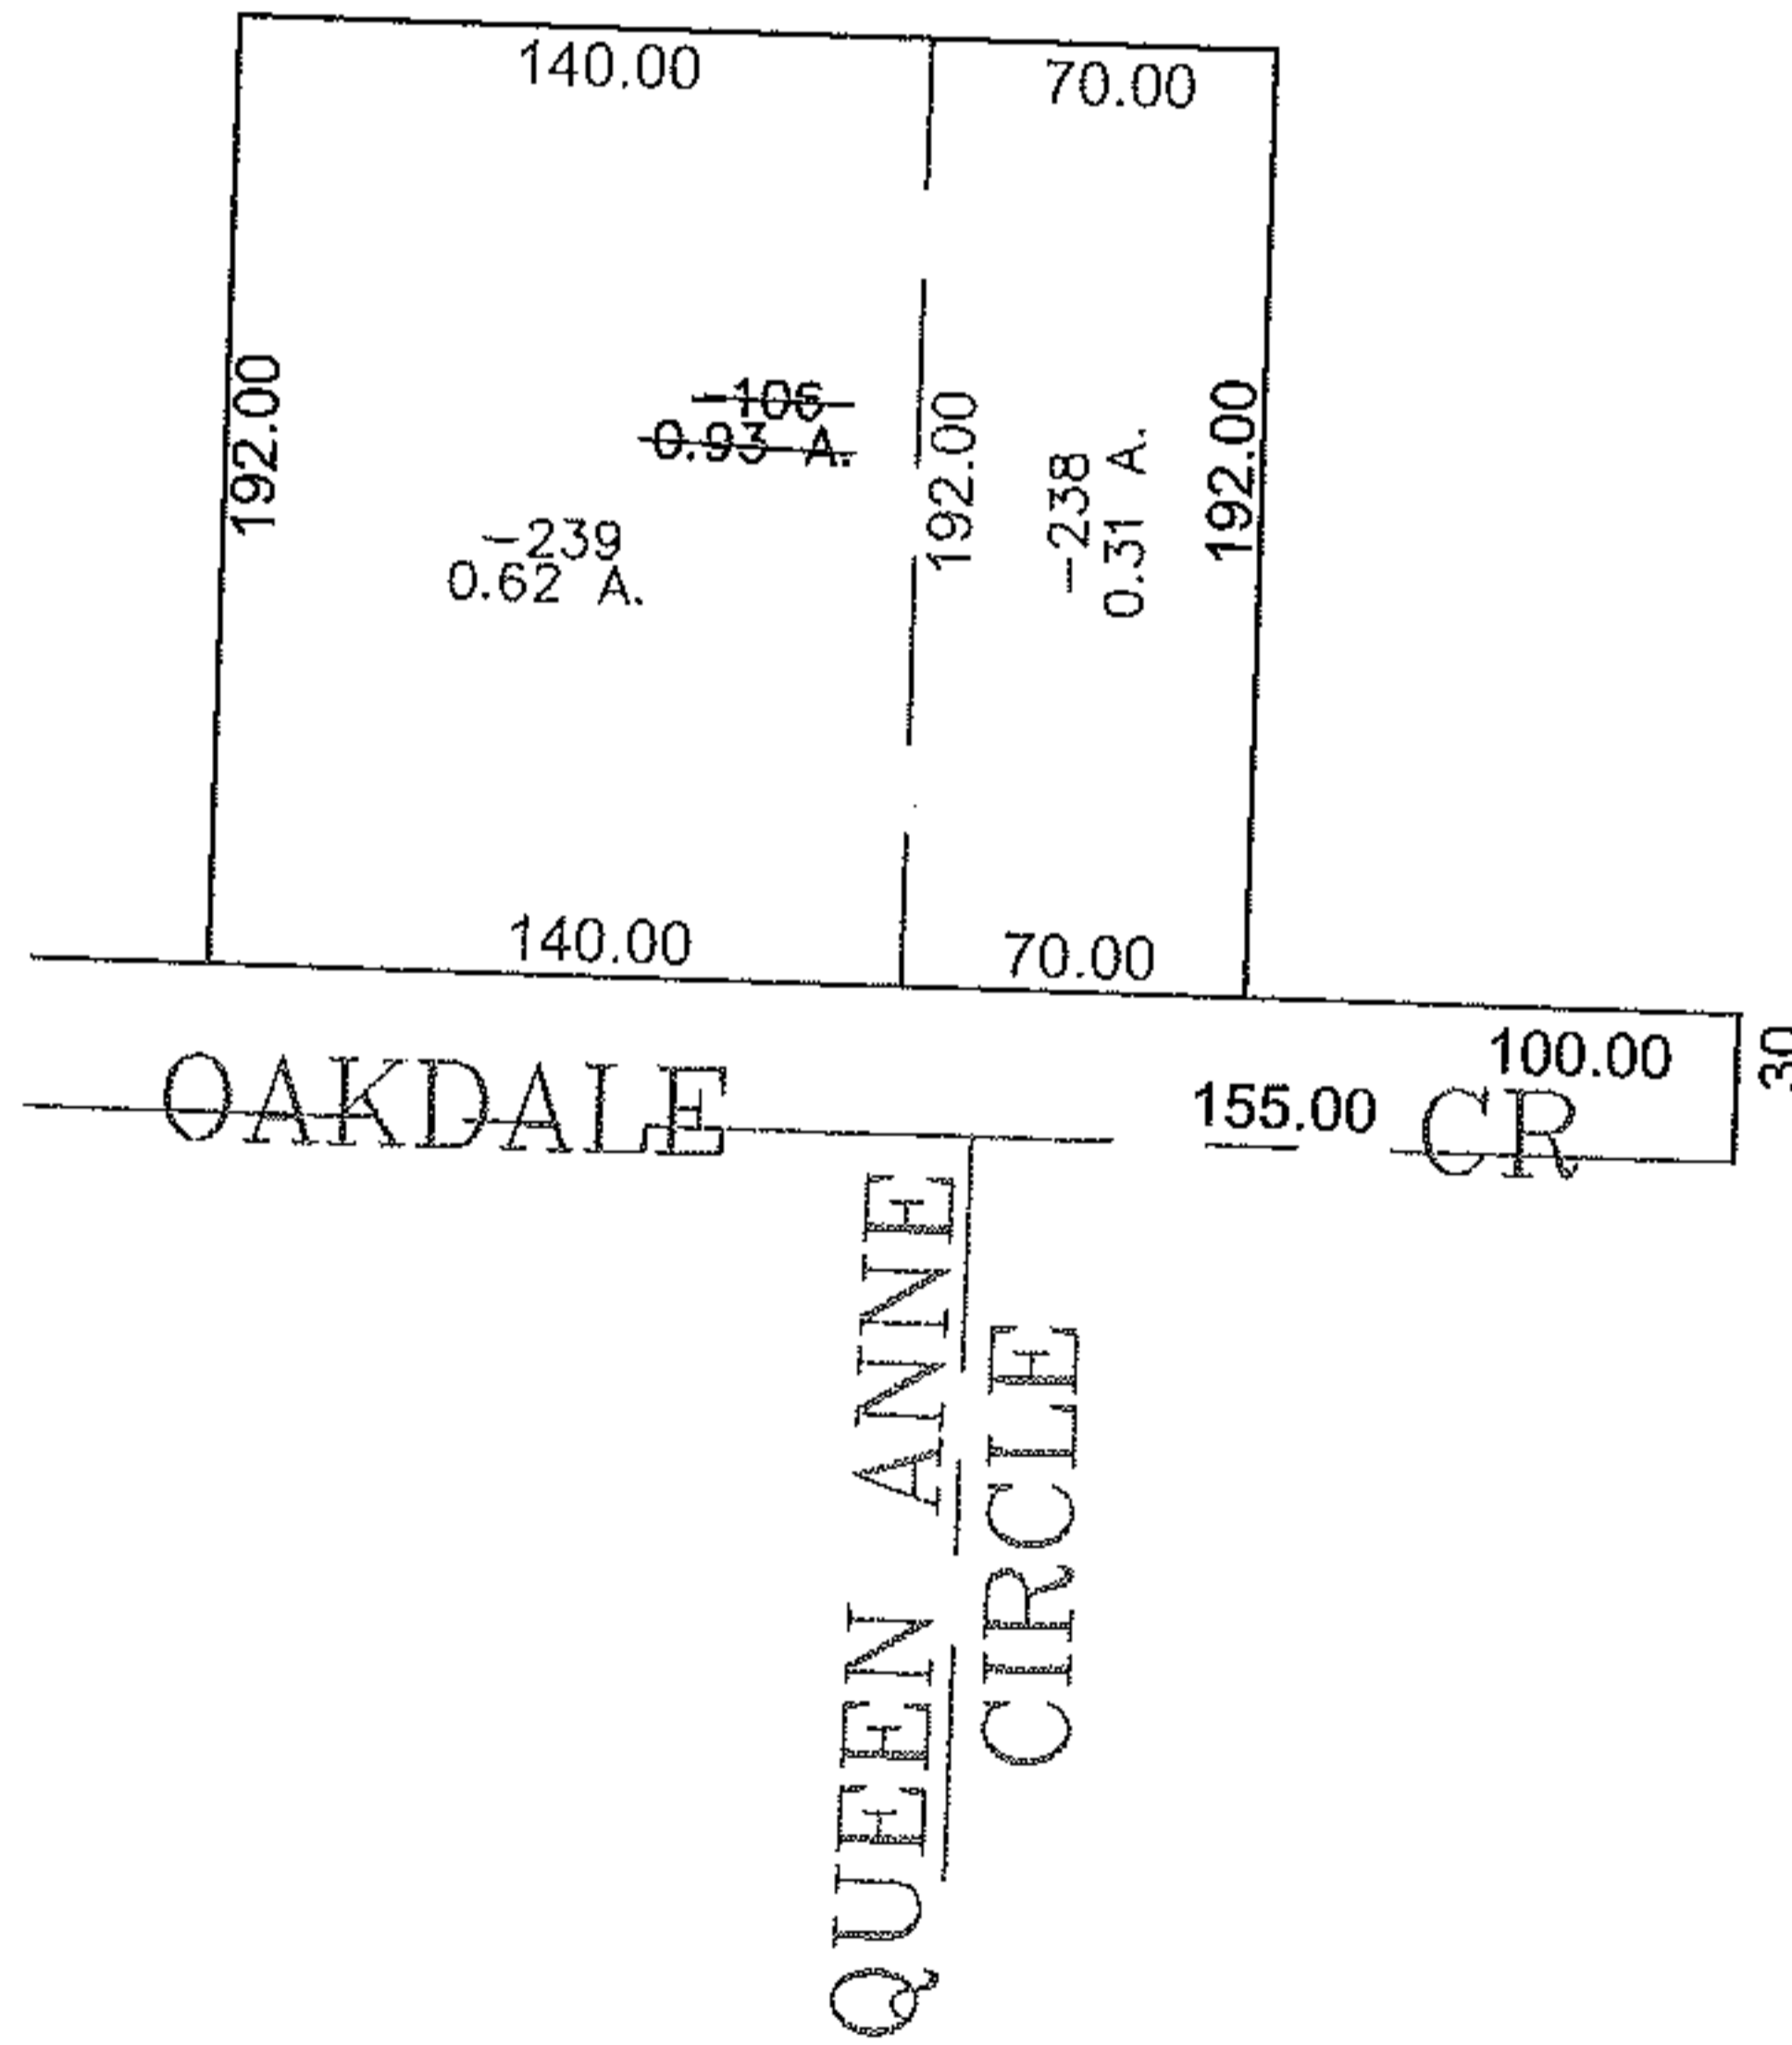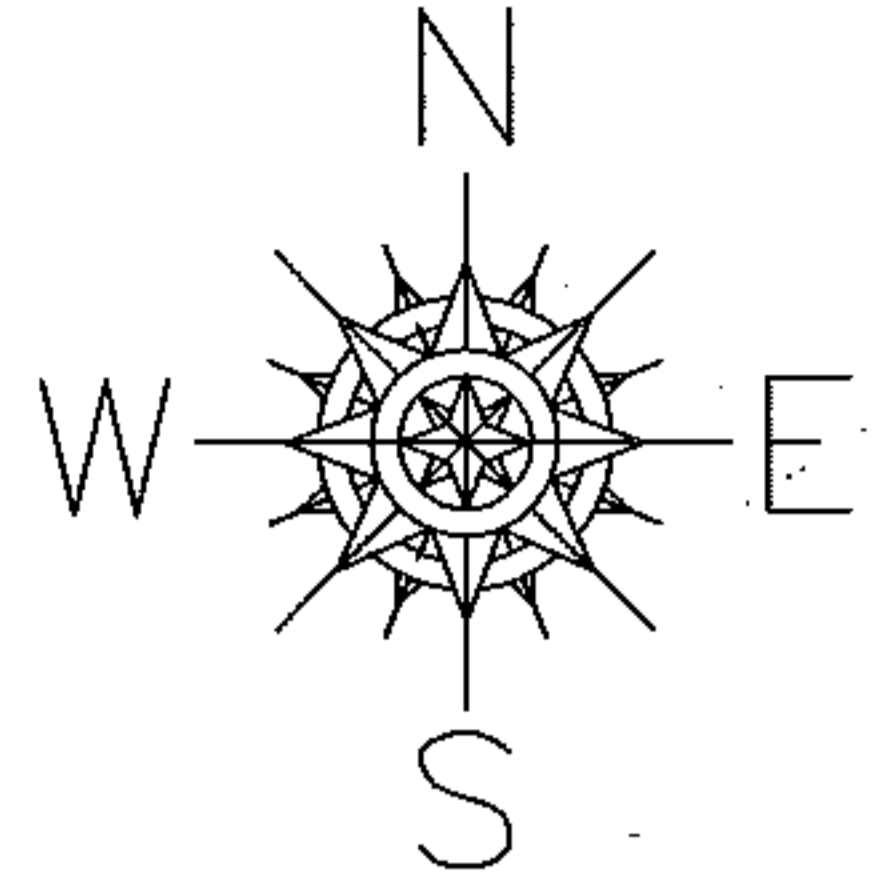

SPLITS/DEEDS PROCESSED

LORAIN COUNTY TAX MAP DEPARTMENT
226 MIDDLE AVE. ELYRIA, OHIO

SURVEYED BY: DAVE ELWELL

CLOSURE: 0.00 : 10.000

MAP PAGE(S): 6-143

APPROVED BY: JAH DATE: 9-9-09

SCALE: 1" = 100 PRIOR INSTRUMENT: PL 54/36