


PARENT PARCEL: 12-00-025-000-042, -043


CHILD PARCEL: 12-00-025-000-065 THRU -067

STARTING POINT: CENTERLINE OF BOONE RD & S/34 IN CHECK ALLOT.

09-02739

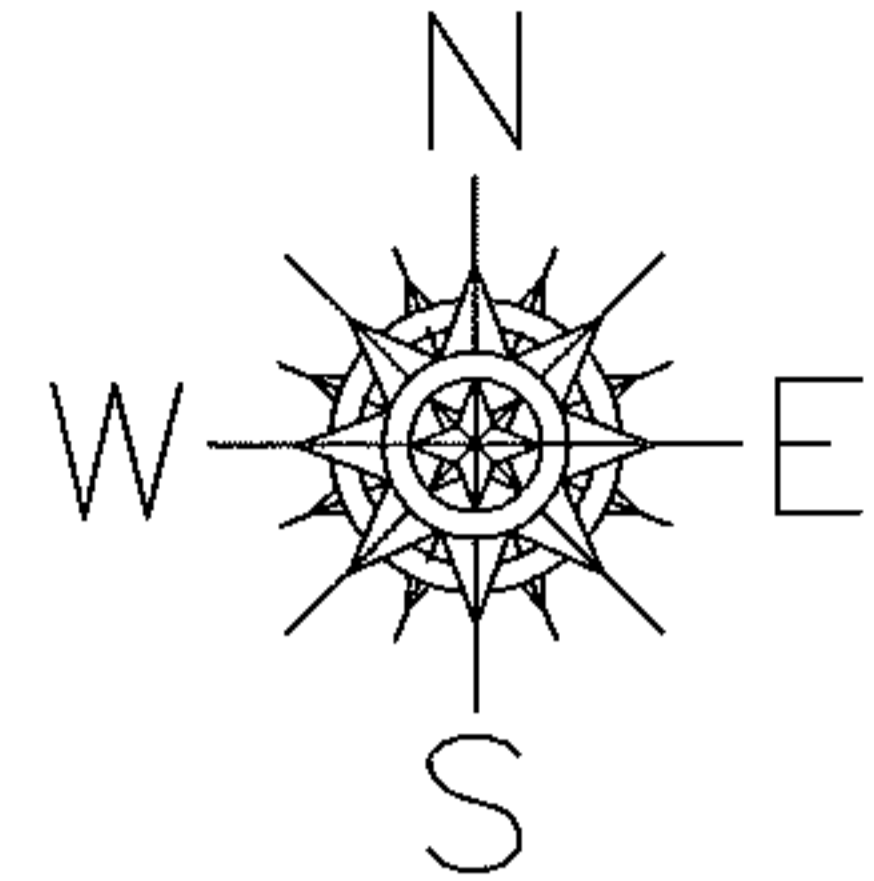

CHECK ALLOT.
VOL 16 PG 36

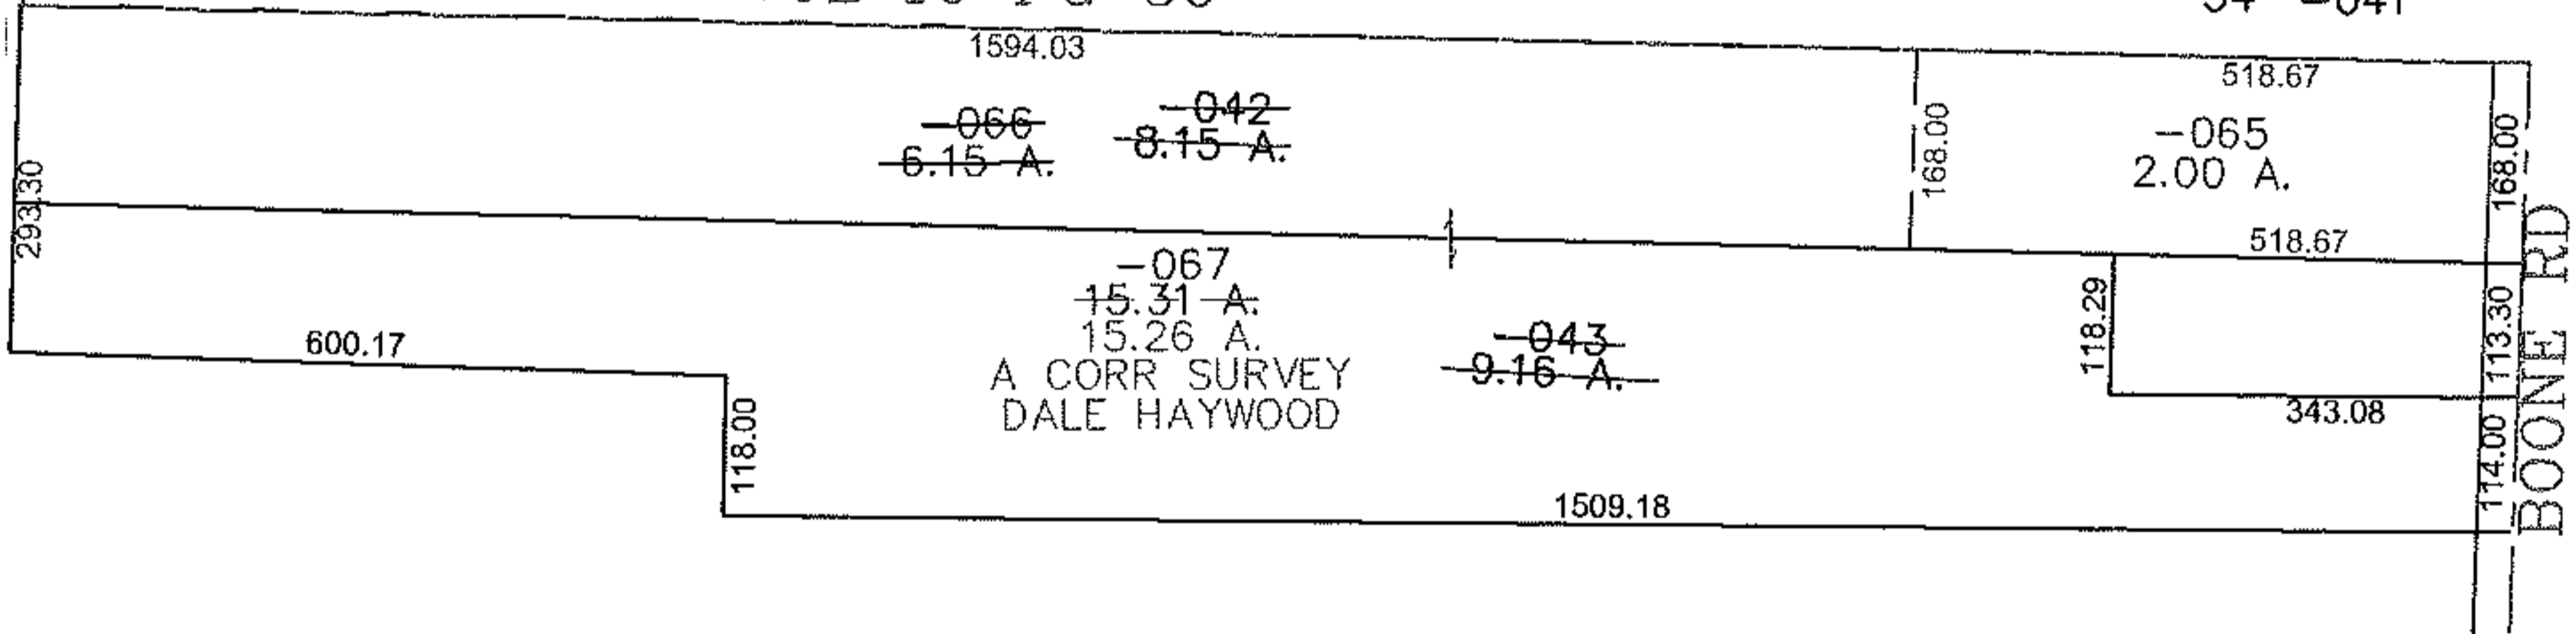

SPLITS/DEEDS PROCESSED

LORAIN COUNTY TAX MAP DEPARTMENT
226 MIDDLE AVE. ELYRIA, OHIO

SURVEYED BY: DALE HAYWOOD
 CLOSURE: 0.00 : 10,000
 MAP PAGE(S): 12-00-025-A, B
 APPROVED BY: JAH DATE: 9-10-09
 SCALE: 1" = 300 PRIOR INSTRUMENT: 19980530466