
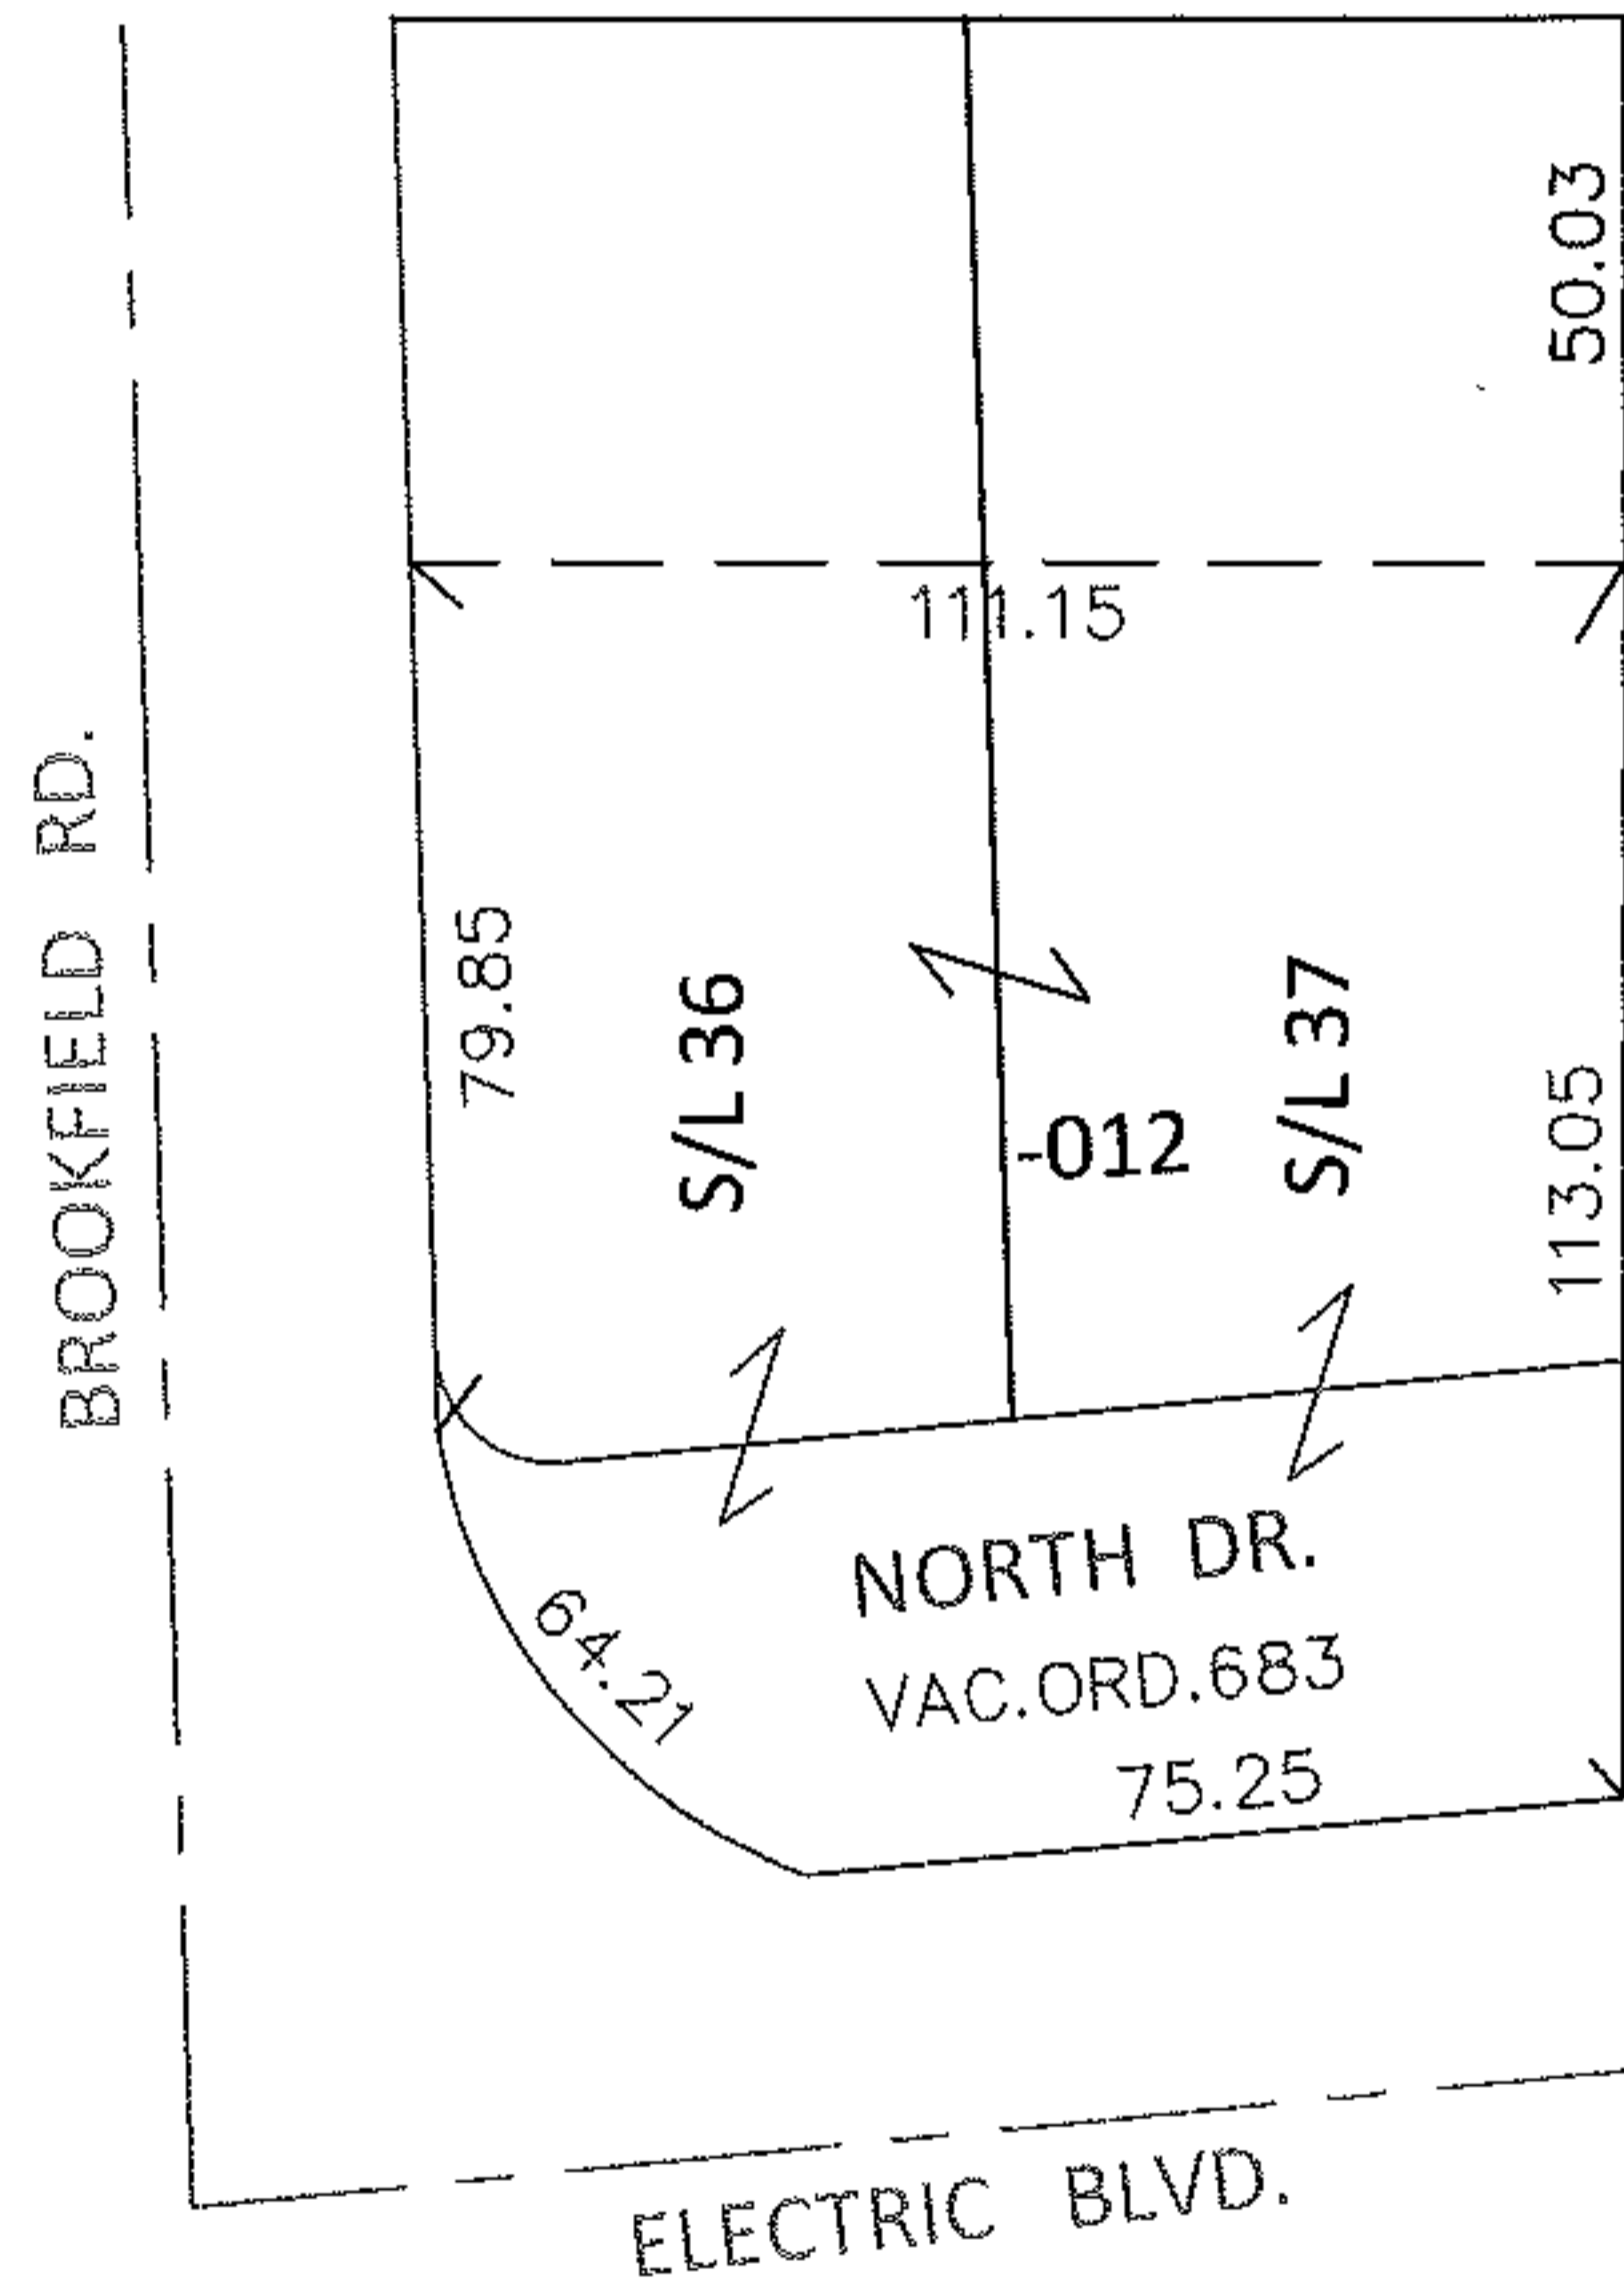


PARENT PARCEL: 04-00-018-104-012

CHILD PARCEL: _____

13-02740-C

STARTING POINT: NORTHEAST CORNER OF S/L 37 IN INWOOD BEACH NO.1 (VOL.12 PG.28)

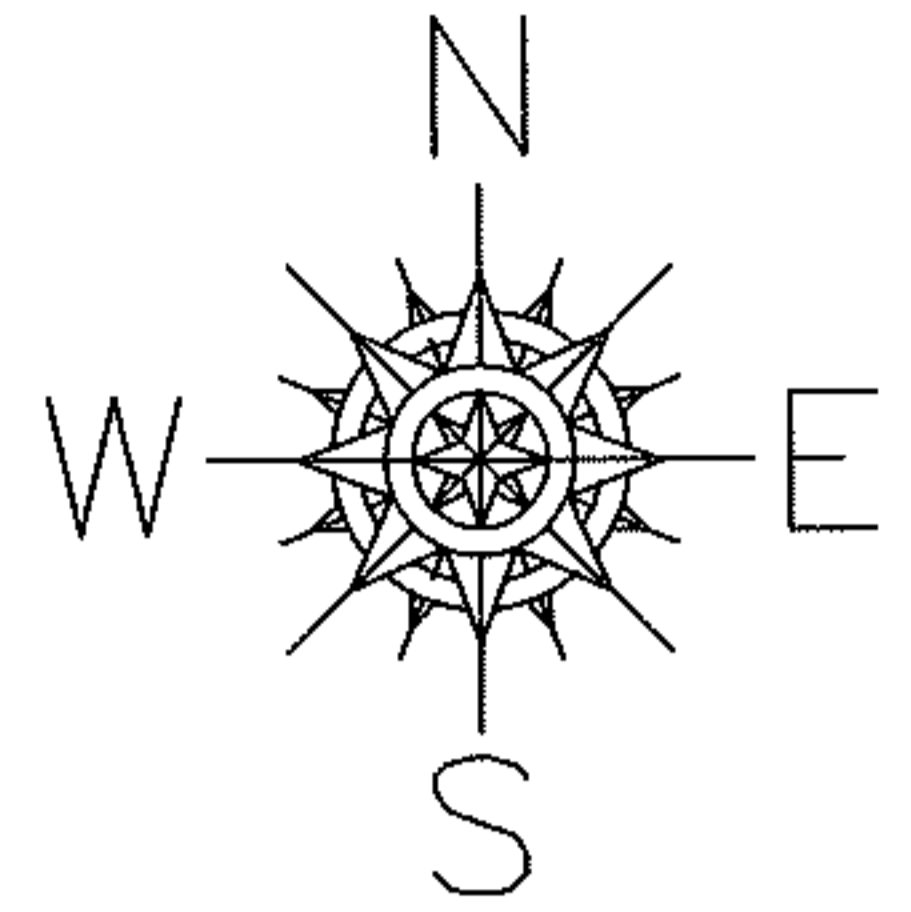


FRONTAGE, DEPTH & MAP CORRECTION

04-00-018-104-012

144.06 X 111.15

~~116 X 108.84~~

PER PRIOR DEEDS

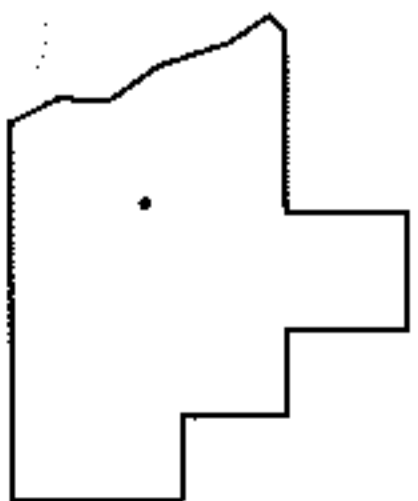

SPLITS/DEEDS PROCESSED

LORAIN COUNTY TAX MAP DEPARTMENT
226 MIDDLE AVE. ELYRIA, OHIO

SURVEYED BY: N/A

CLOSURE: N/A

MAP PAGE(S): 4-00-018-B

APPROVED BY: RRM DATE: 6-4-13

SCALE: 1" = 50' PRIOR INST.: OR 999/340