




RASTER

PARENT PARCEL: 04-00-011-108-084

CHILD PARCEL: 04-00-011-108-161, -162

STARTING POINT: CENTERLINE OF STONEY RIDGE RD & HARRIMAN TR

09-02743

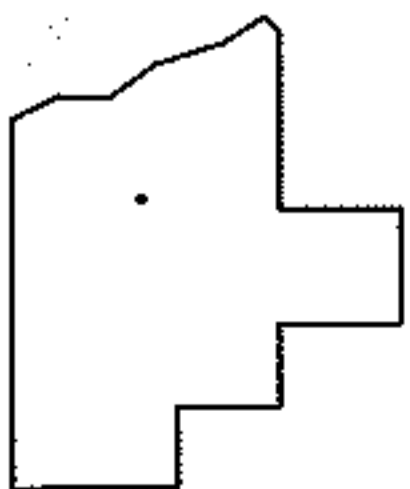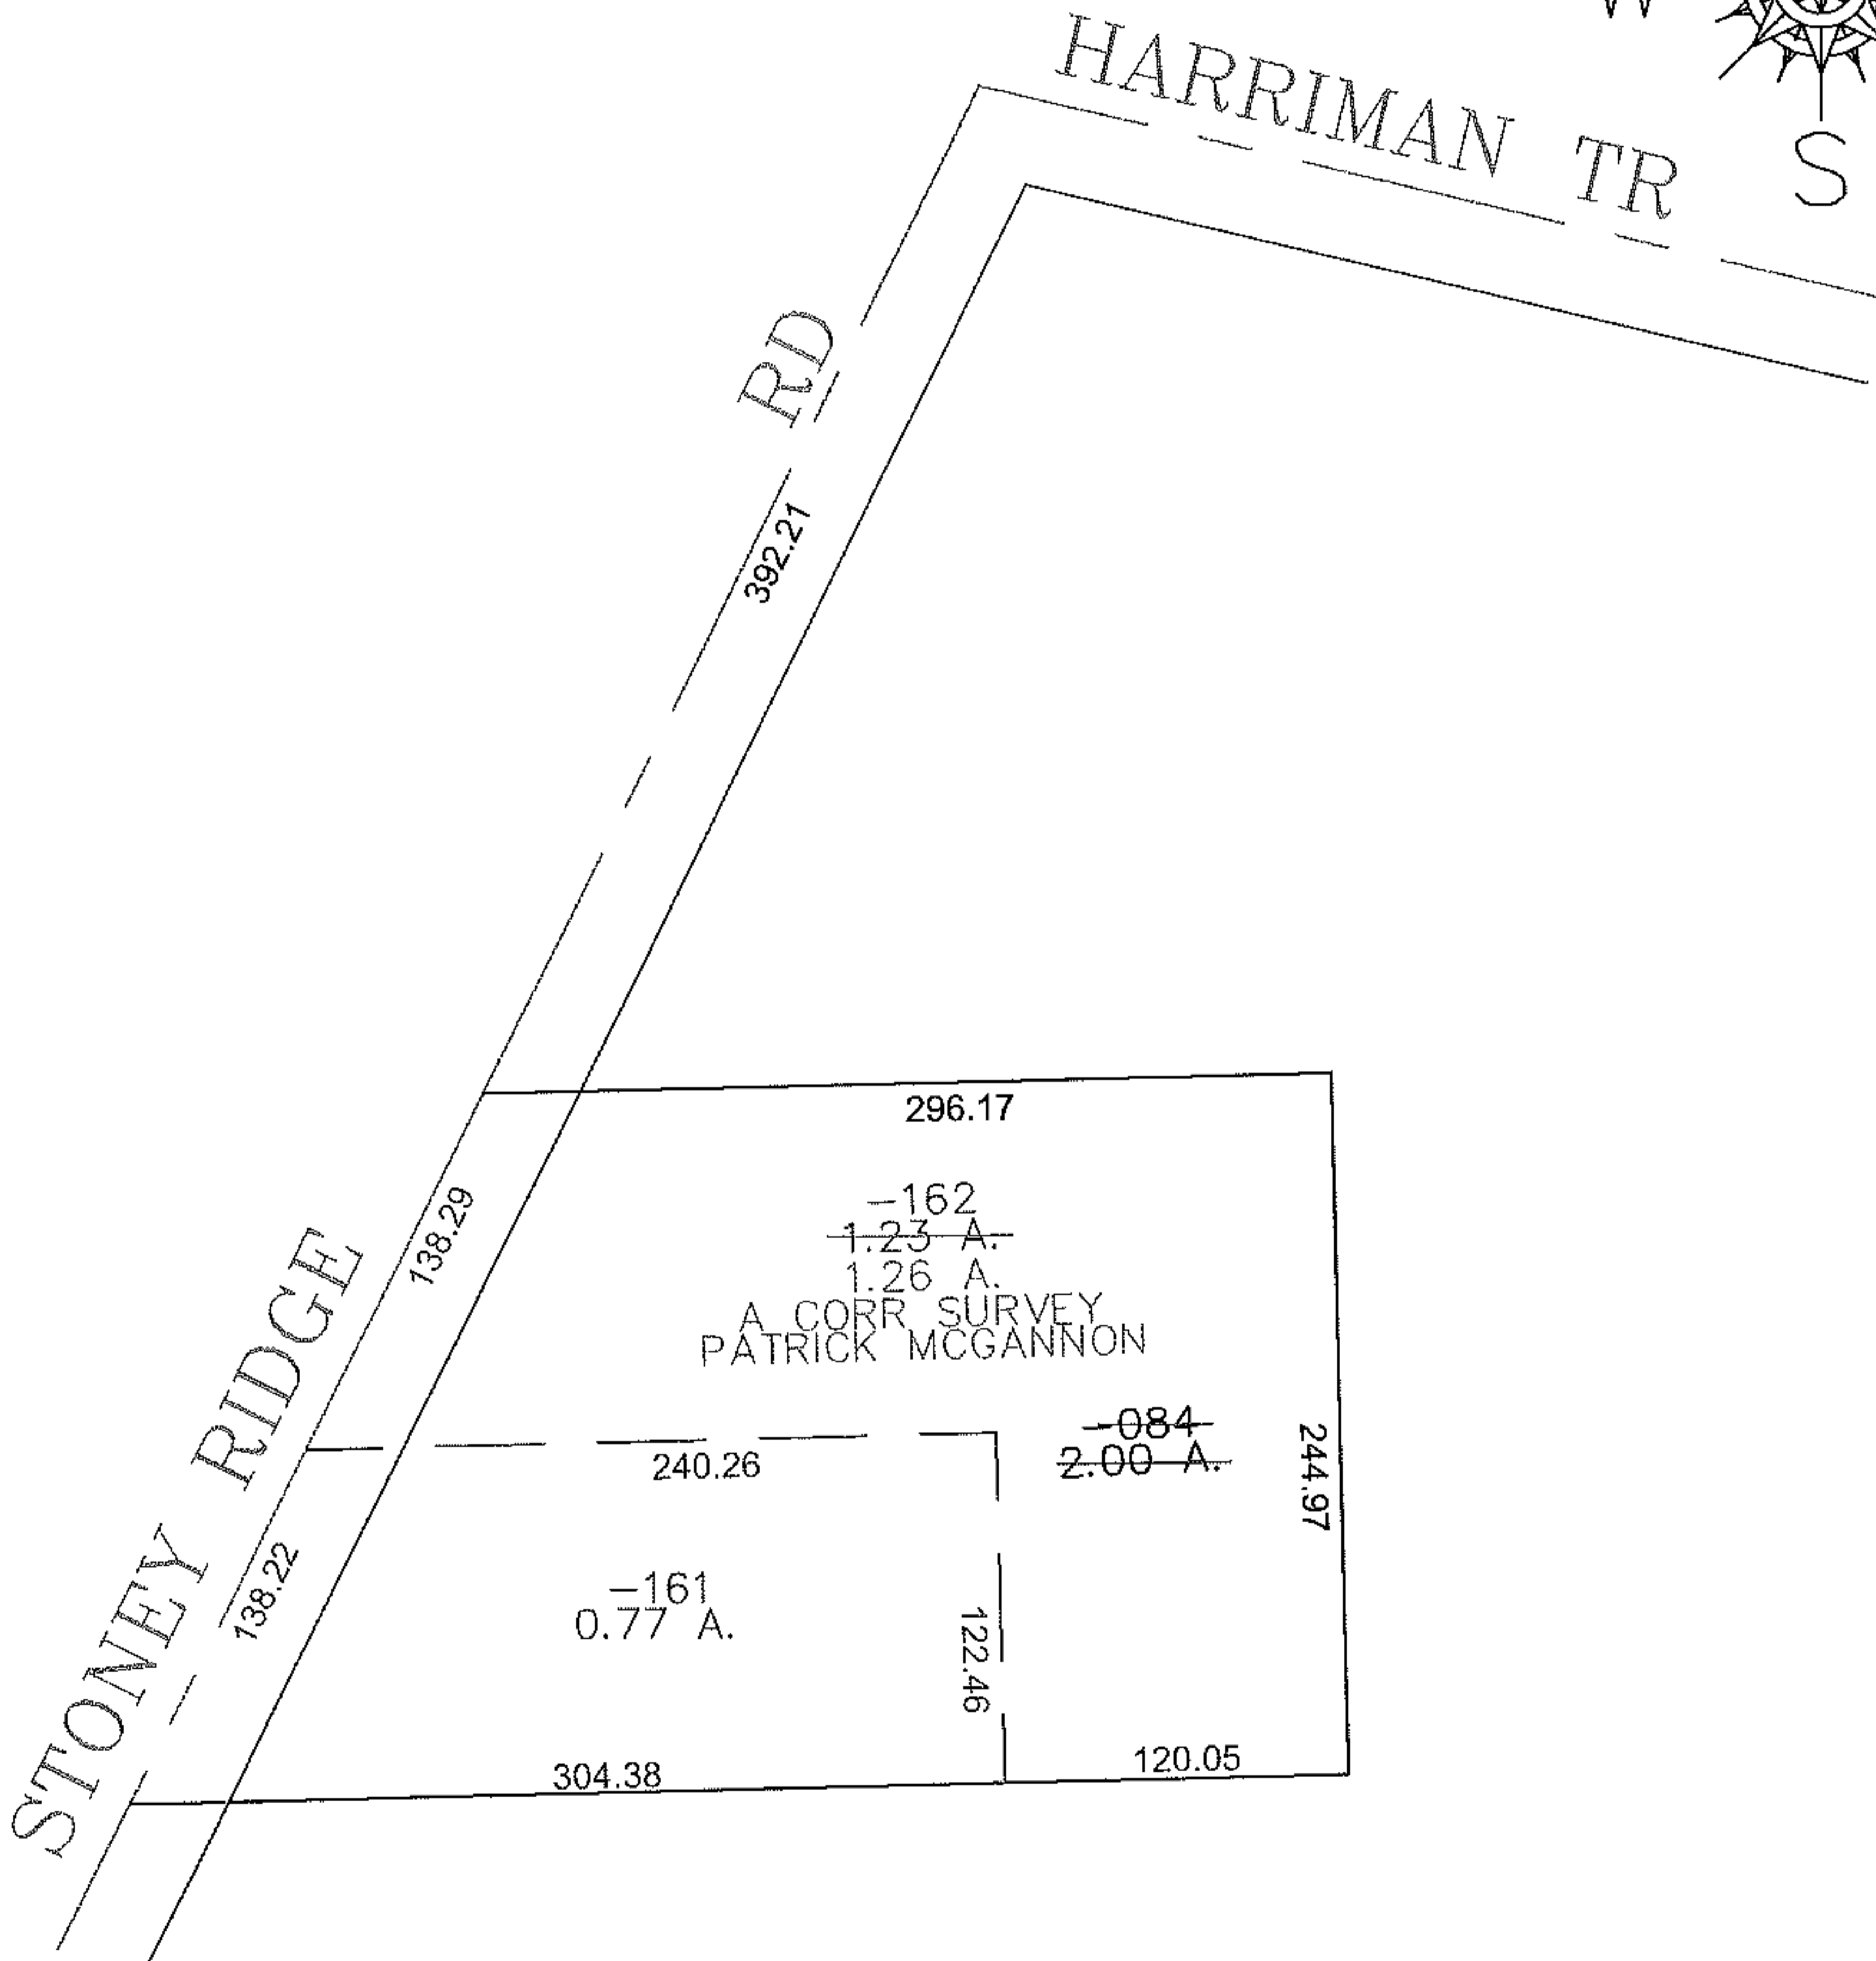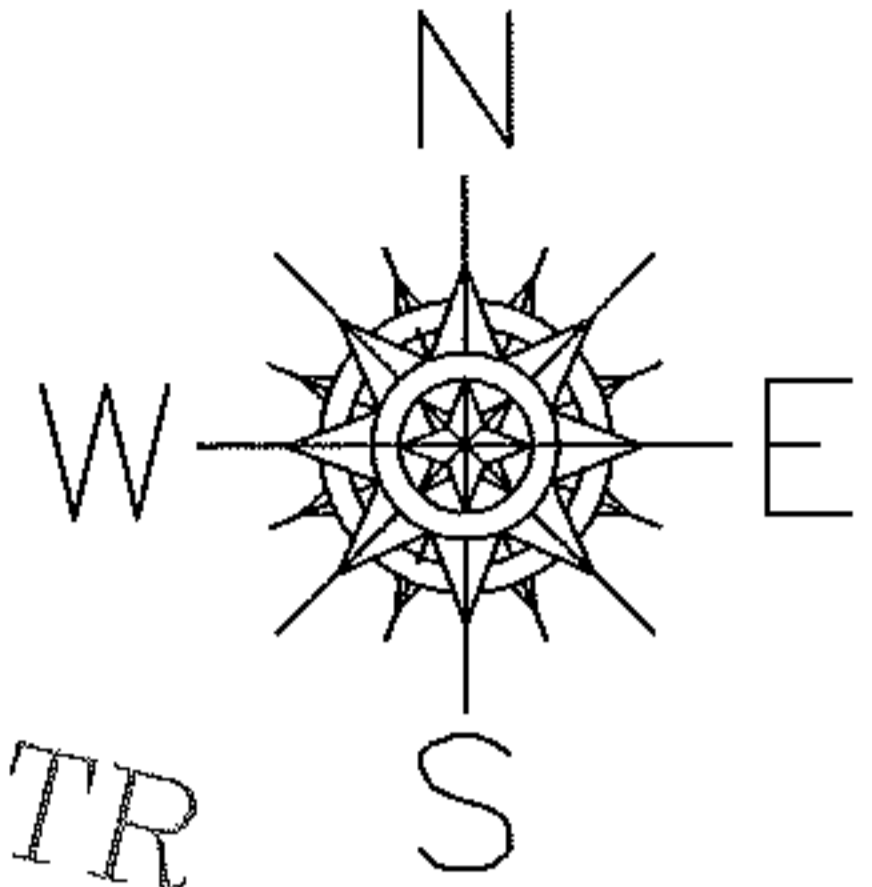

SPLITS/DEEDS PROCESSED

LORAIN COUNTY TAX MAP DEPARTMENT
226 MIDDLE AVE. ELYRIA, OHIO

SURVEYED BY: PATRICK MCGANNON

CLOSURE: 0.00 : 10.000

MAP PAGE(S): 04-00-011-H

APPROVED BY: JAH DATE: 9-29-09

SCALE: 1" = 100 PRIOR INSTRUMENT: 20090300020