
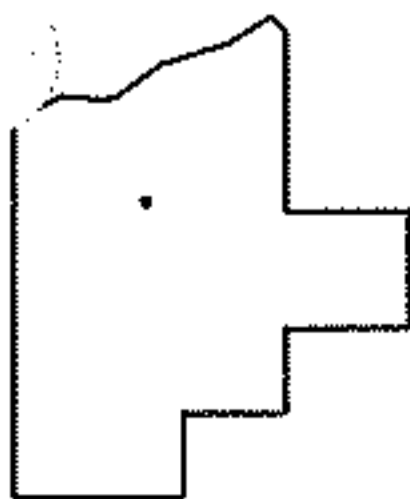
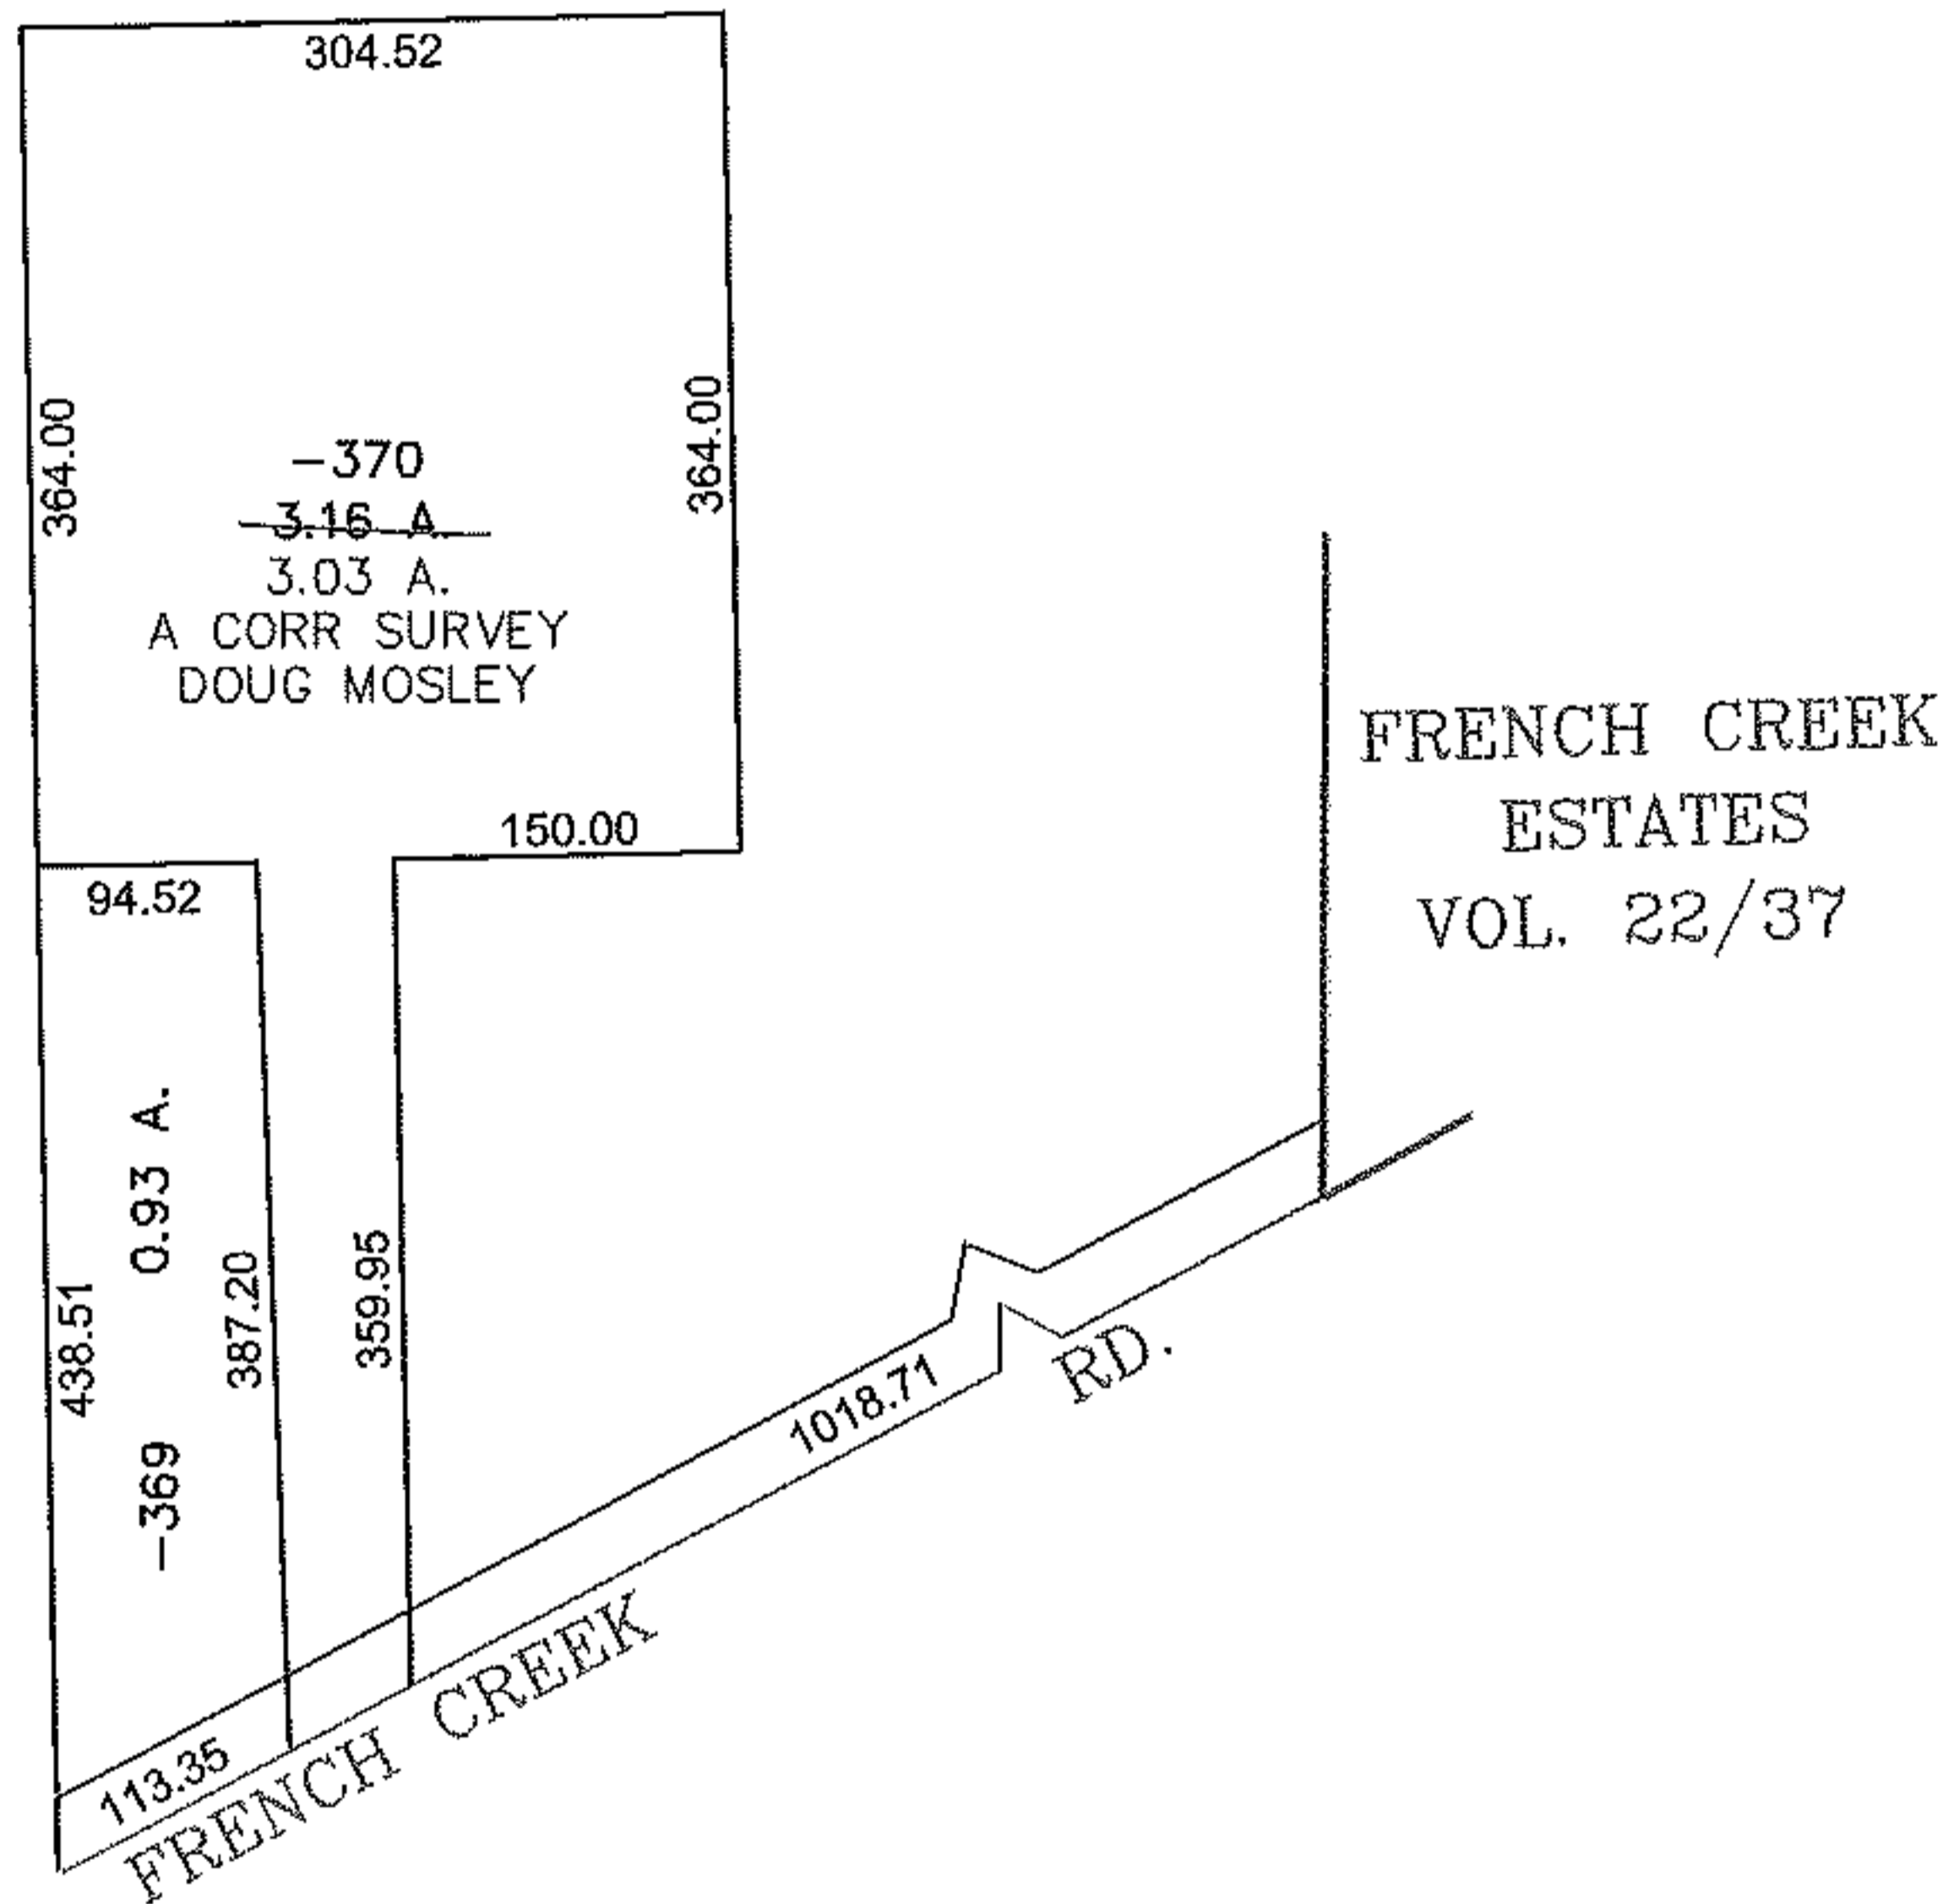


PARENT PARCEL: 04-00-003-101-370

CHILD PARCEL: SAME

STARTING POINT: CENTERLINE OF FRENCH CREEK RD. & SW CORNER OF FRENCH CREEK EST. SUBD.

13-02744-A

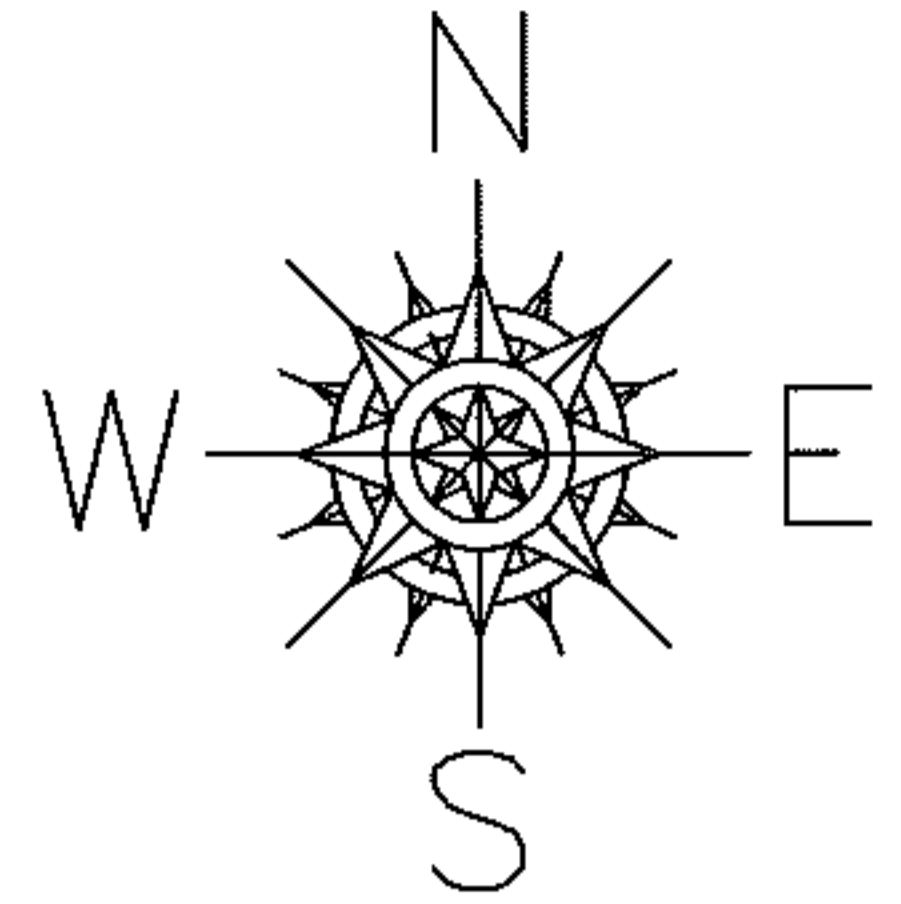

SPLITS/DEEDS PROCESSED
 LORAIN COUNTY TAX MAP DEPARTMENT
 226 MIDDLE AVE. ELYRIA, OHIO

SURVEYED BY: DOUG MOSLEY
 CLOSURE: 0.00 : 10,000
 MAP PAGE(S): 04-00-003-G
 APPROVED BY: JAH DATE: 6-10-2013
 SCALE: 1" = 200 PRIOR INSTRUMENT: 20050072154