

RASTER



PARENT PARCEL: 02-01-003-270-013

CHILD PARCEL: 02-01-003-270-037 THRU -040

STARTING POINT: CENTERLINE OF COOPER FOSTER PK & CHERRYWOOD LN

09-02746

CHERRYWOOD

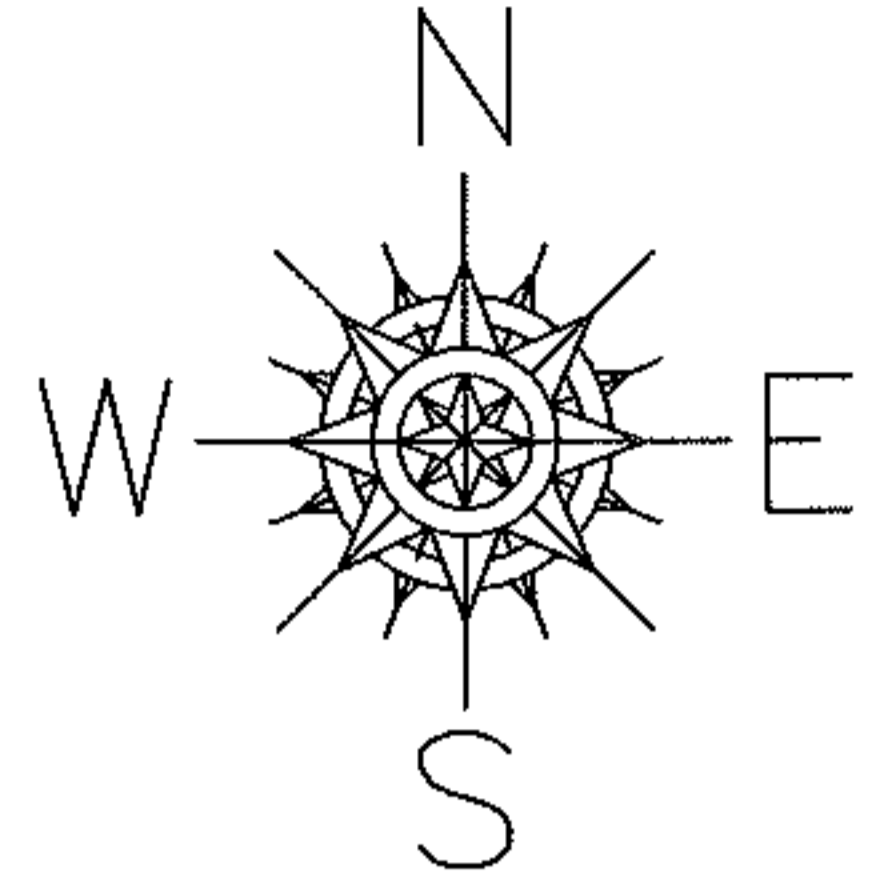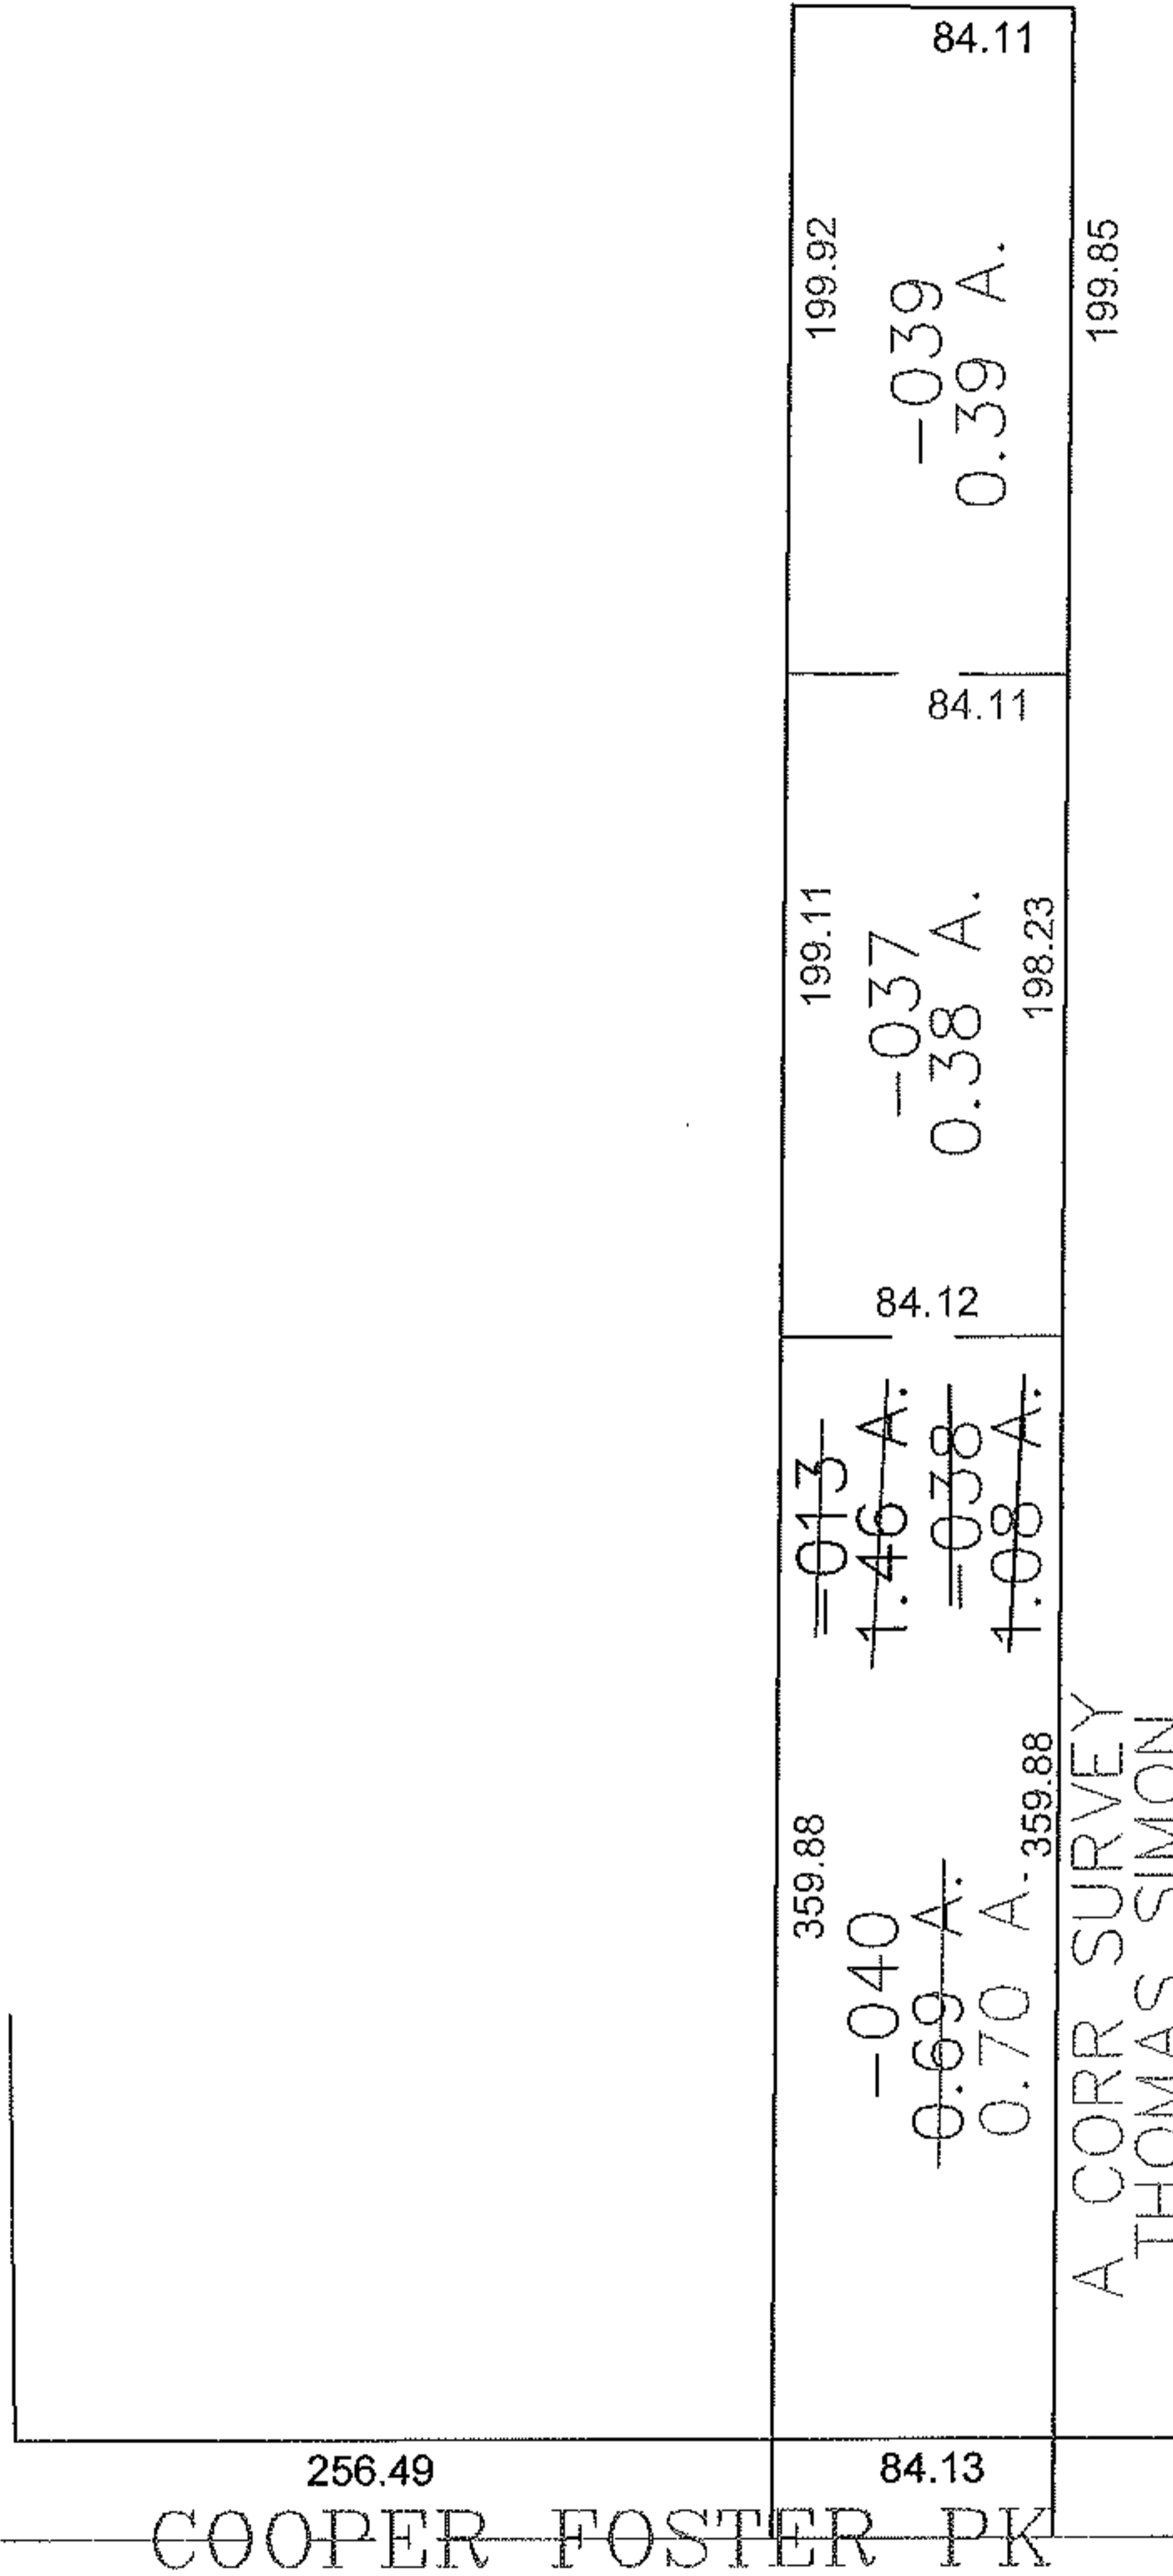

SPLITS/DEEDS PROCESSED

LORAIN COUNTY TAX MAP DEPARTMENT
226 MIDDLE AVE. ELYRIA, OHIO

SURVEYED BY: THOMAS SIMON

CLOSURE: 0.00 : 10.000

MAP PAGE(S): 02-01-003-N

APPROVED BY: JAH DATE: 9-25-09

SCALE: 1" = 100 PRIOR INSTRUMENT: 19920164385