
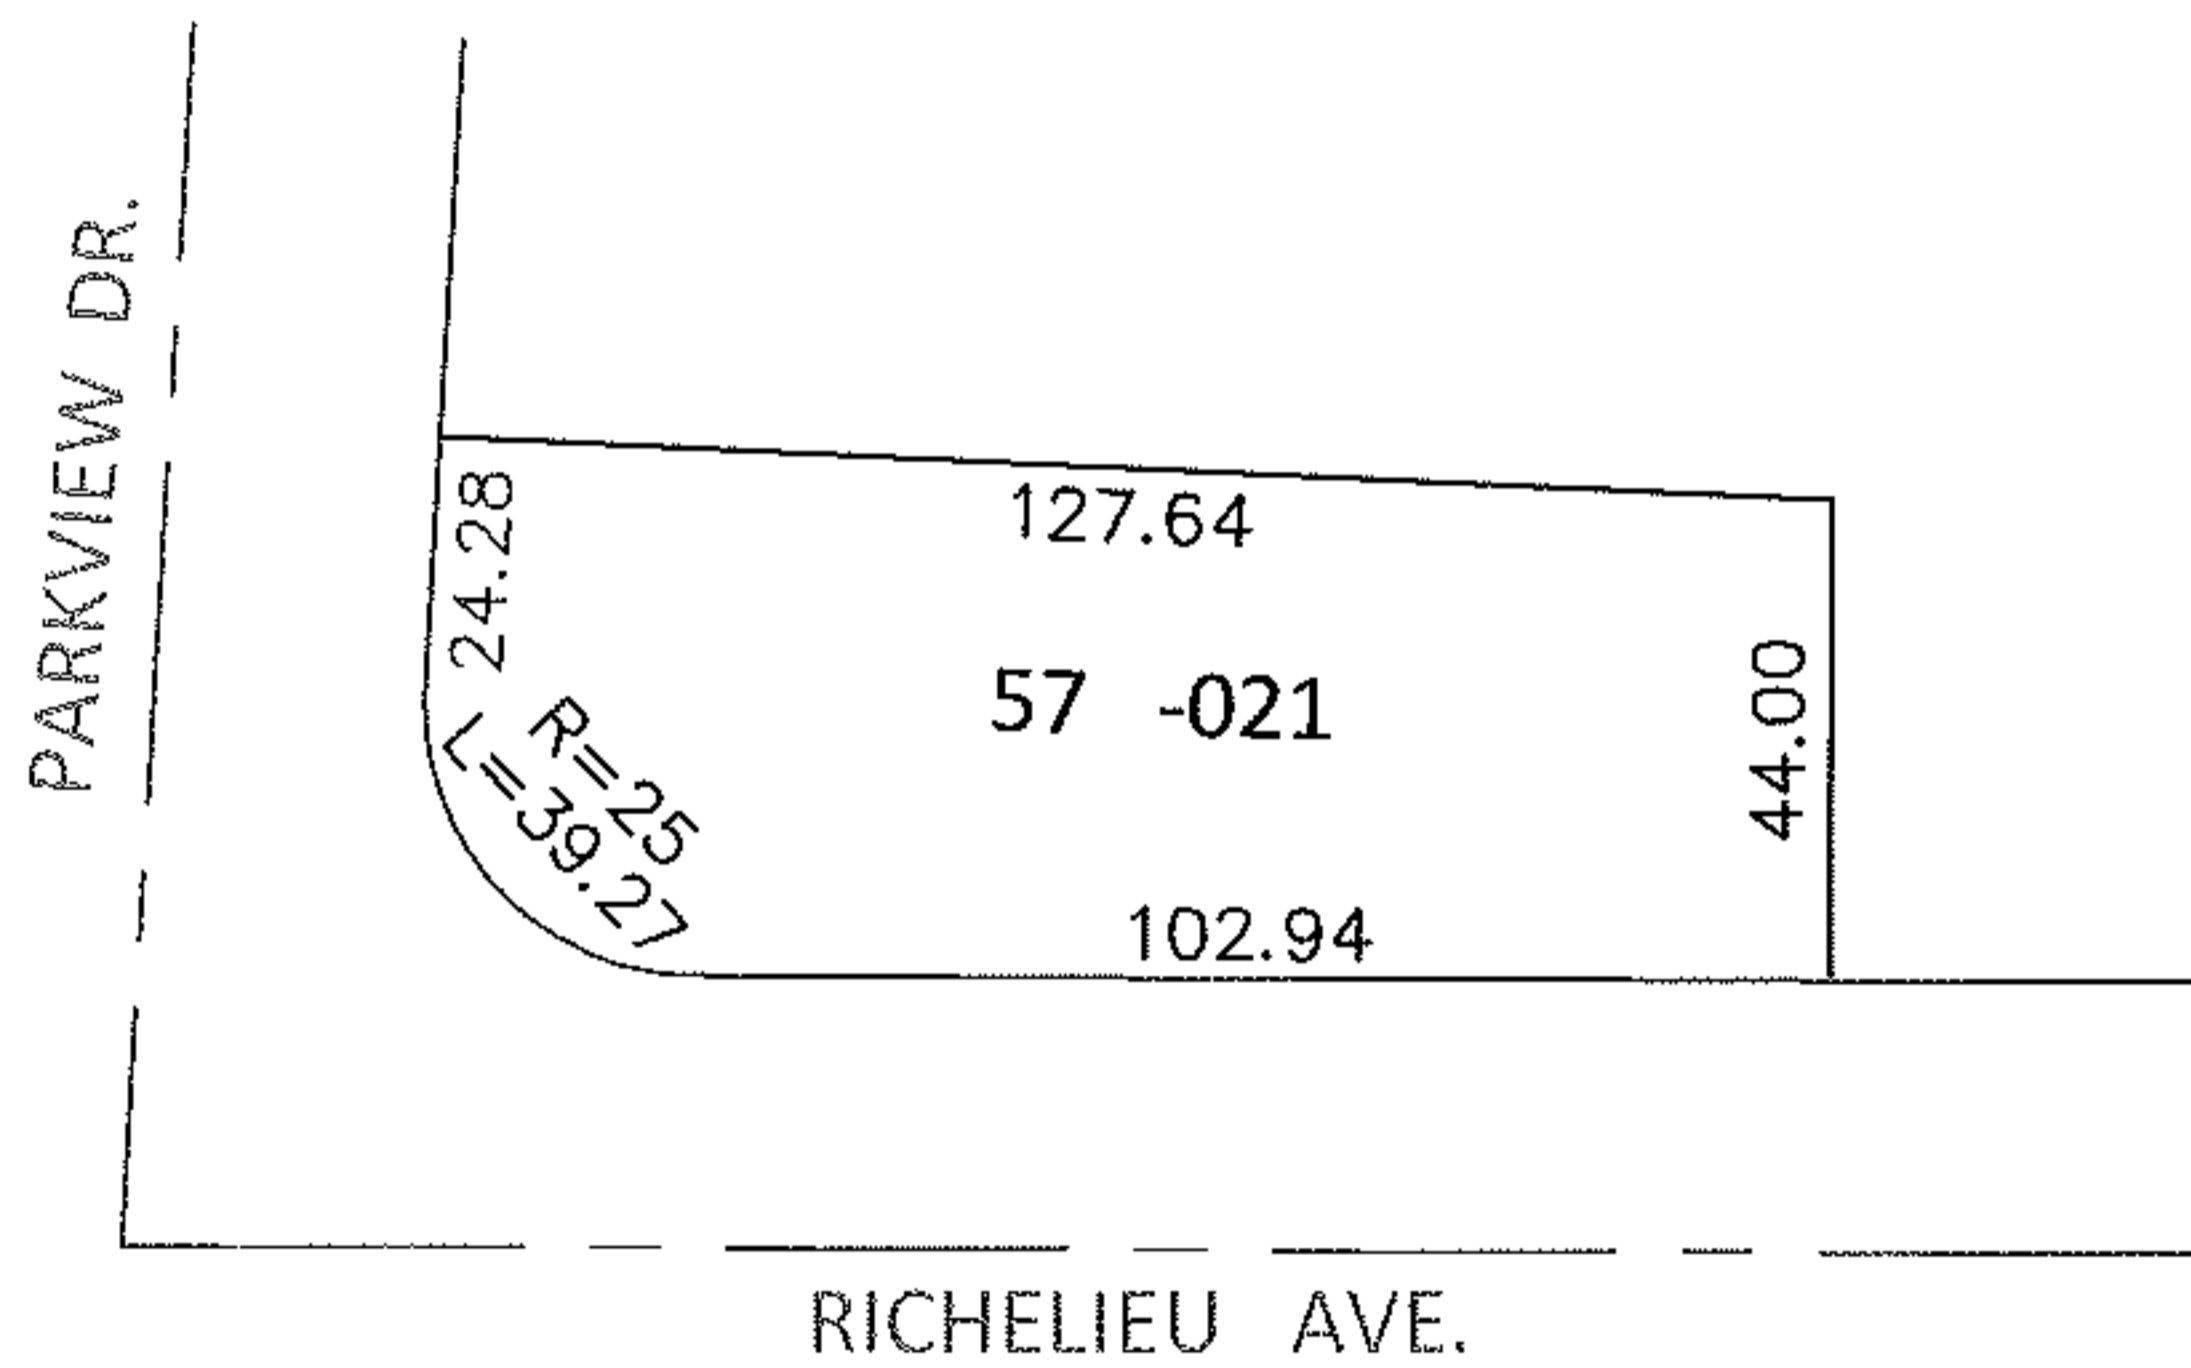


PARENT PARCEL: 03-00-036-122-021

CHILD PARCEL: _____

STARTING POINT: S/L 57 IN BORDER CITIES CO'S SHORE SUB. & BUCKEYE COUNTRY CLUB (VOL.11 PG.13)

13-02748-C

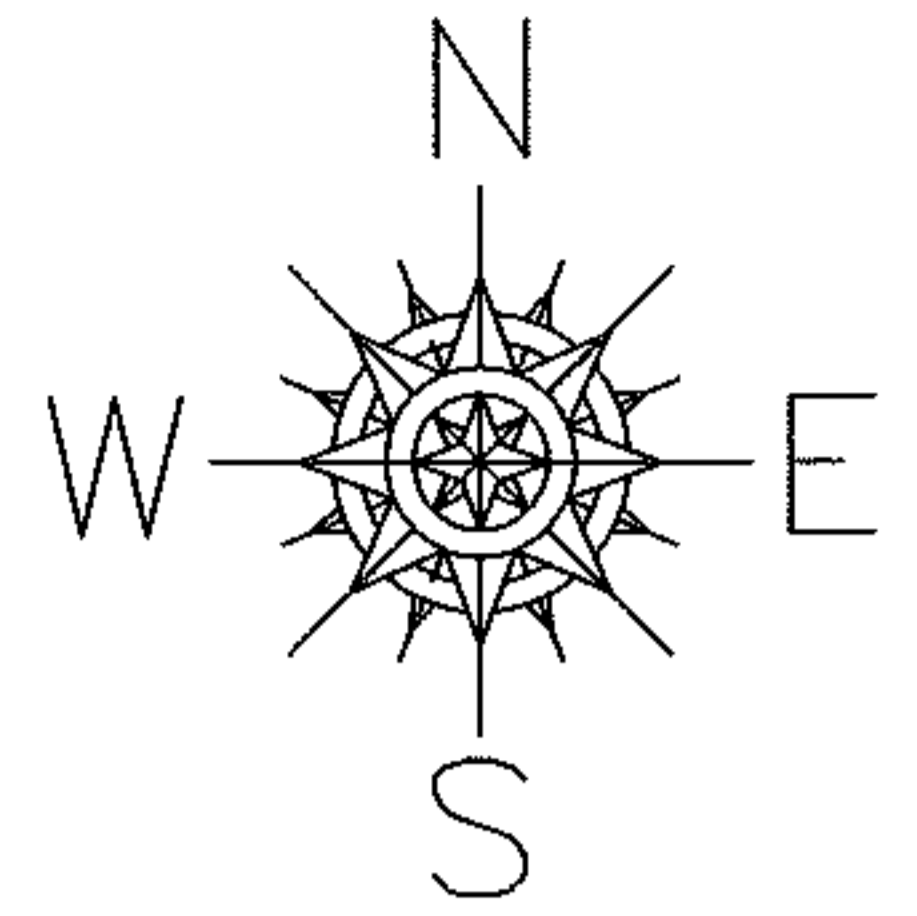


FRONTAGE AND DEPTH CORRECTION

03-00-036-122-021

49.28 X 127.64

~~24.28 X 28~~

CORR. PER PLAT

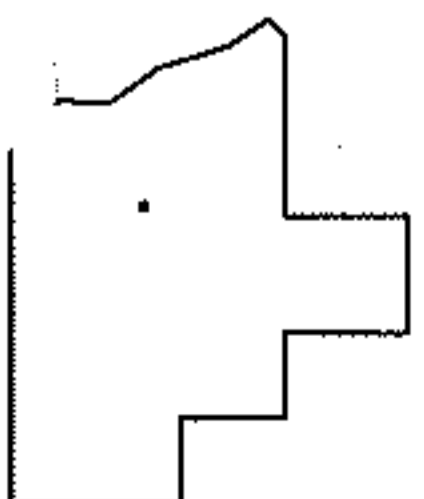

SPLITS/DEEDS PROCESSED

LORAIN COUNTY TAX MAP DEPARTMENT
226 MIDDLE AVE. ELYRIA, OHIO

SURVEYED BY: N/A

CLOSURE: N/A

MAP PAGE(S): 3-00-036-A

APPROVED BY: RRM DATE: 6-19-13

SCALE: 1"= 50' PRIOR INST.: PV 11/13