
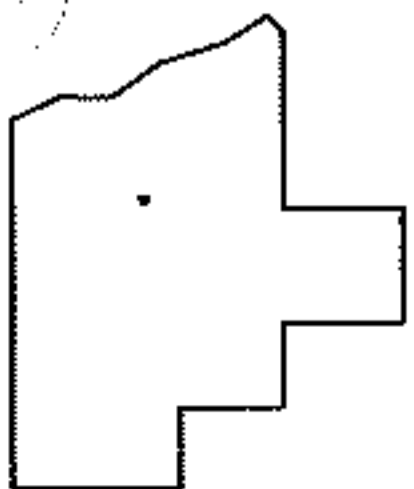
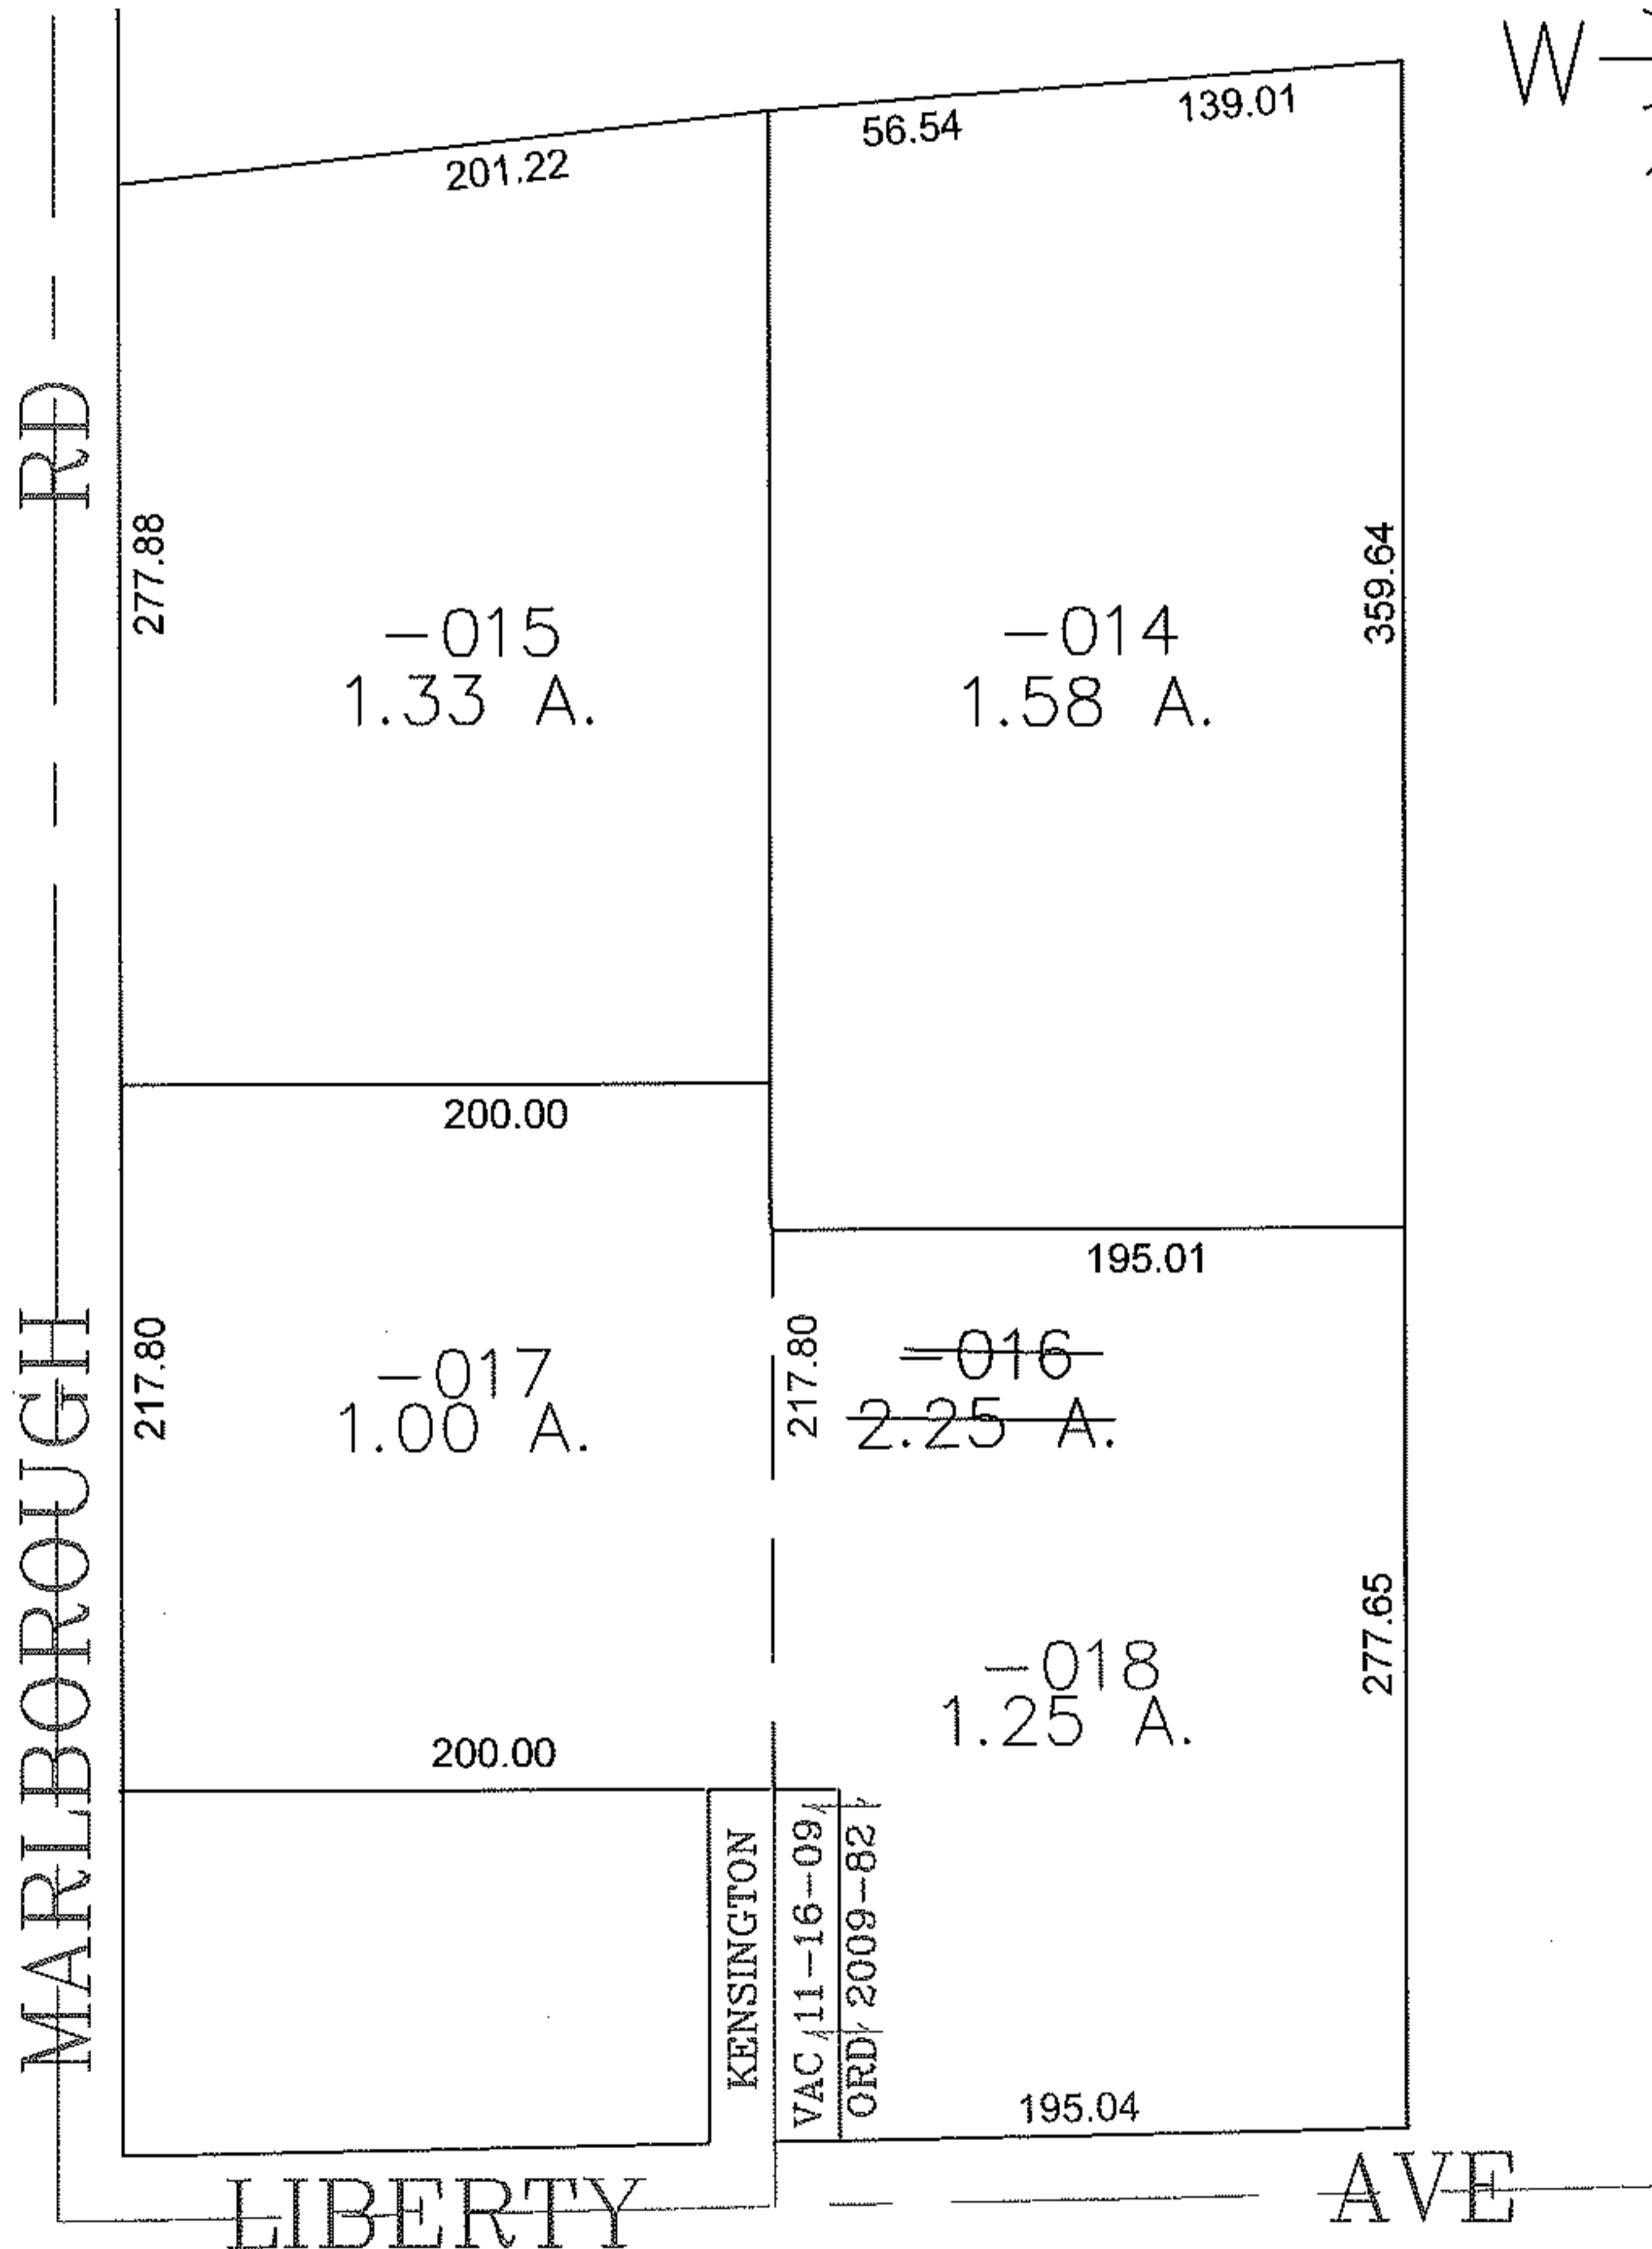


PARENT PARCEL: 01-00-003-122-013

CHILD PARCEL: 01-00-003-122-014 THRU -016

STARTING POINT: CENTERLINE OF KENSINGTON RD & LIBERTY AVE

09-02749

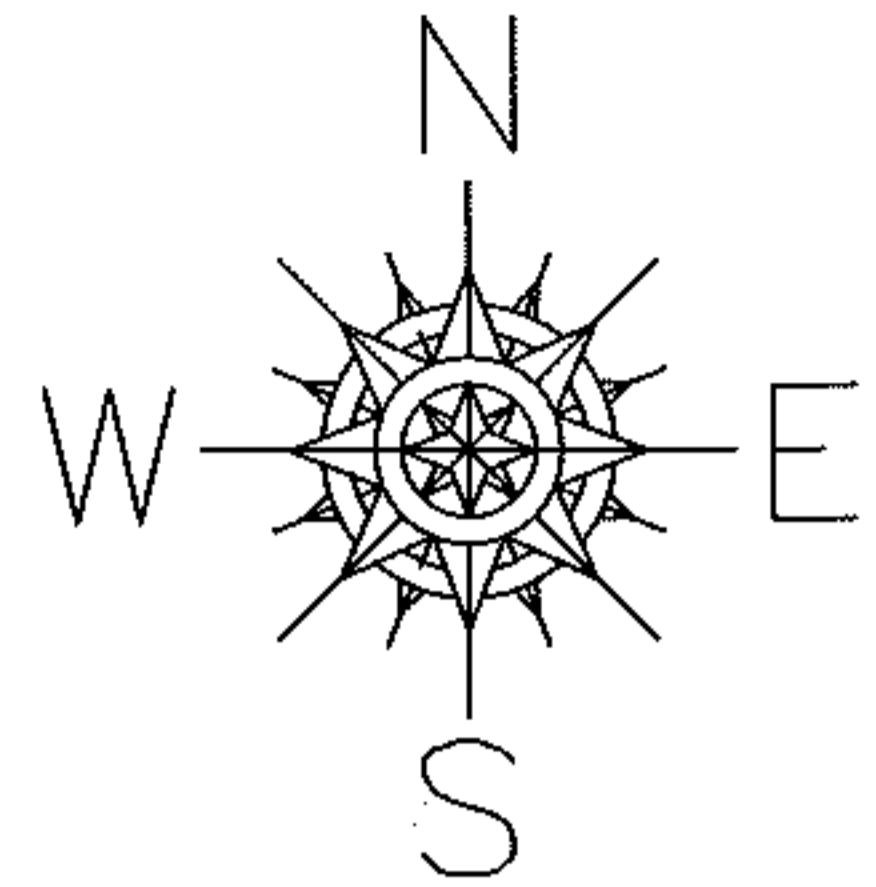

SPLITS/DEEDS PROCESSED

LORAIN COUNTY TAX MAP DEPARTMENT
226 MIDDLE AVE. ELYRIA, OHIO

SURVEYED BY: PHILLIP ROSEBECK
 CLOSURE: 0.00 : 10.000
 MAP PAGE(S): 01-00-003-B
 APPROVED BY: JAH DATE: 9-30-09
 SCALE: 1" = 100' PRIOR INSTRUMENT: 19990598035