
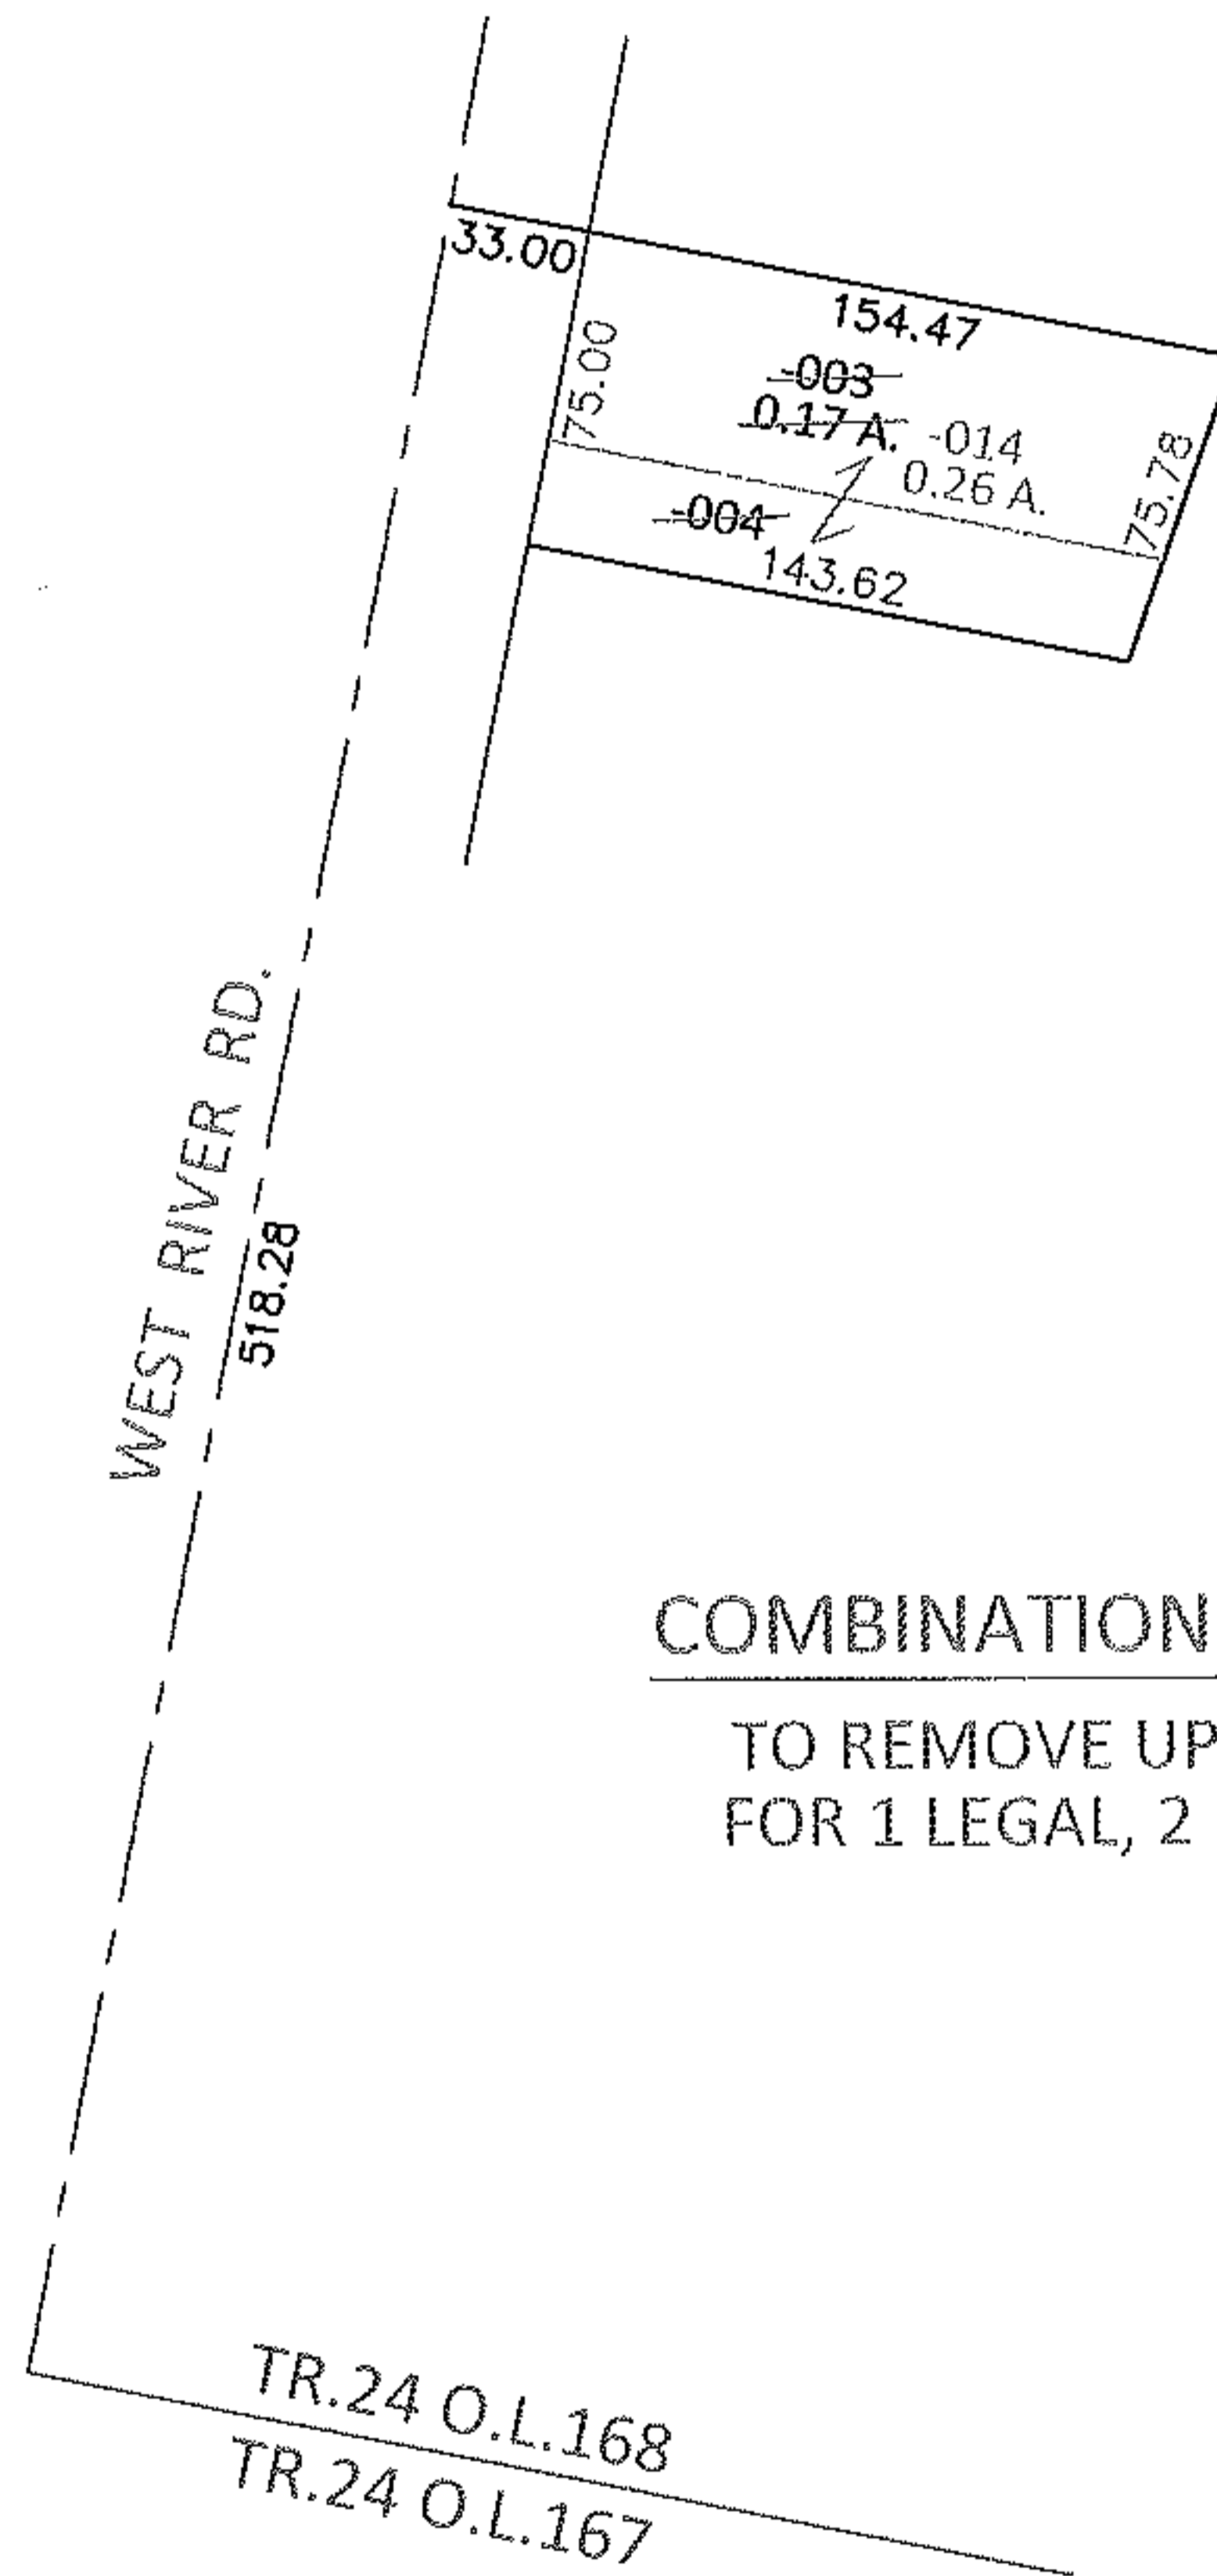


PARENT PARCEL: 06-24-168-000-003, -004

CHILD PARCEL: 06-24-168-000-014


STARTING POINT: SOUTHWEST CORNER OF O.L.168

13-02754-C

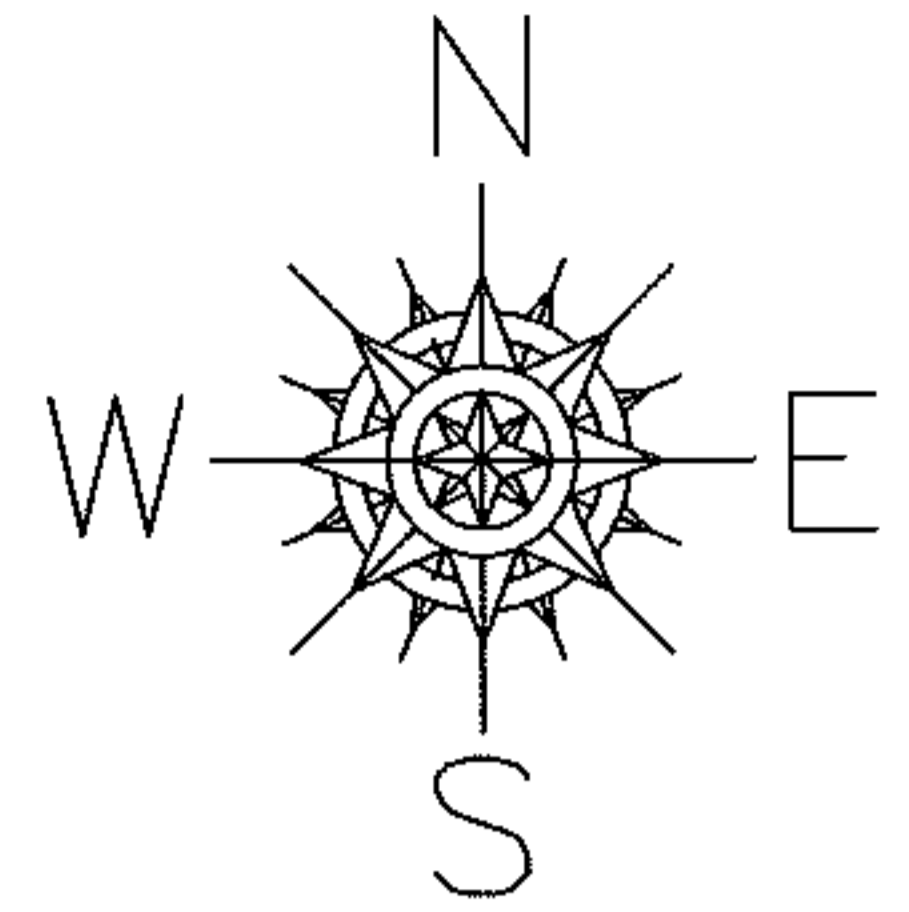

COMBINATION CORRECTION

TO REMOVE UPDATE LEGAL
FOR 1 LEGAL, 2 PARCEL NOS.

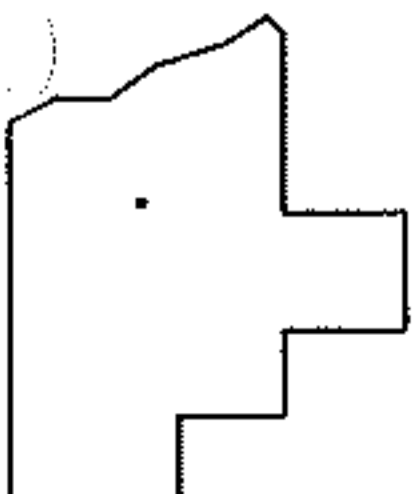

SPLITS/DEEDS PROCESSED

LORAIN COUNTY TAX MAP DEPARTMENT
226 MIDDLE AVE. ELYRIA, OHIO

SURVEYED BY: N/A

CLOSURE: .01:10,000

MAP PAGE(S): 6-84

APPROVED BY: RRM DATE: 7-1-13

SCALE: 1"= 100 PRIOR INST.: 20090308069