




RASTER

PARENT PARCEL: 03-00-107-105-010, -011 03-00-106-102-008

CHILD PARCEL: 03-00-107-105-016 THRU -020

STARTING POINT: CENTERLINE OF ELYRIA AVE & DUNTON RD

09-02756

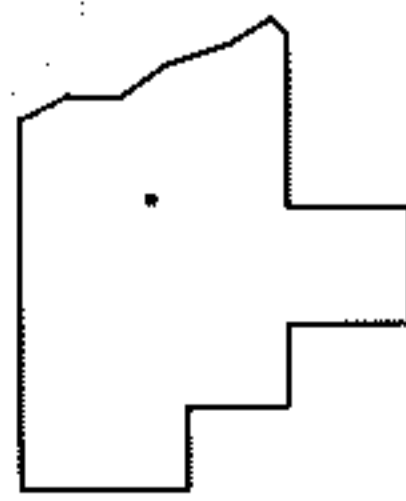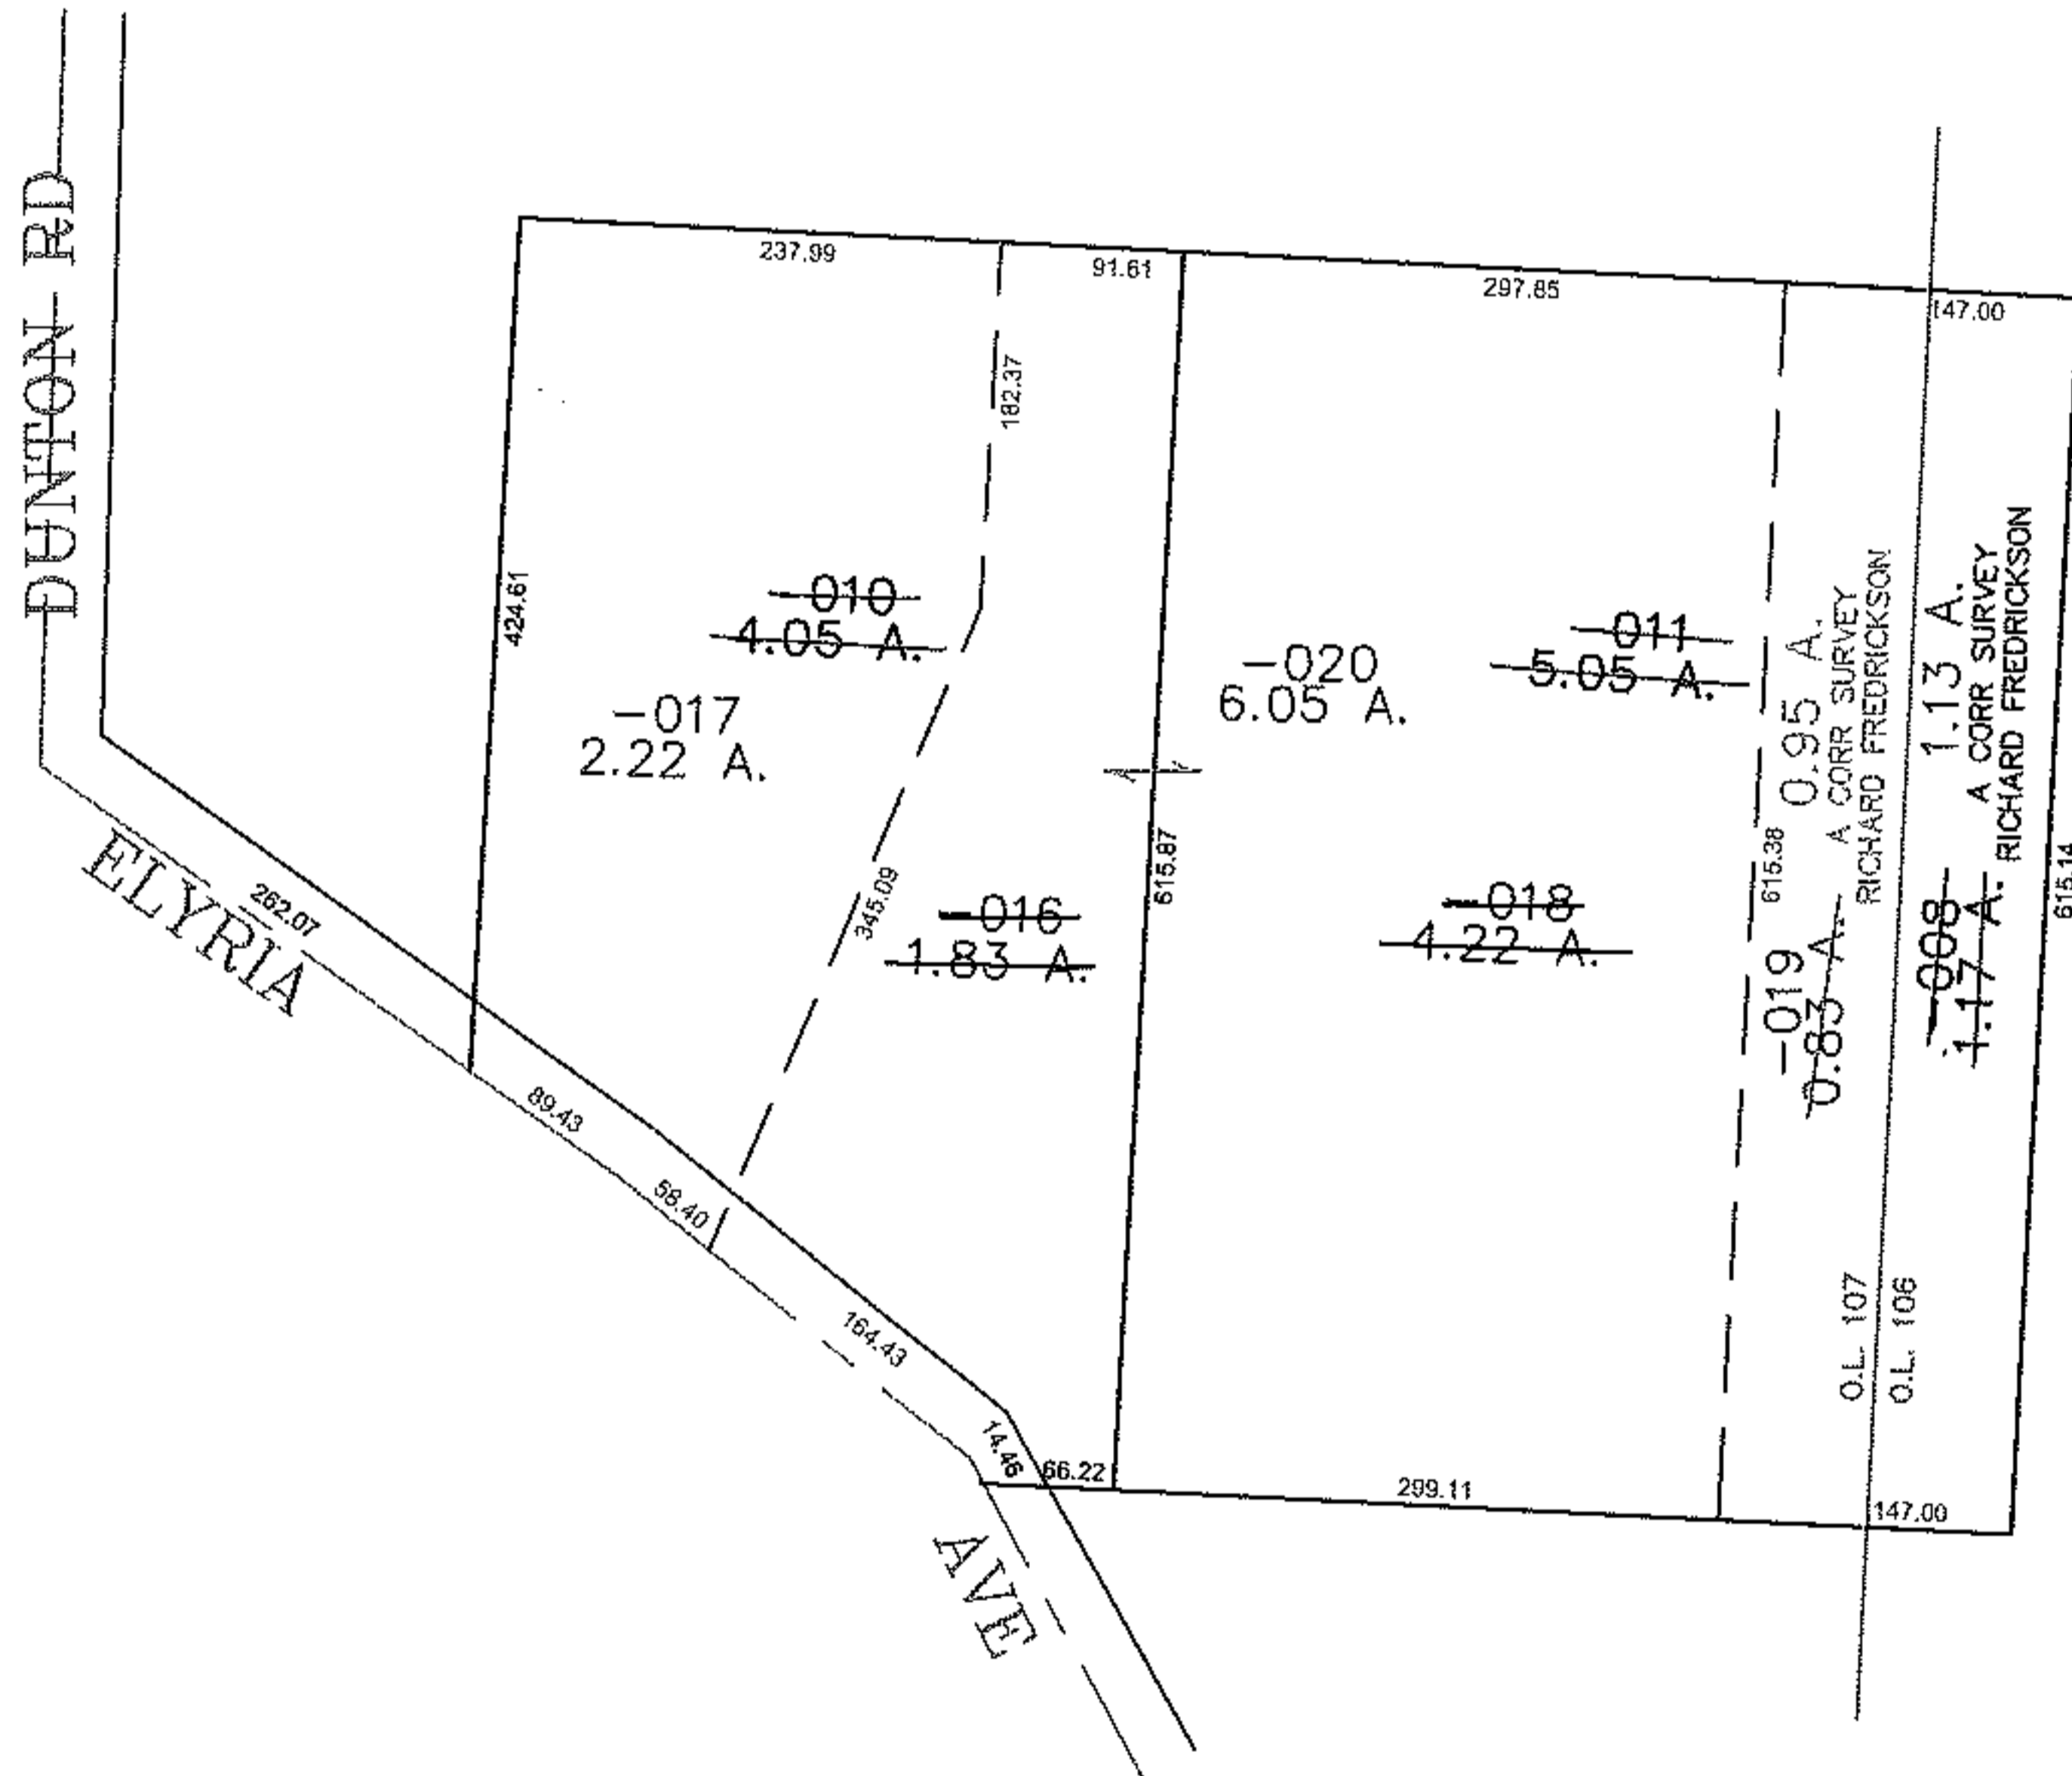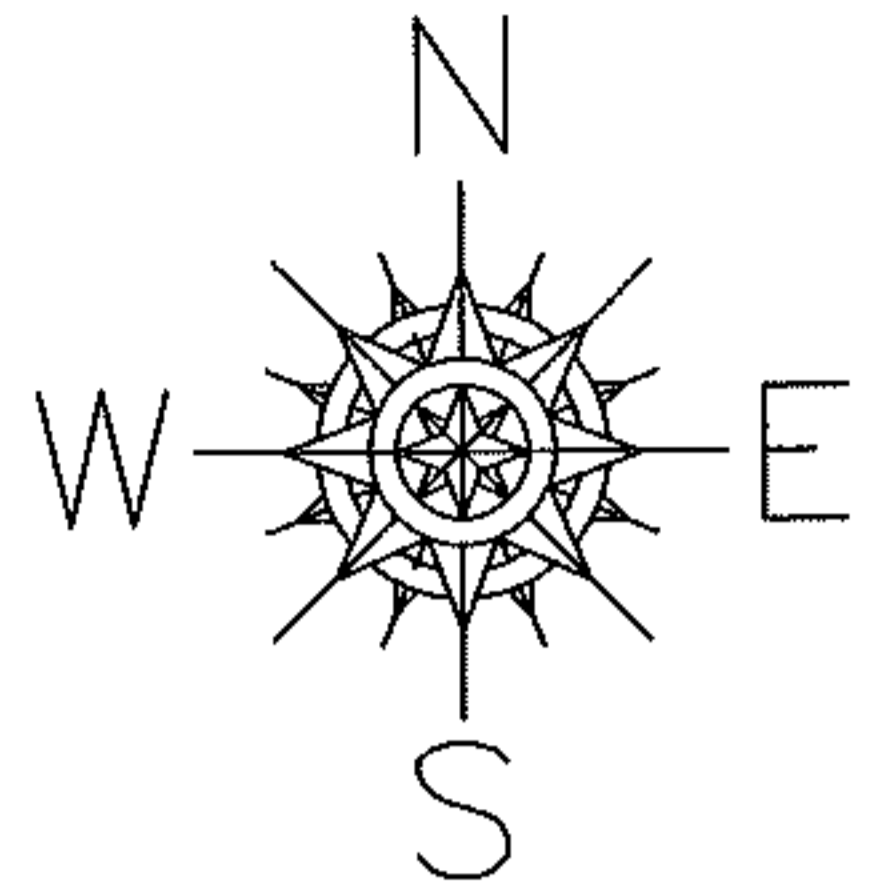

**SPLITS/DEEDS PROCESSED**  
LORAIN COUNTY TAX MAP DEPARTMENT  
226 MIDDLE AVE. ELYRIA, OHIO

SURVEYED BY: RICHARD FREDRICKSON  
CLOSURE: 0.00 : 10.000  
MAP PAGE(S): 03-00-107-B 03-00-106-A  
APPROVED BY: JAH DATE: 10-20-09  
SCALE: 1" = 200 PRIOR INSTRUMENT: 20030916125