

PARENT PARCEL: 10-00-006-108-009

CHILD PARCEL: XX-XX-XXX-XXX-XXX

STARTING POINT:

13-02757-C




ACREAGE CORRECTION

10-00-006-108-009

~~0.73 A.~~

0.75 A.

CORR. PER DEED
INST. # 20020877361

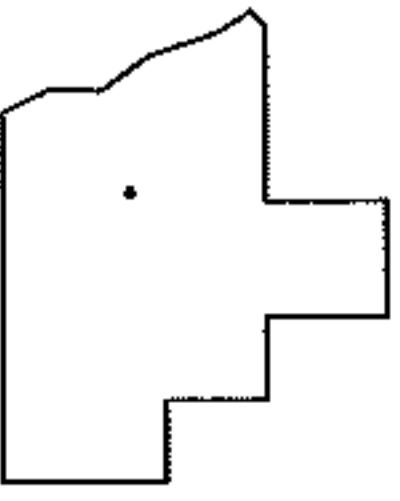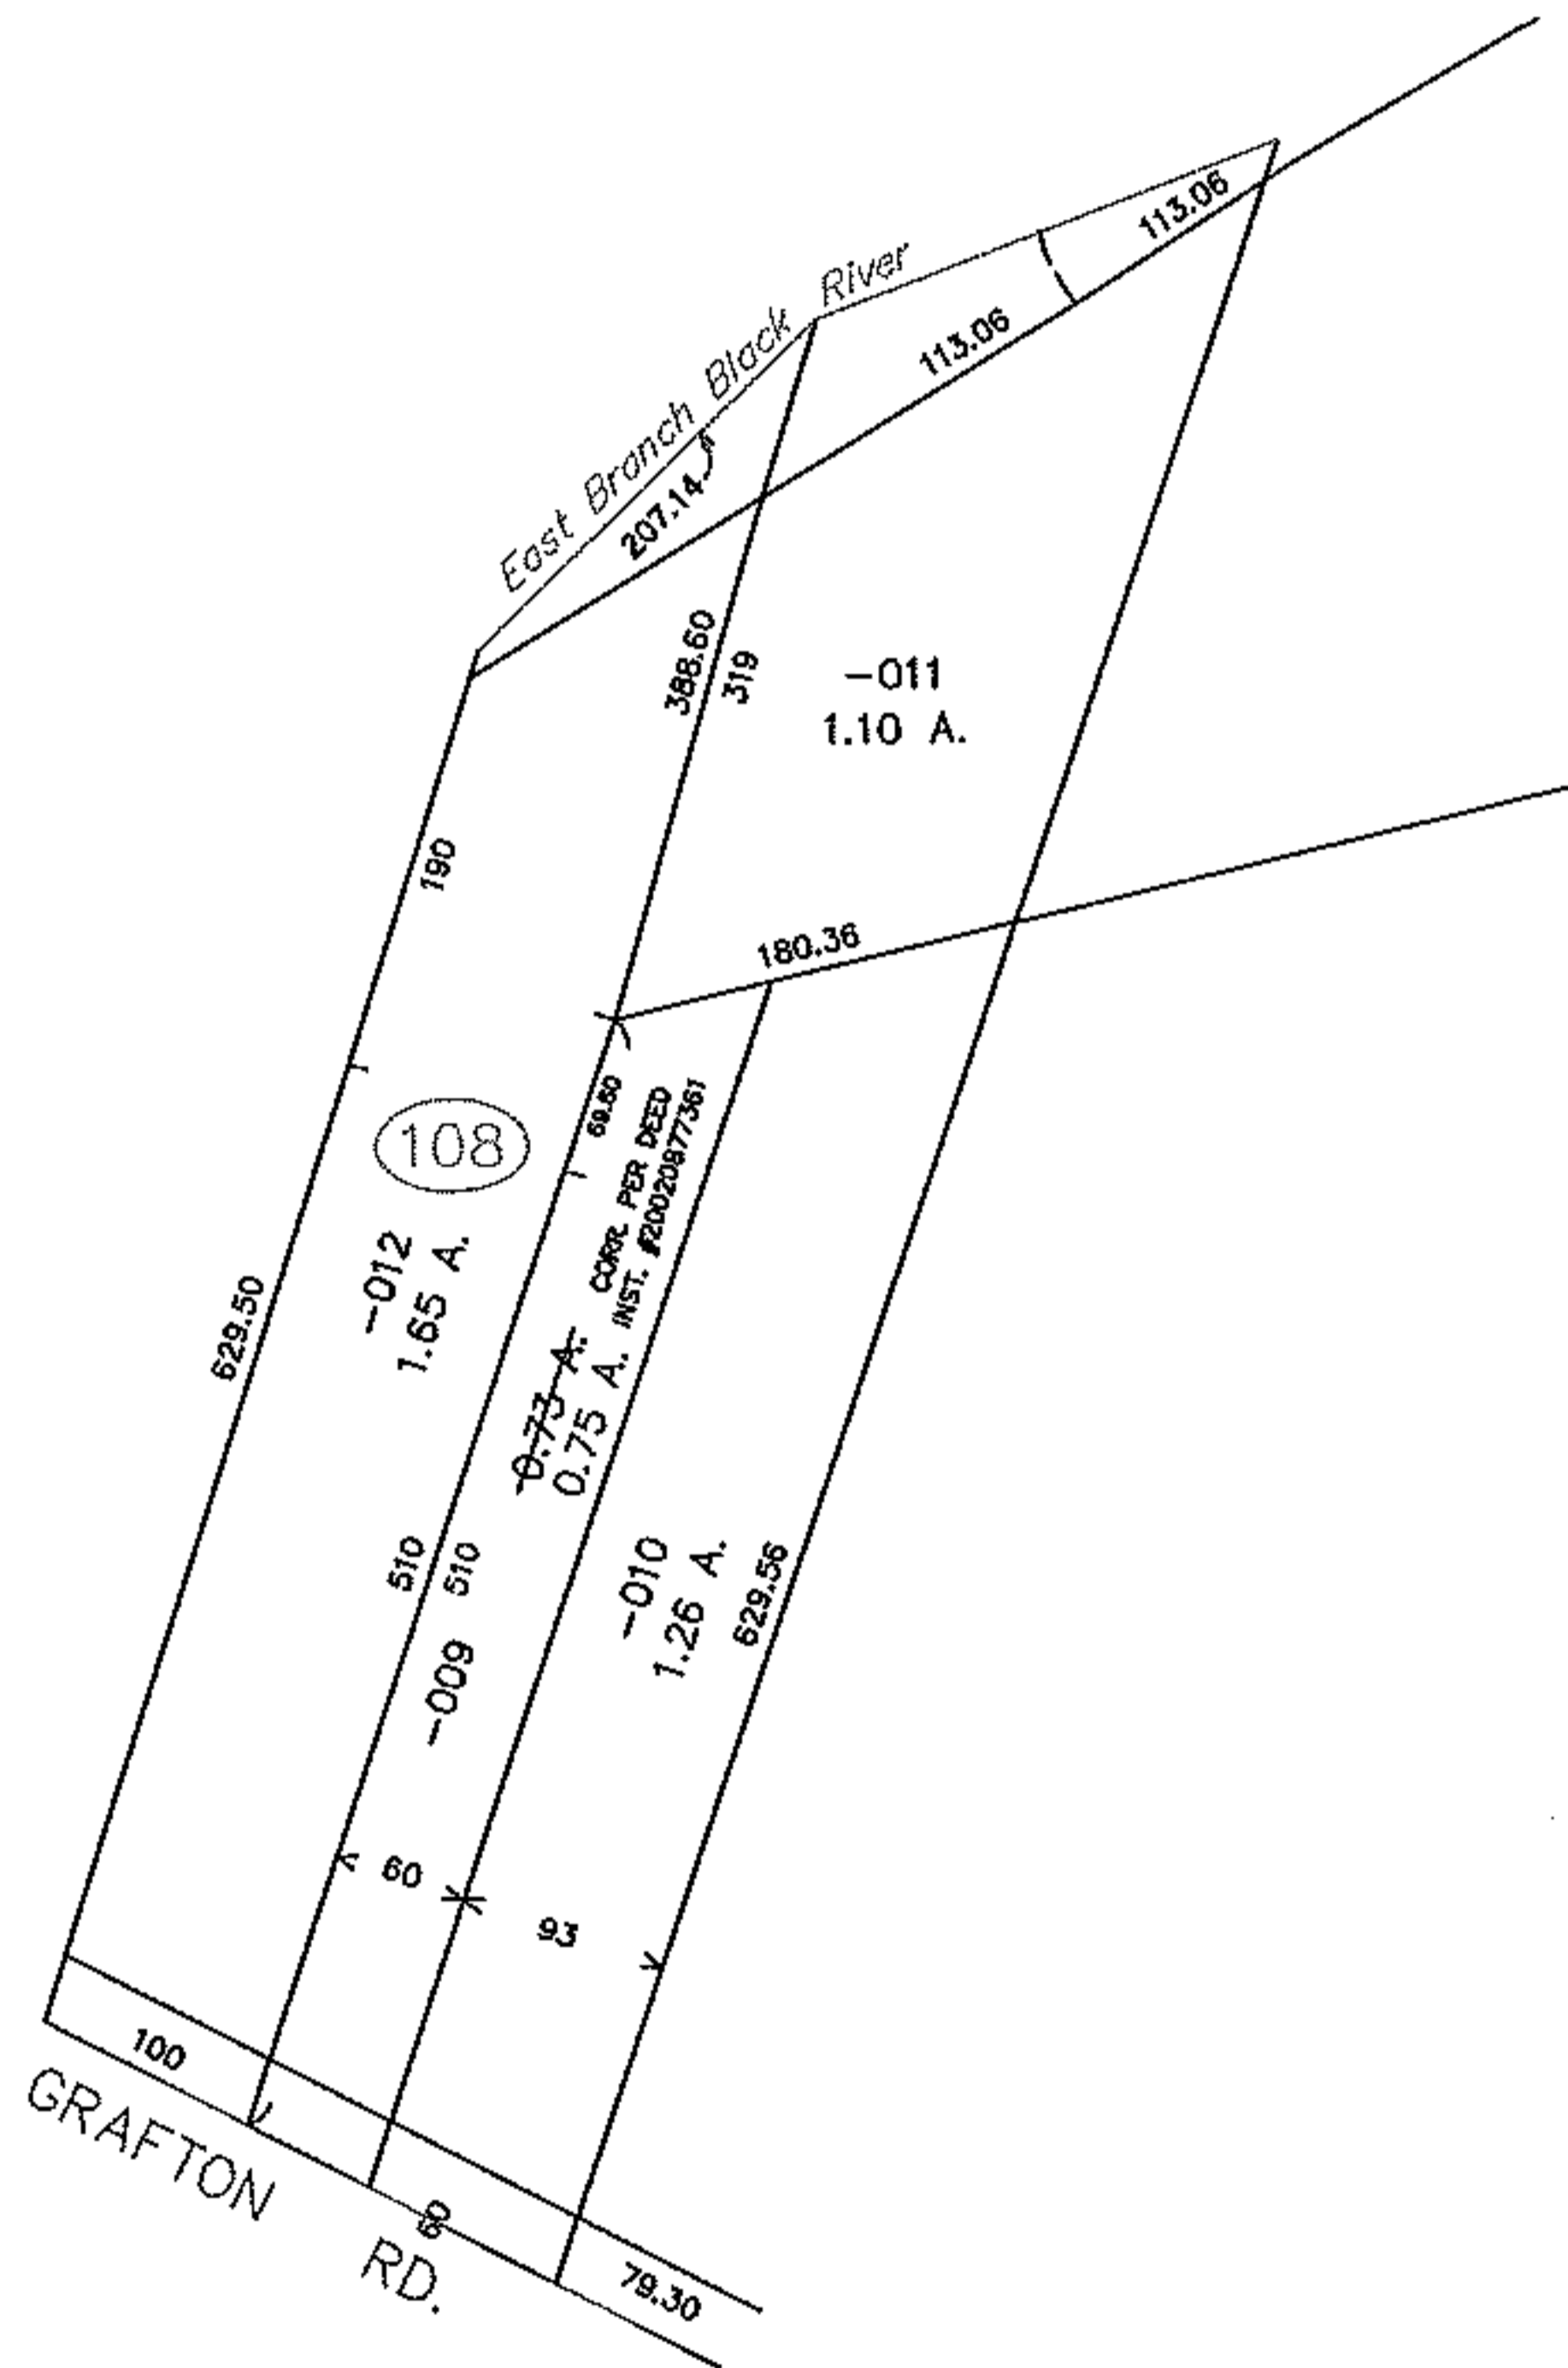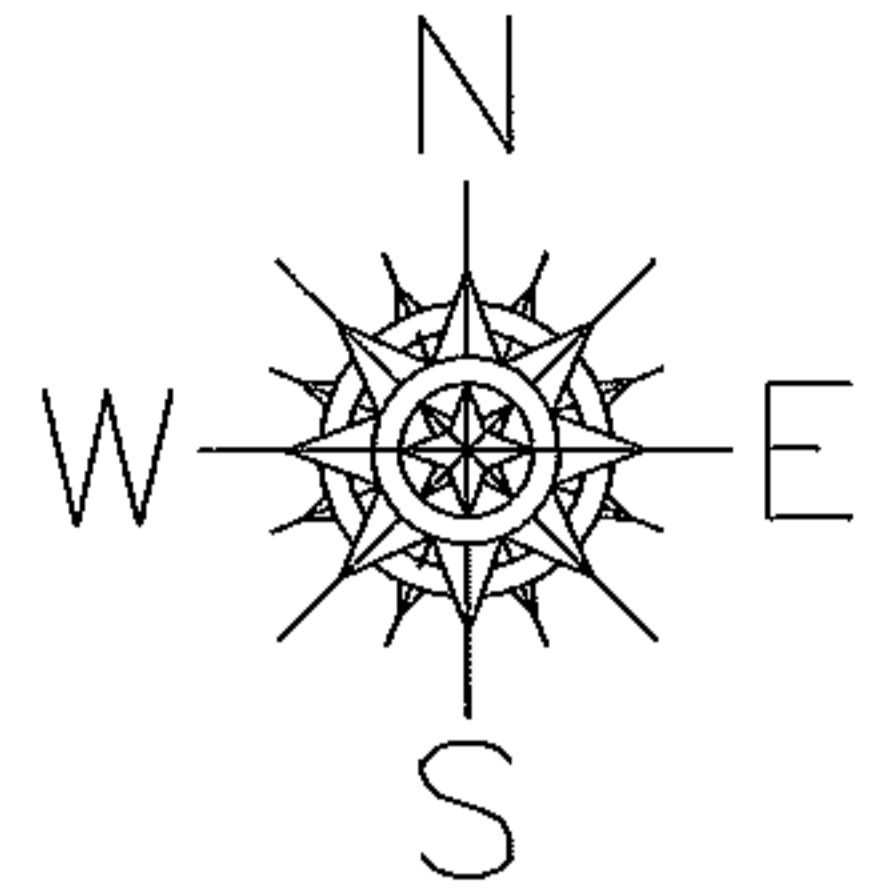

SPLITS/DEEDS PROCESSED

LORAIN COUNTY TAX MAP DEPARTMENT
226 MIDDLE AVE. ELYRIA, OHIO

SURVEYED BY: NONE

CLOSURE: NONE

MAP PAGE(S): 10-00-006

APPROVED BY: TJS DATE: 7/25/13

SCALE: 1" = 200' PRIOR INSTRUMENT: OR 1137/435