
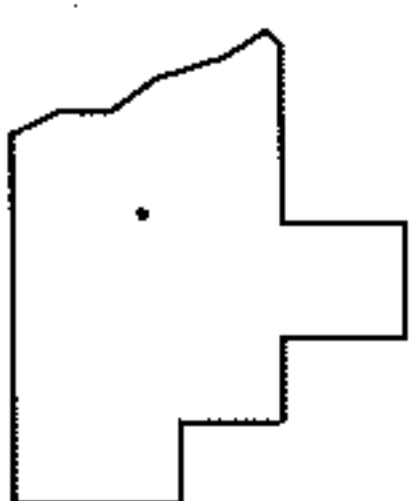
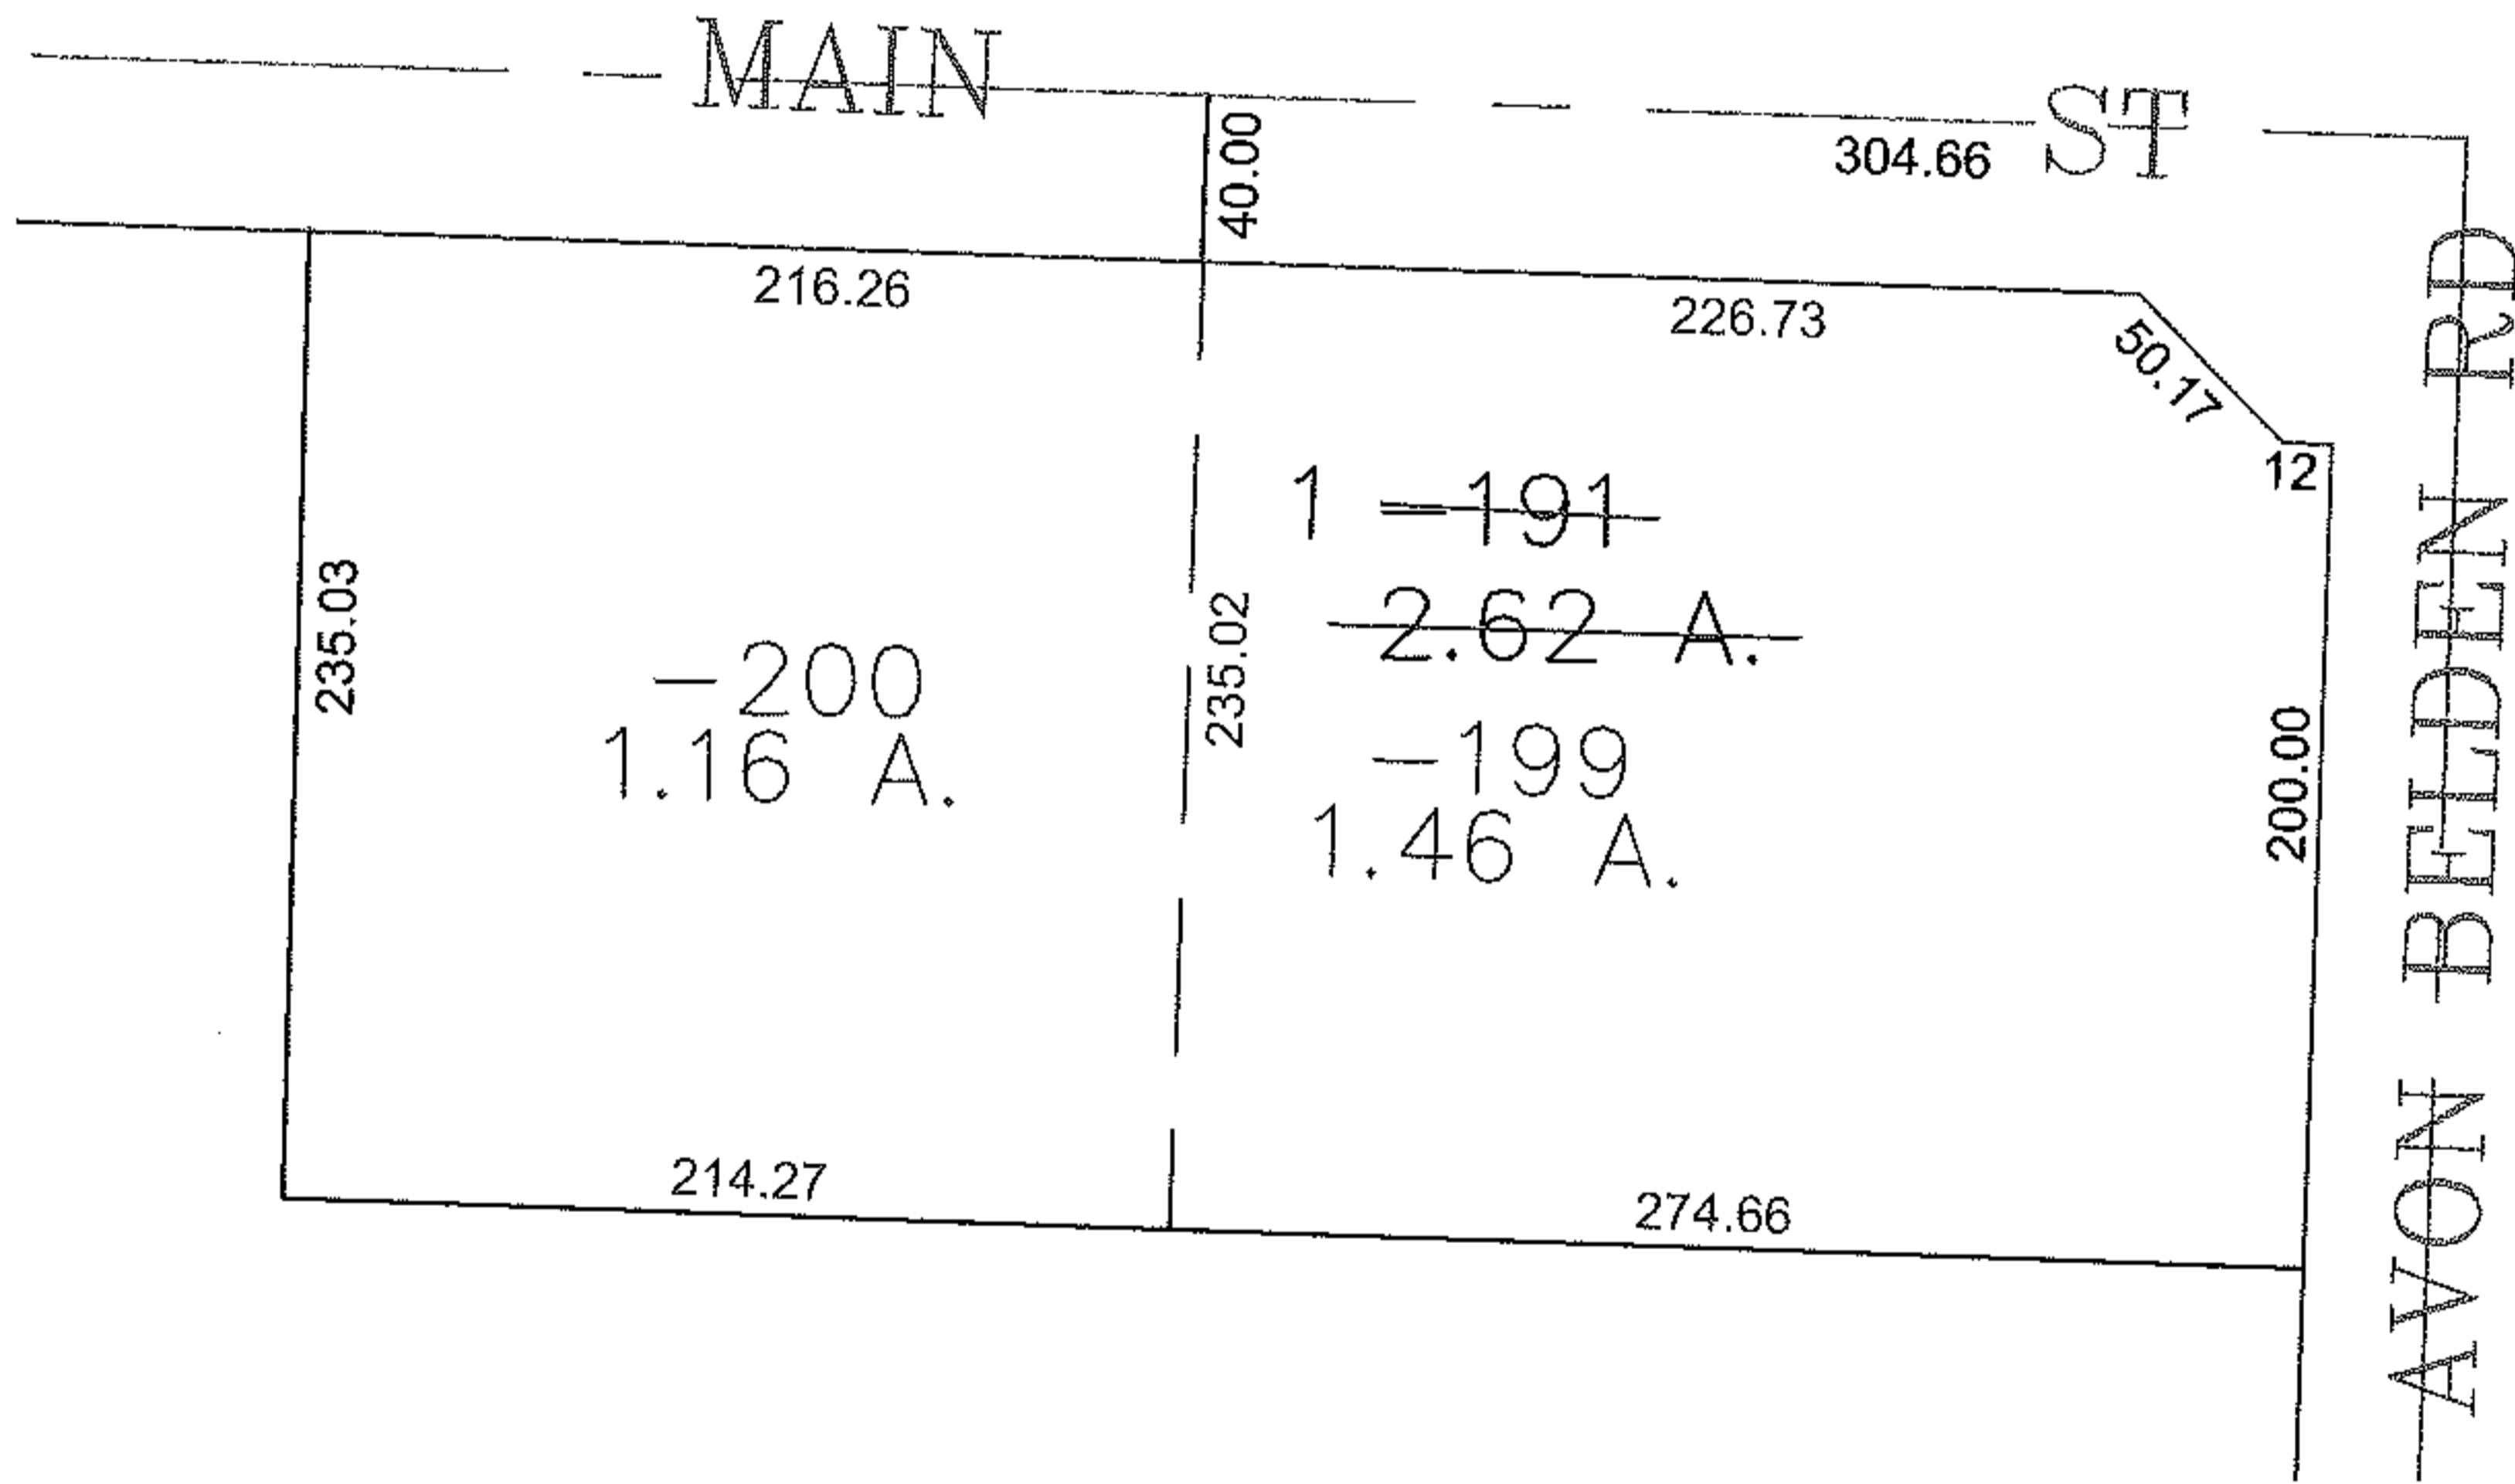


PARENT PARCEL: 04-00-016-101-191

CHILD PARCEL: 04-00-016-101-199, -200

STARTING POINT: CENTERLINE OF MAIN ST & AVON BELDEN RD

09-02763

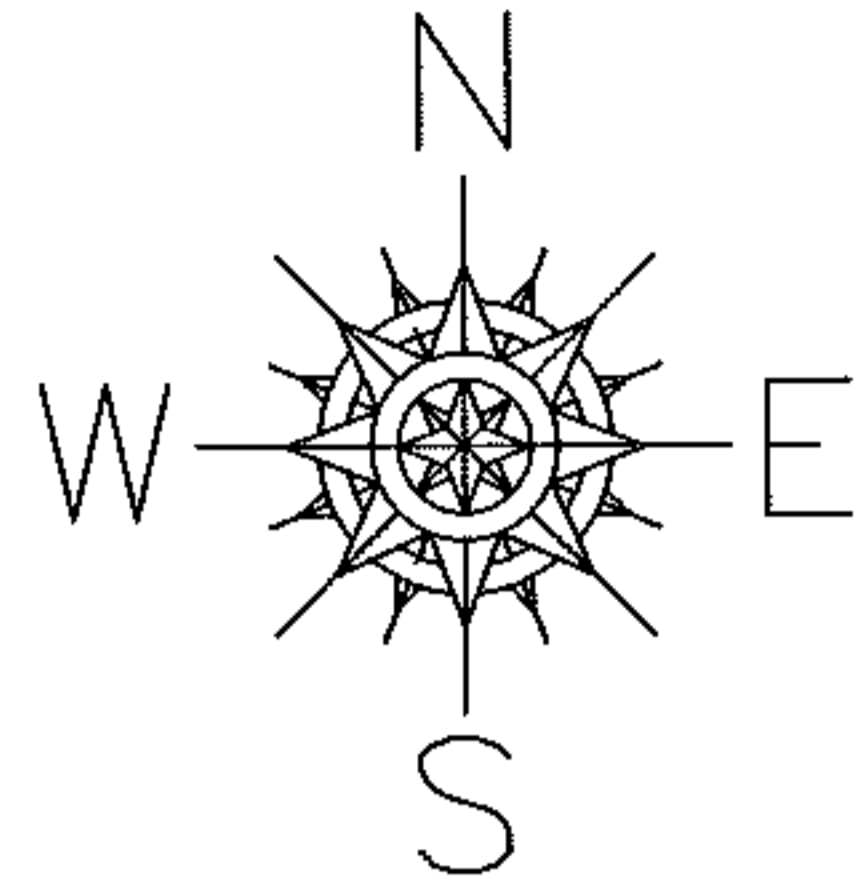

SPLITS/DEEDS PROCESSED

LORAIN COUNTY TAX MAP DEPARTMENT
226 MIDDLE AVE. ELYRIA, OHIO

SURVEYED BY: MICHAEL BRAMHALL
 CLOSURE: 0.00 : 10,000
 MAP PAGE(S): 04-00-016-F
 APPROVED BY: JAH DATE: 11-5-09
 SCALE: 1" = 100' PRIOR INSTRUMENT: 20030919223