
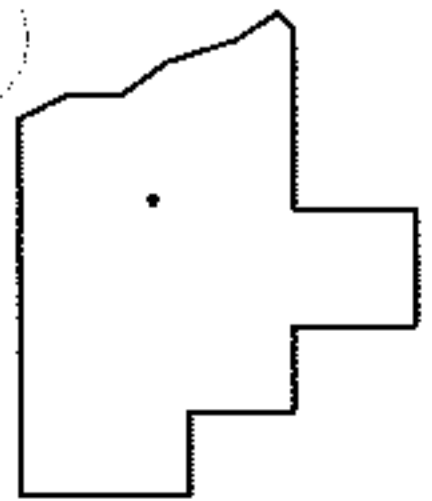
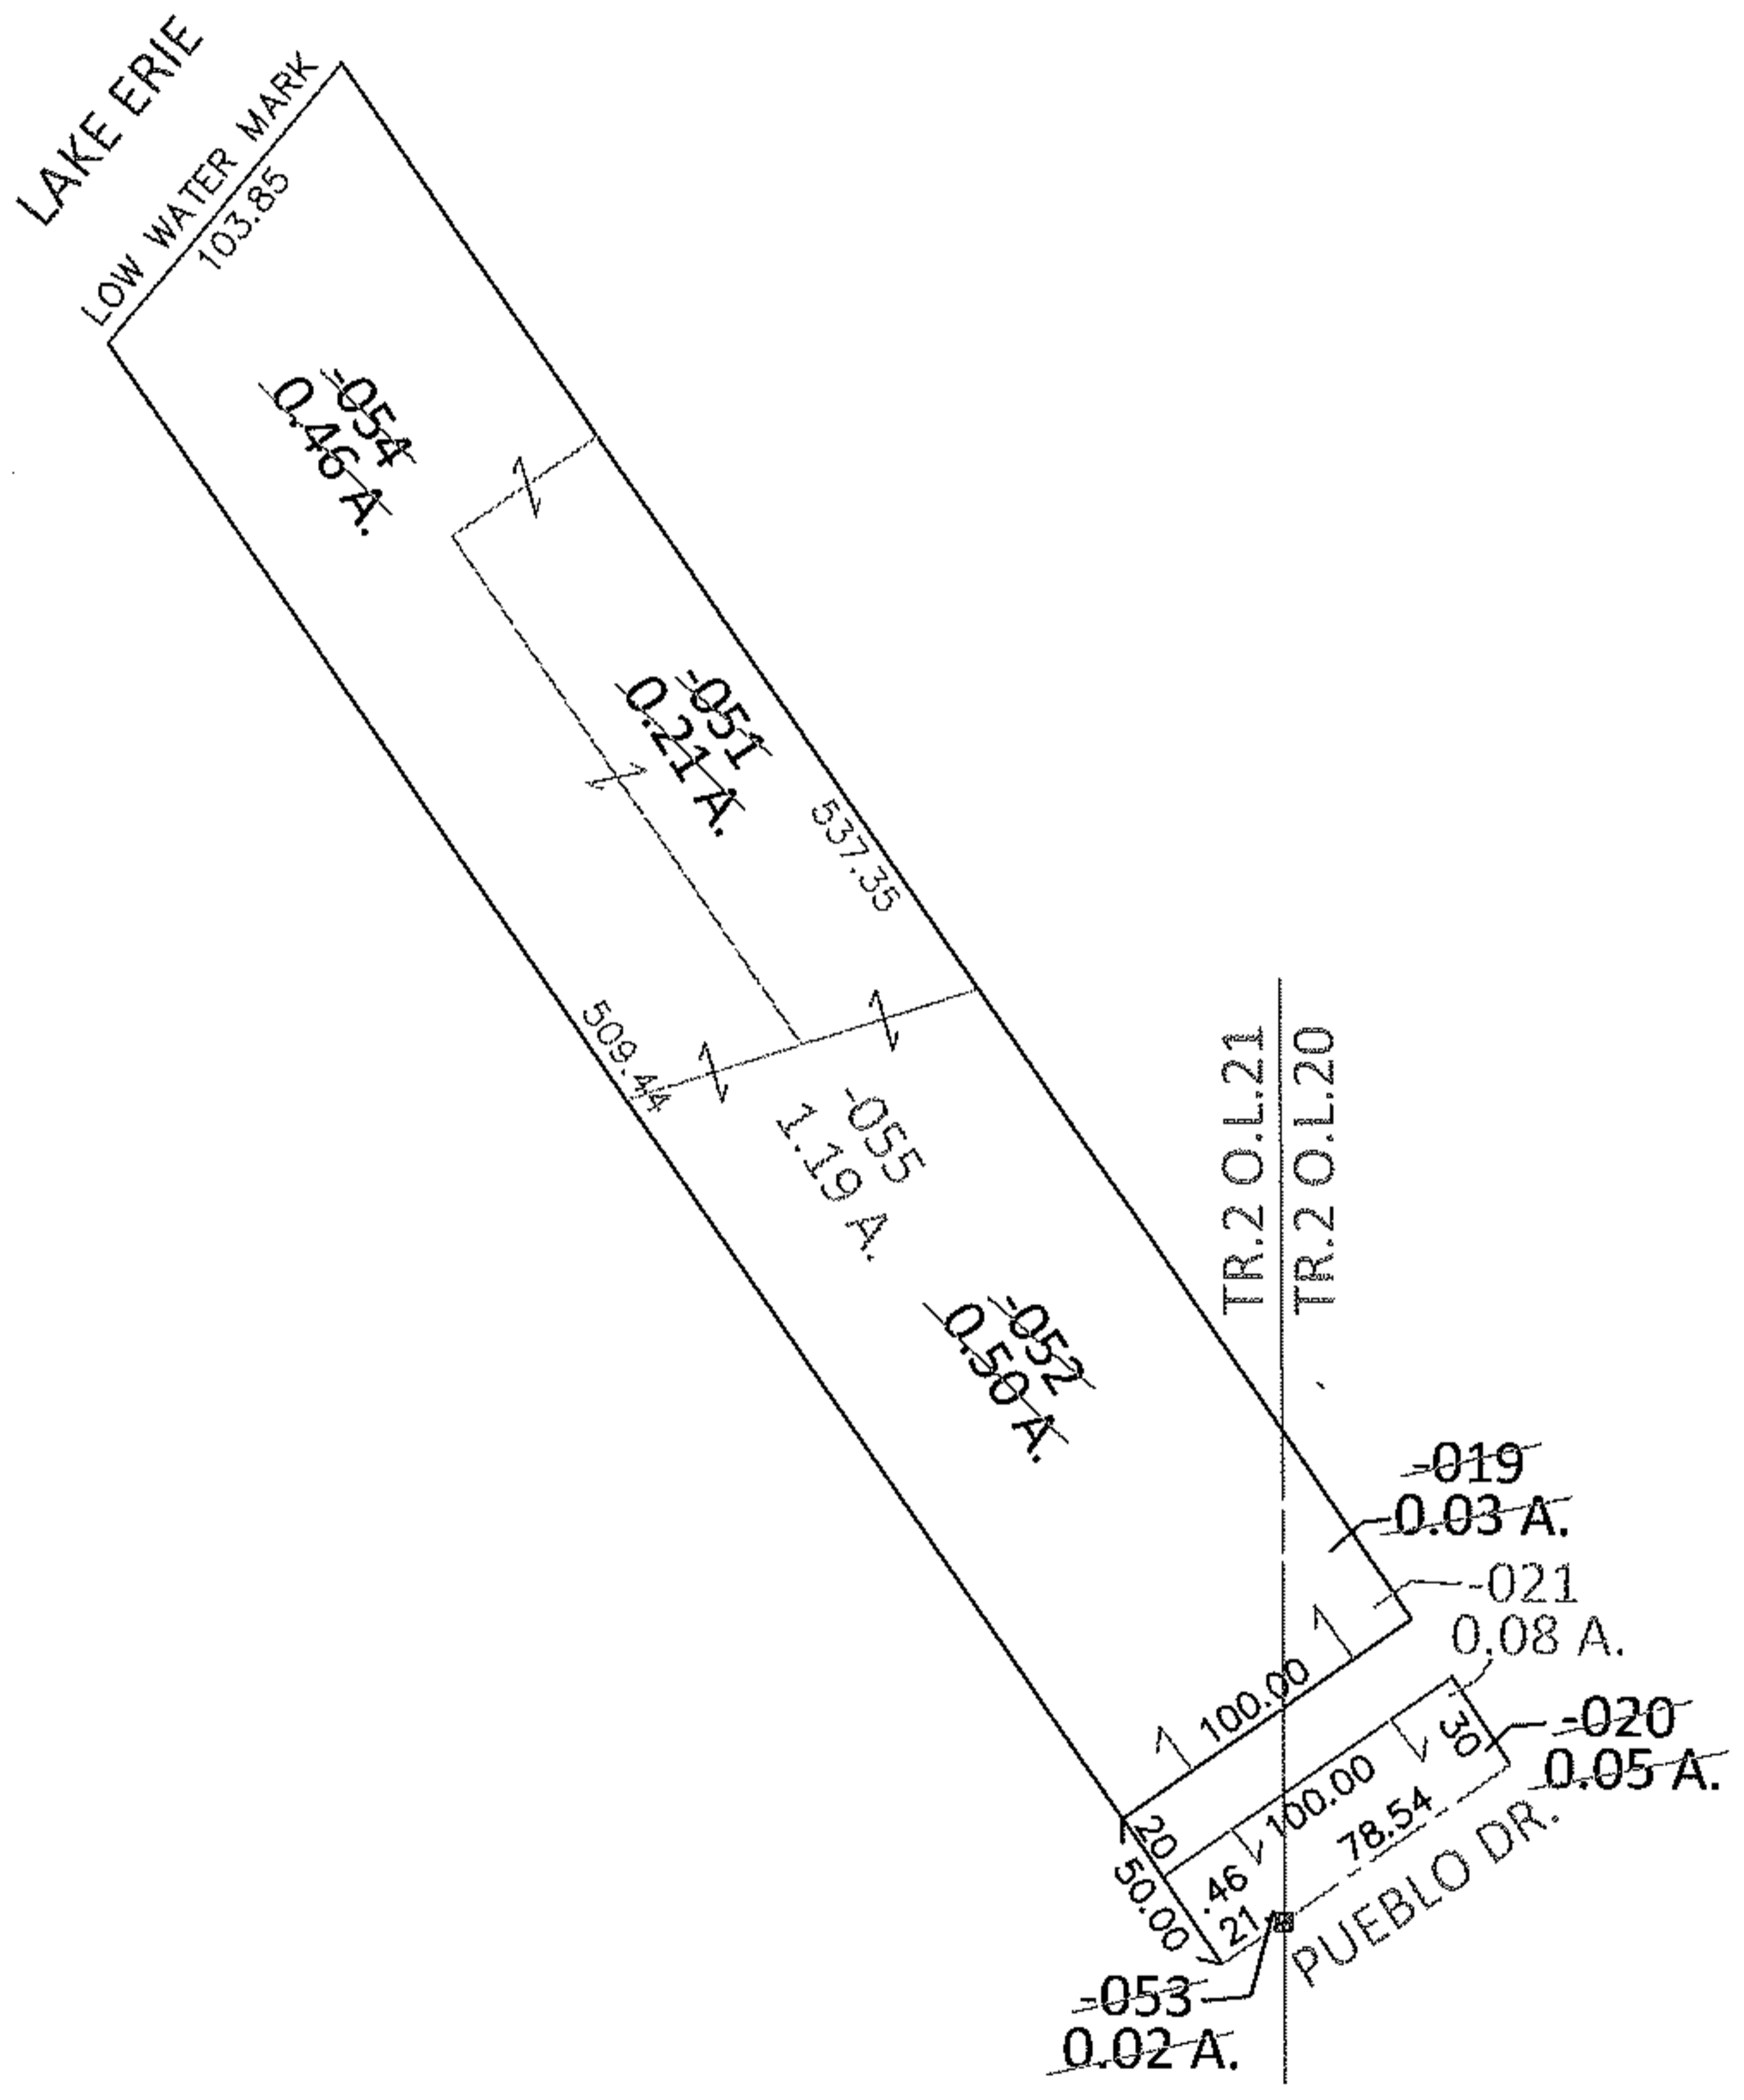


PARENT PARCEL: 02-02-021-101-051 THRU -054, 02-02-020-102-019, -020

CHILD PARCEL: 02-02-021-101-055, 02-02-020-102-021

13-02768-C

STARTING POINT: INTERSECTION OF C/L OF PUEBLO DR. AND WEST LINE OF O.L.20

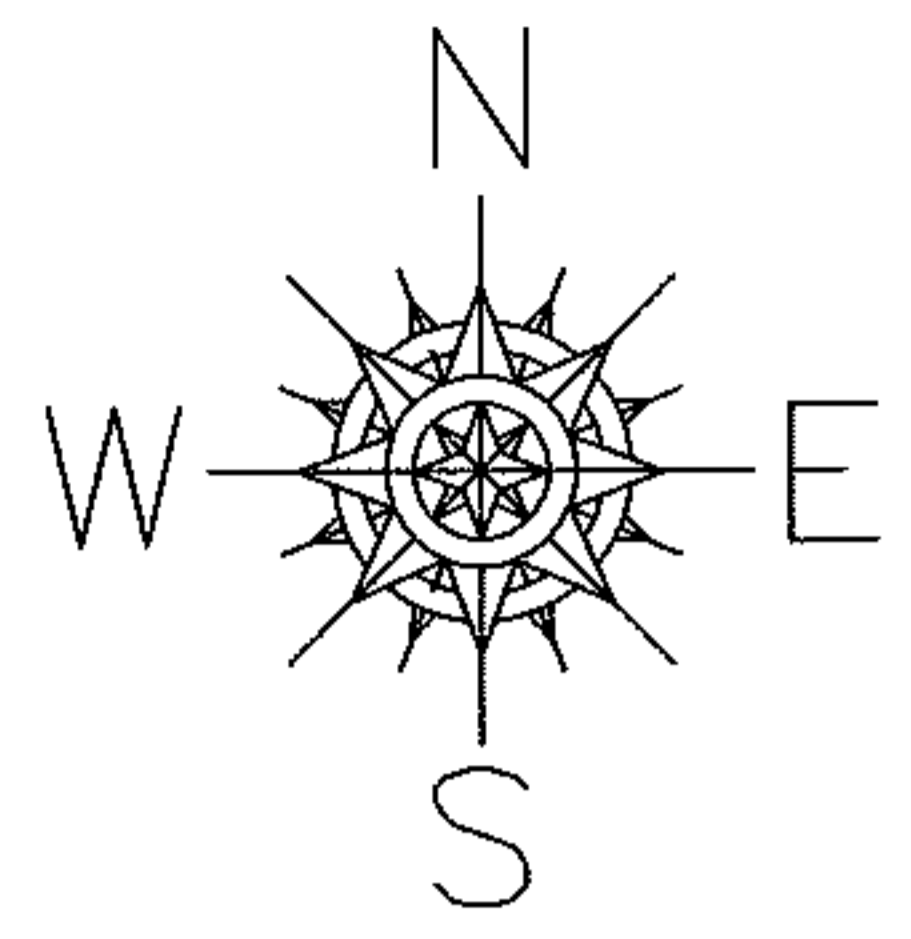

SPLITS/DEEDS PROCESSED

LORAIN COUNTY TAX MAP DEPARTMENT
226 MIDDLE AVE. ELYRIA, OHIO

SURVEYED BY:	AMY M. KELLY
CLOSURE:	.01:10,000
MAP PAGE(S):	2-02-021-B
APPROVED BY:	RRM DATE: 7-24-13
SCALE:	1" = 100 PRIOR INST.: 20060145506