
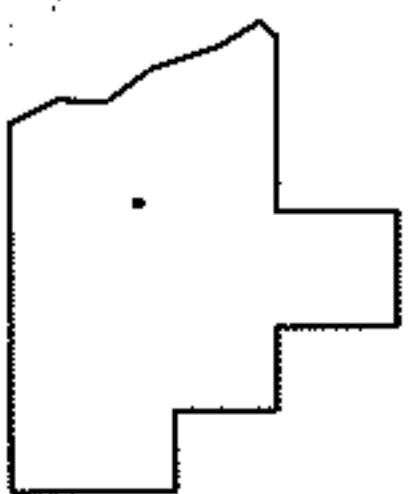
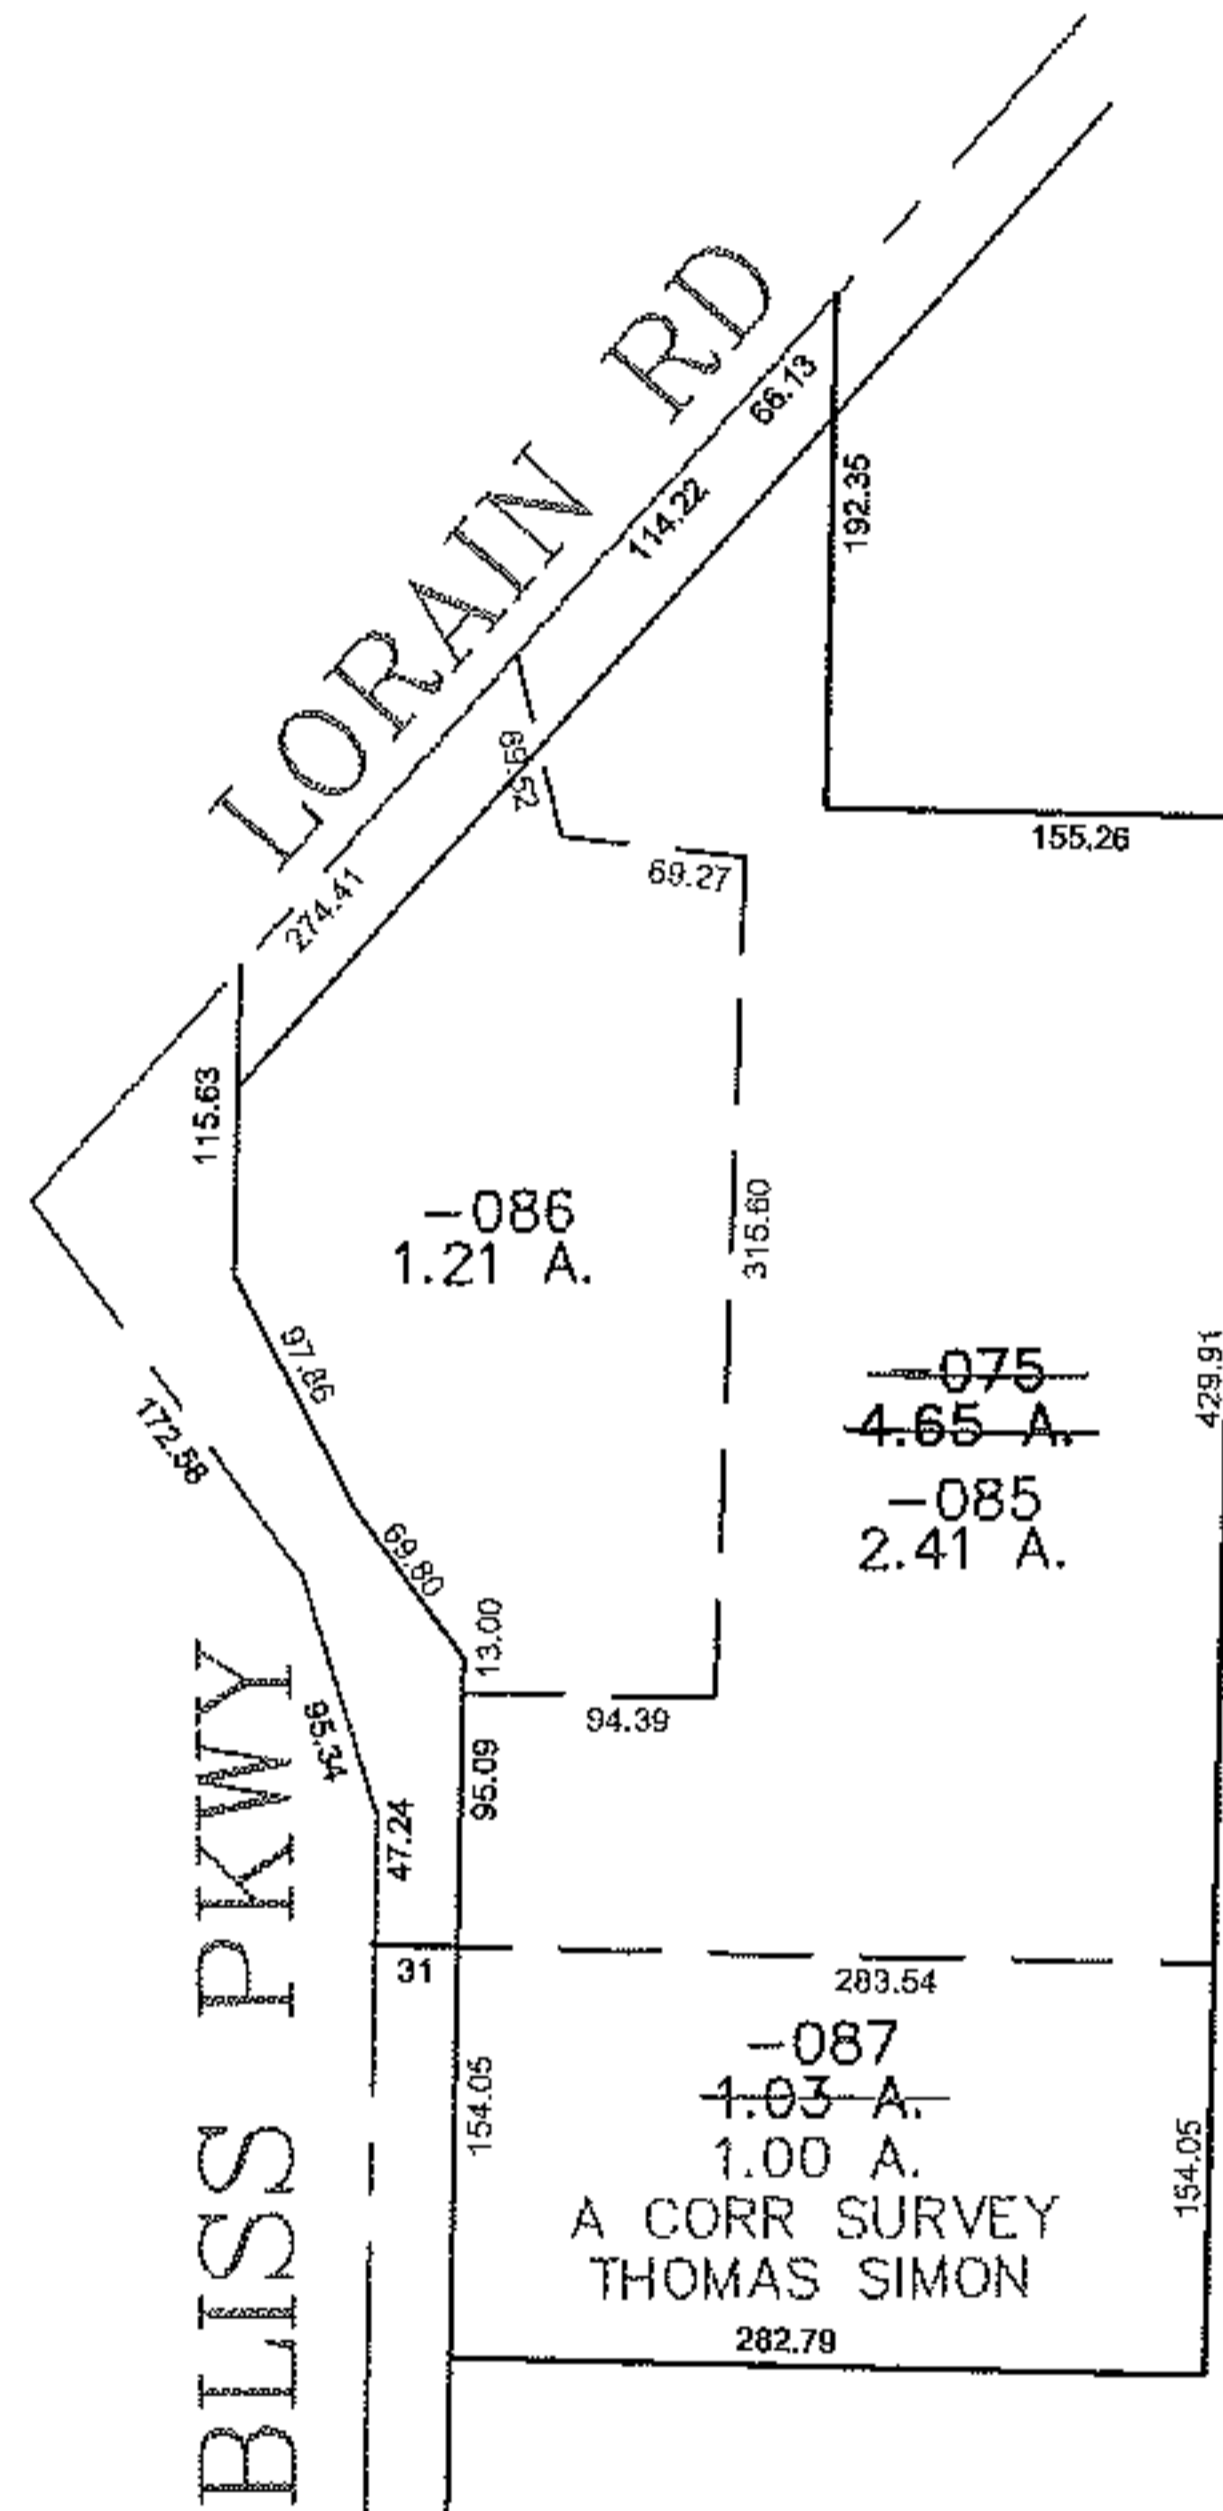


PARENT PARCEL: 07-00-003-102-075

CHILD PARCEL: 07-00-003-102-085 THRU -087

STARTING POINT: CENTERLINE OF LORAIN RD & BLISS PKWY

09-02768

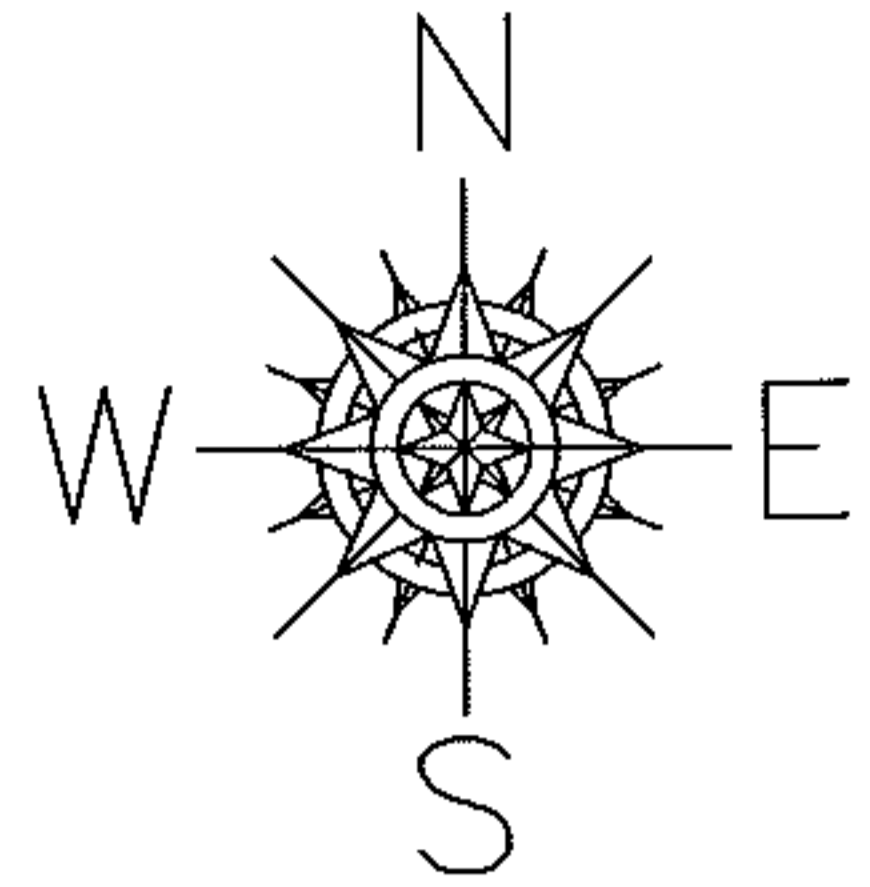

SPLITS/DEEDS PROCESSED
LORAIN COUNTY TAX MAP DEPARTMENT
226 MIDDLE AVE. ELYRIA, OHIO

SURVEYED BY: THOMAS SIMON
CLOSURE: 0.00 : 10.000
MAP PAGE(S): 07-00-003-A
APPROVED BY: JAH DATE: 11-23-09
SCALE: 1" = 200' PRIOR INSTRUMENT: 20020857869