


PARENT PARCEL: 15-00-078-000-029

CHILD PARCEL: XX-XX-XXX-XXX-XXX

STARTING POINT: I.P. MON. BOX, CL OF WHITEHEAD RD. & CL OF WHITNEY RD.

13-02769-C

WHITNEY RD. 60'

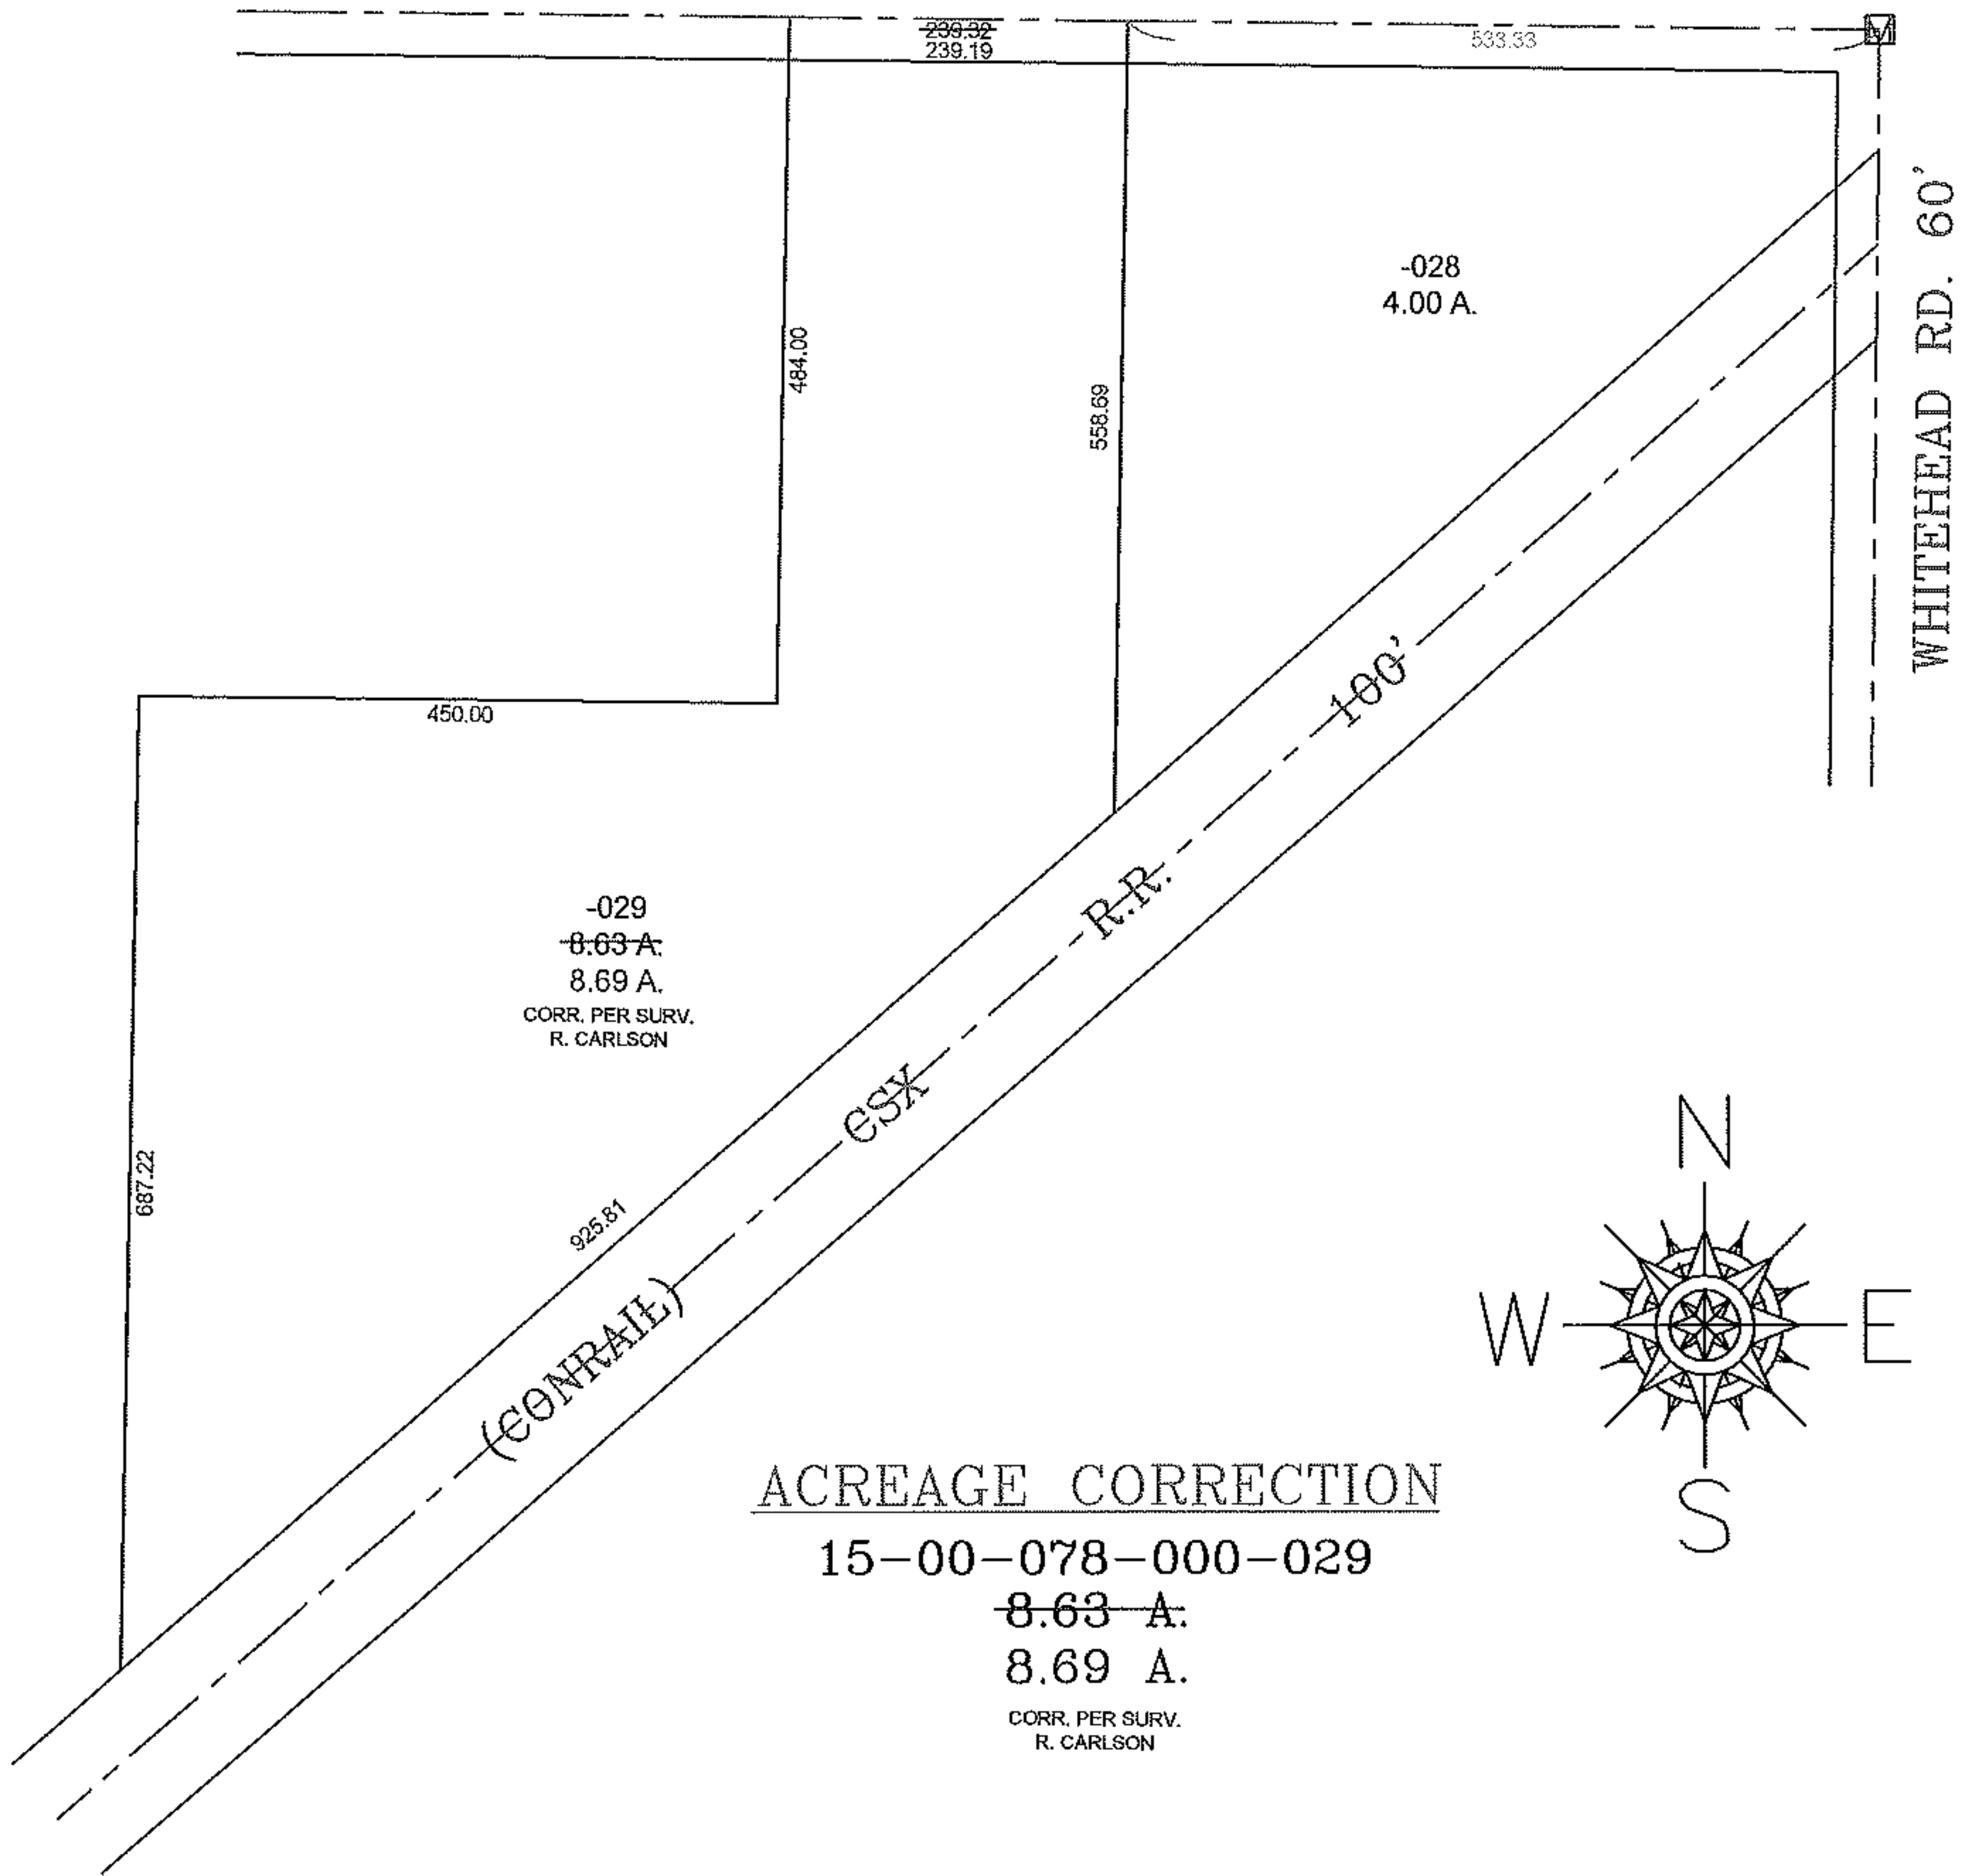

-029
~~8.63 A.~~
 8.69 A.
 CORR. PER SURV.
 R. CARLSON

-028
 4.00 A.



ACREAGE CORRECTION

15-00-078-000-029

~~8.63 A.~~

8.69 A.

CORR. PER SURV.
 R. CARLSON

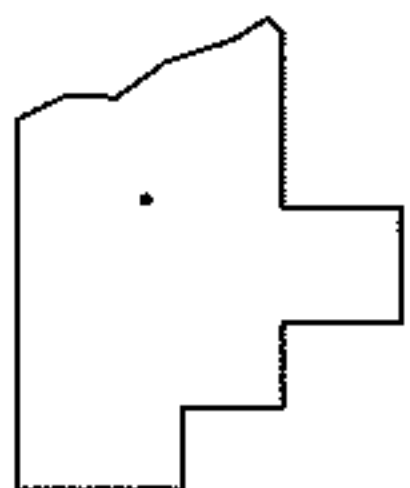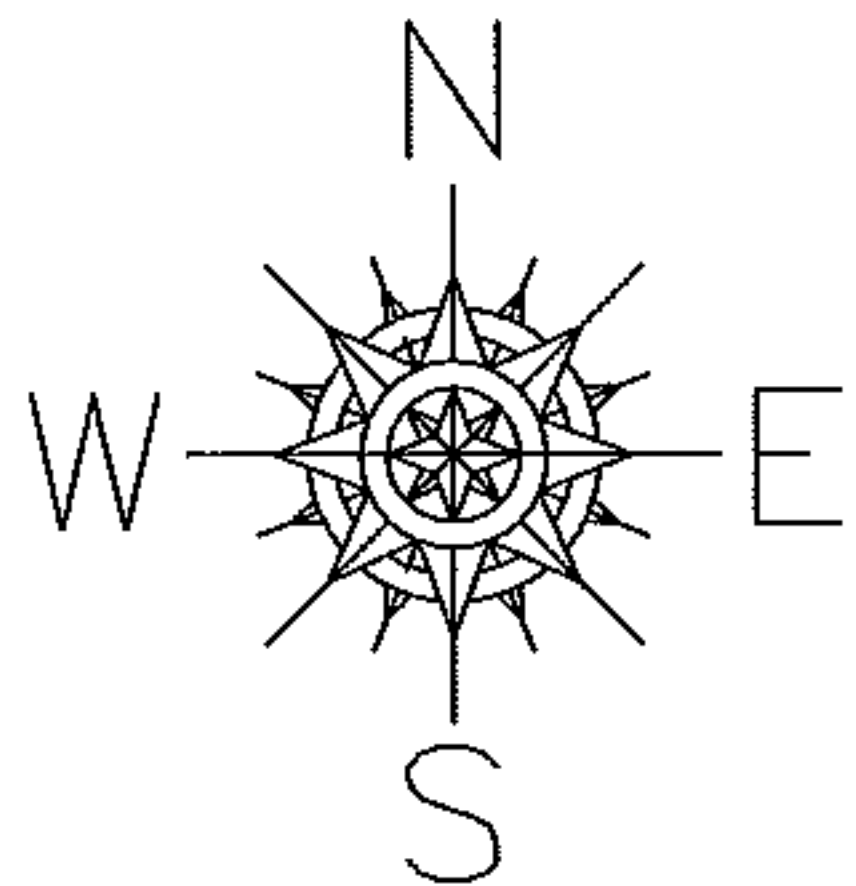

SPLITS/DEEDS PROCESSED
 LORAIN COUNTY TAX MAP DEPARTMENT
 226 MIDDLE AVE. ELYRIA, OHIO

SURVEYED BY: RICHARD D. CARLSON

CLOSURE: 0.01 : 10,000

MAP PAGE(S): 15-00-078

APPROVED BY: TJS DATE: 7/25/13

SCALE: 1" = 200 PRIOR INSTRUMENT: 20090310305