


PARENT PARCEL: 03-00-058-102-023, -024

CHILD PARCEL: SAME

STARTING POINT: CENTERLINE OF COLORADO AVE & ROOT RD

09-02769

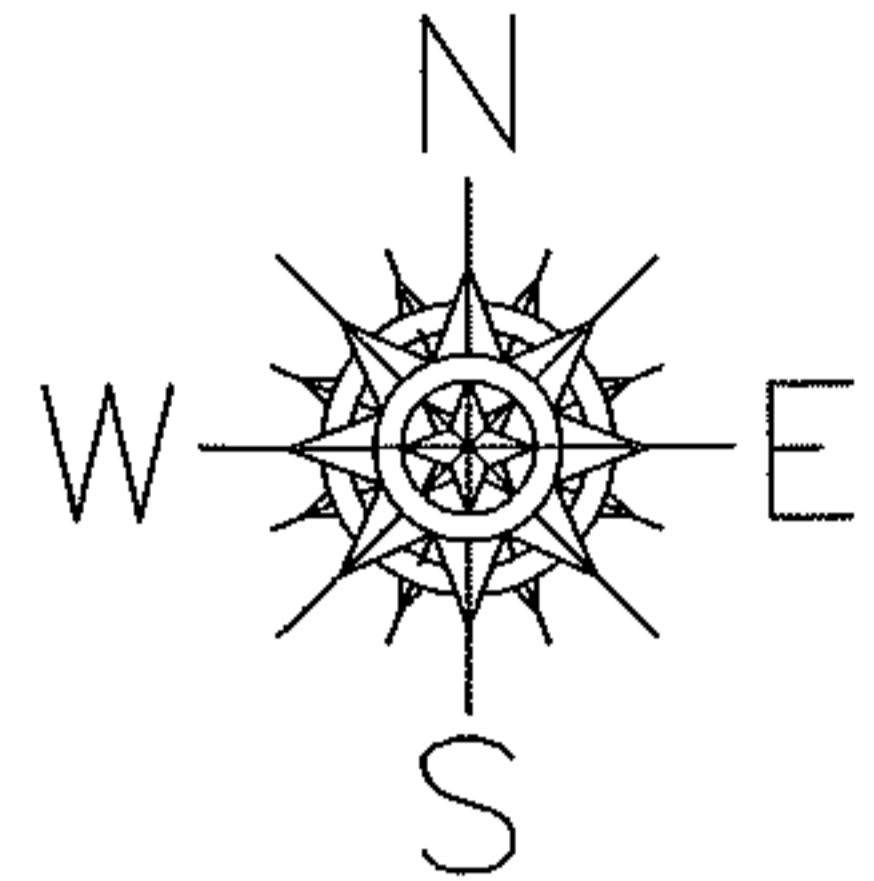

COLORADO

ROOT RD

AVE

104.14
69.94 48.63 30.97
~~0.32 A.~~
0.30 A.
A CORR SURVEY
PATRICK MCGANNON

307.55
139.94
290.01
238.16
24.
.18
65.44
-024
~~2.05 A.~~
2.00 A.
A CORR SURVEY
PATRICK MCGANNON


51.80

206.15

66.27

34.36

144.38

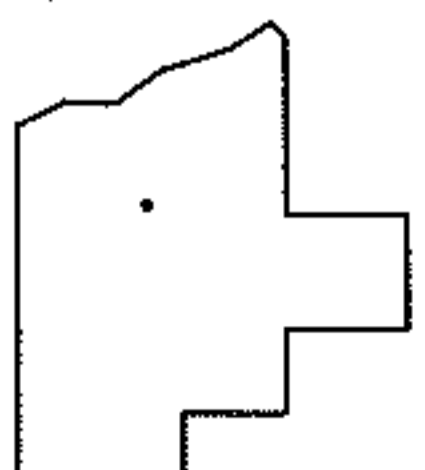

SPLITS/DEEDS PROCESSED

LORAIN COUNTY TAX MAP DEPARTMENT
226 MIDDLE AVE. ELYRIA, OHIO

SURVEYED BY: PATRICK MCGANNON

CLOSURE: 0.00 : 10.000

MAP PAGE(S): 03-00-058-A

APPROVED BY: JAH DATE: 11-23-09

SCALE: 1" = 100 PRIOR INSTRUMENT: 20060124460