


PARENT PARCEL: 18-00-003-000-008

CHILD PARCEL: _____

13-02770-D



STARTING POINT: AT A MON BOX AT THE INTERSECTION OF C/L OF WEST RD. AND C/L OF JONES RD.

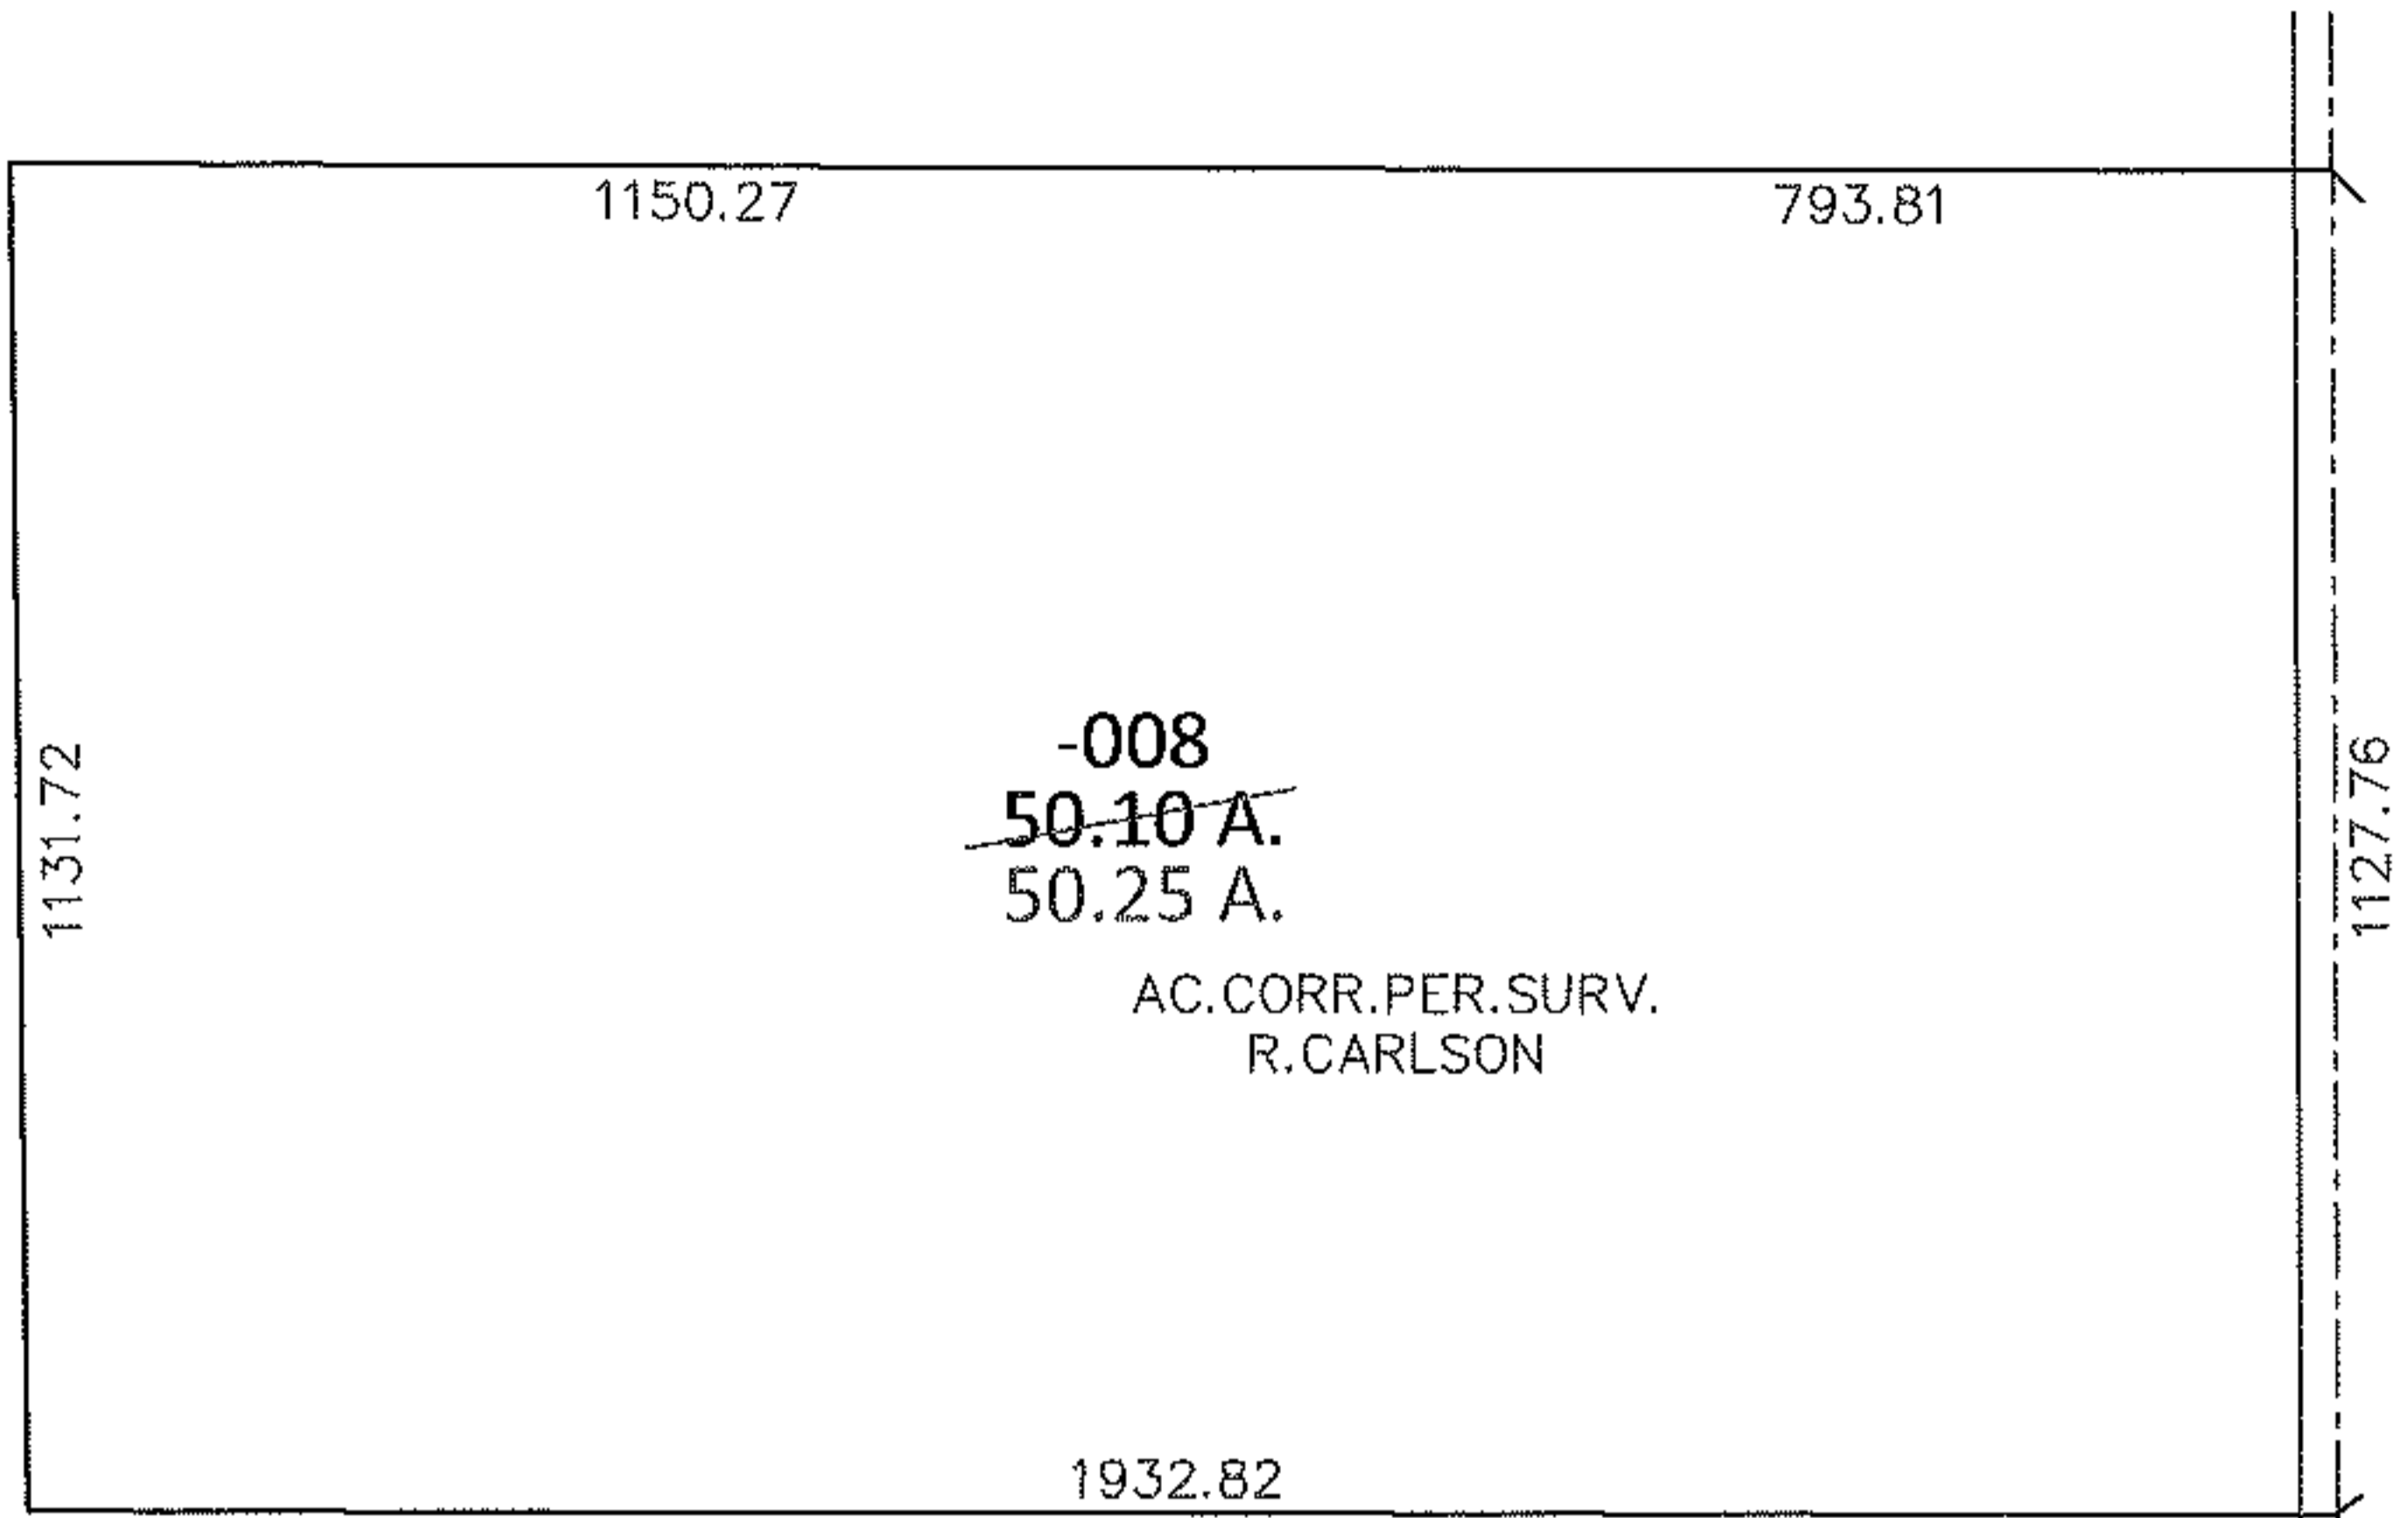

WEST RD.

1704.86

JONES RD.

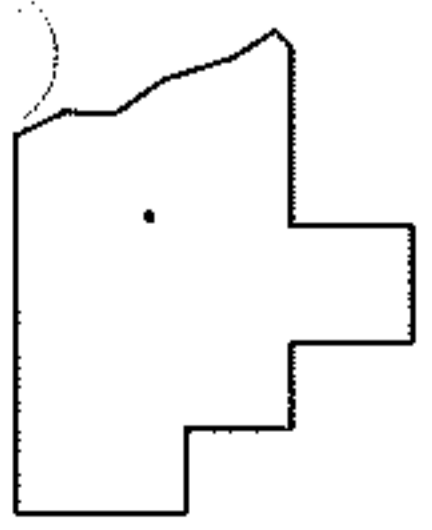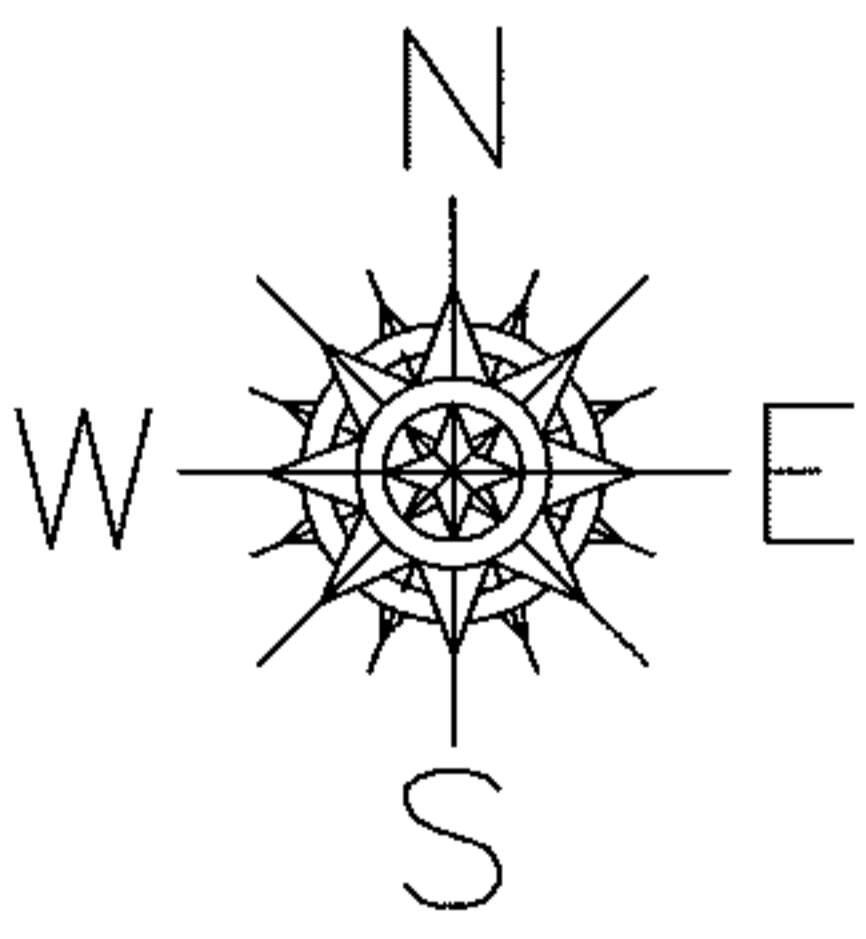

SPLITS/DEEDS PROCESSED

LORAIN COUNTY TAX MAP DEPARTMENT
226 MIDDLE AVE. ELYRIA, OHIO

SURVEYED BY: RICHARD D. CARLSON

CLOSURE: .01:10,000

MAP PAGE(S): 18-H

APPROVED BY: RRM DATE: 7-29-13

SCALE: 1"= 400 PRIOR INST.: 20020861080