
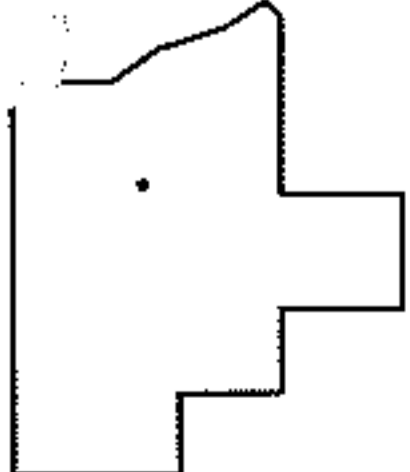
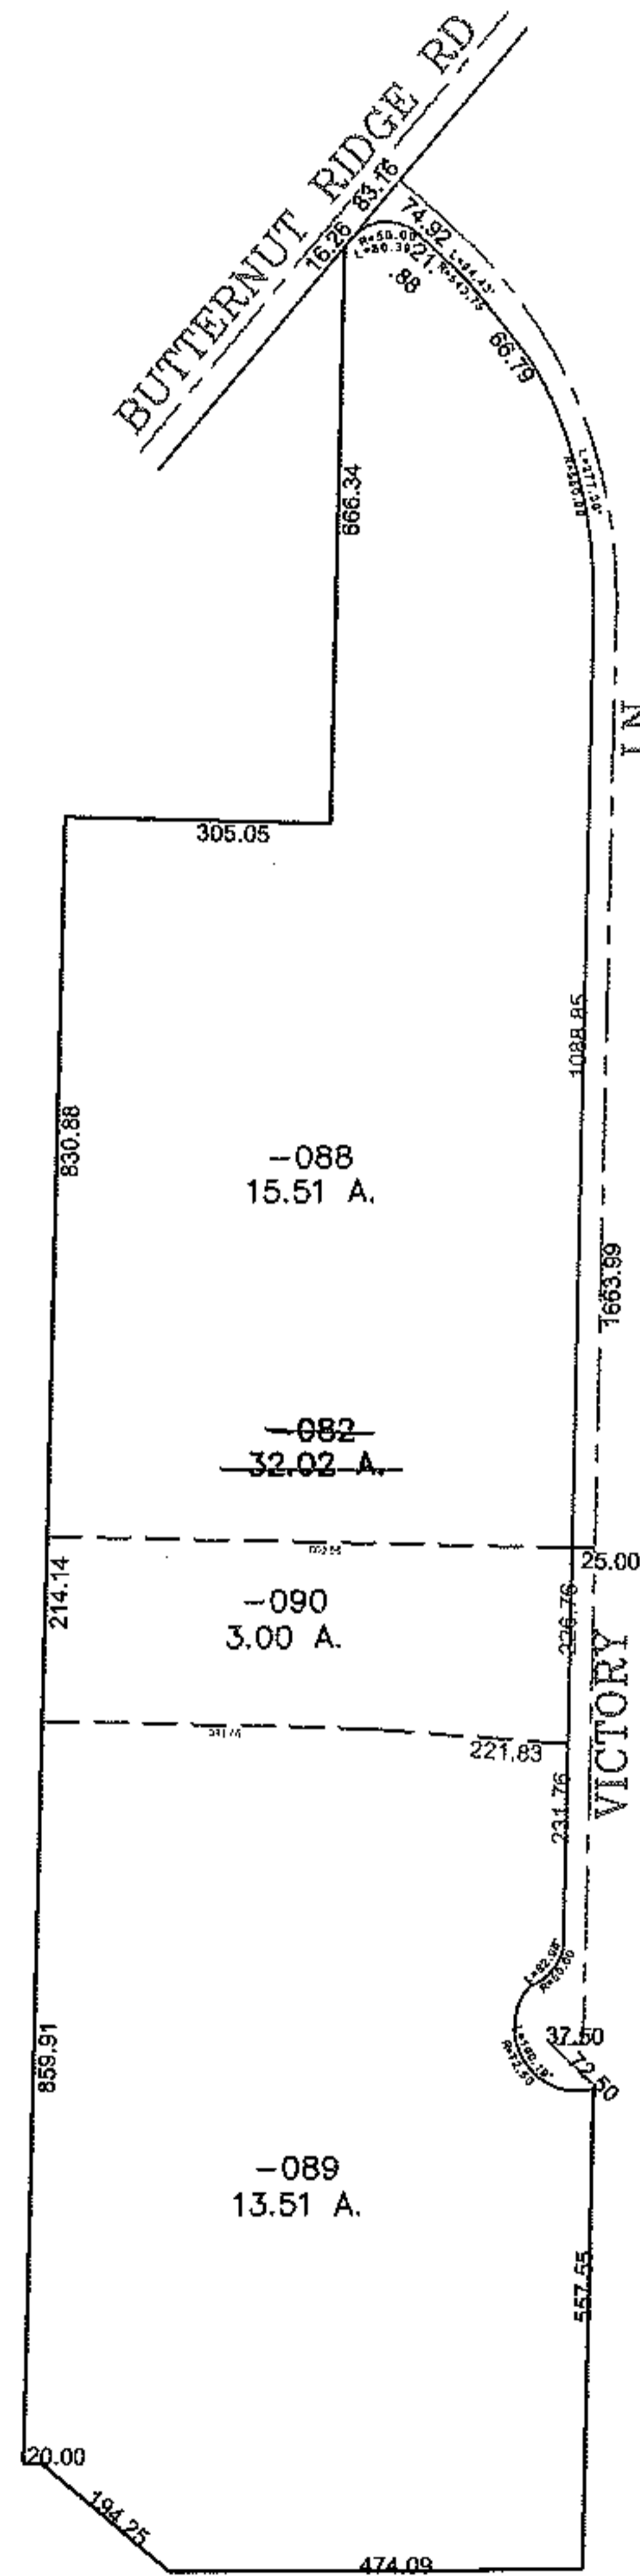


PARENT PARCEL: 07-00-003-102-082

CHILD PARCEL: 07-00-003-102-088 THRU -090

STARTING POINT: SIDELINE OF BUTTERNUT RIDGE RD & VICTORY LN

09-02770

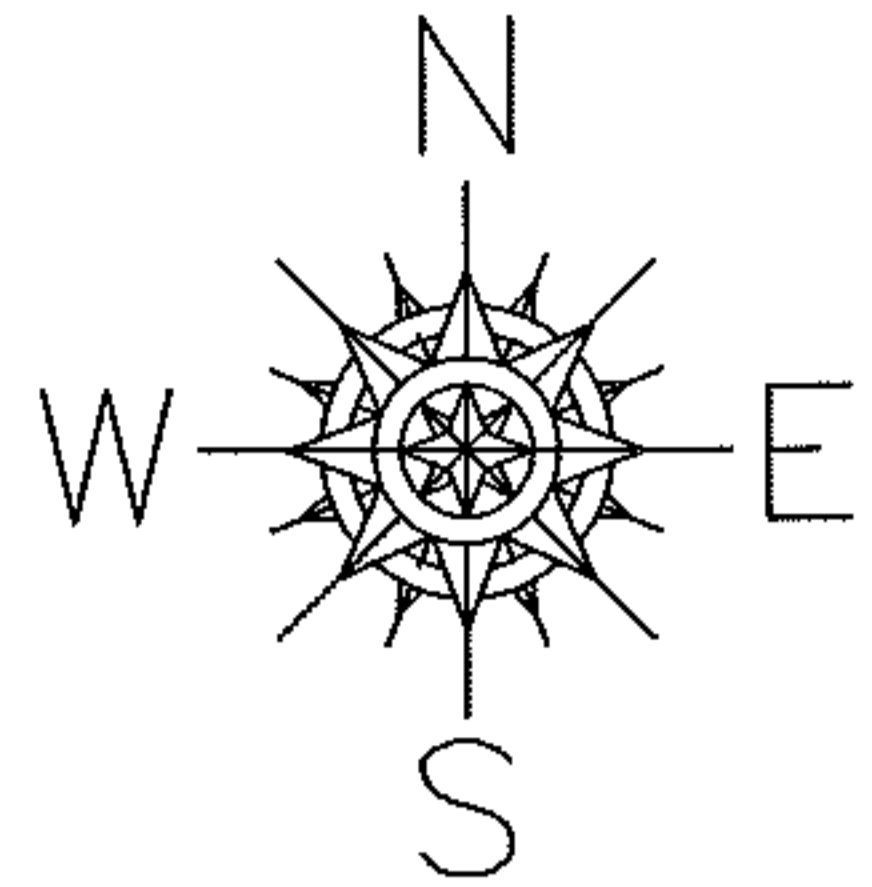

**SPLITS/DEEDS PROCESSED**

LORAIN COUNTY TAX MAP DEPARTMENT  
226 MIDDLE AVE. ELYRIA, OHIO

SURVEYED BY: HOWARD SELEE

CLOSURE: 0.00 : 10,000

MAP PAGE(S): 07-00-003-C

APPROVED BY: JAH DATE: 12-4-09

SCALE: 1"= 400 PRIOR INST.: 20090291659