
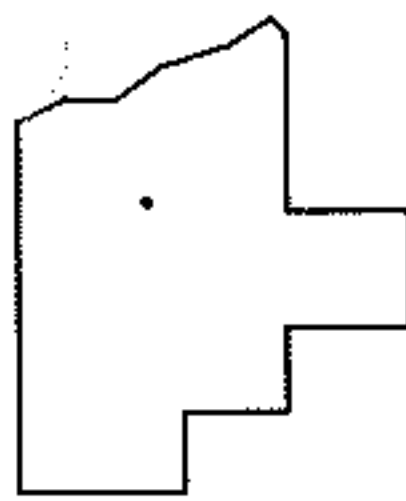
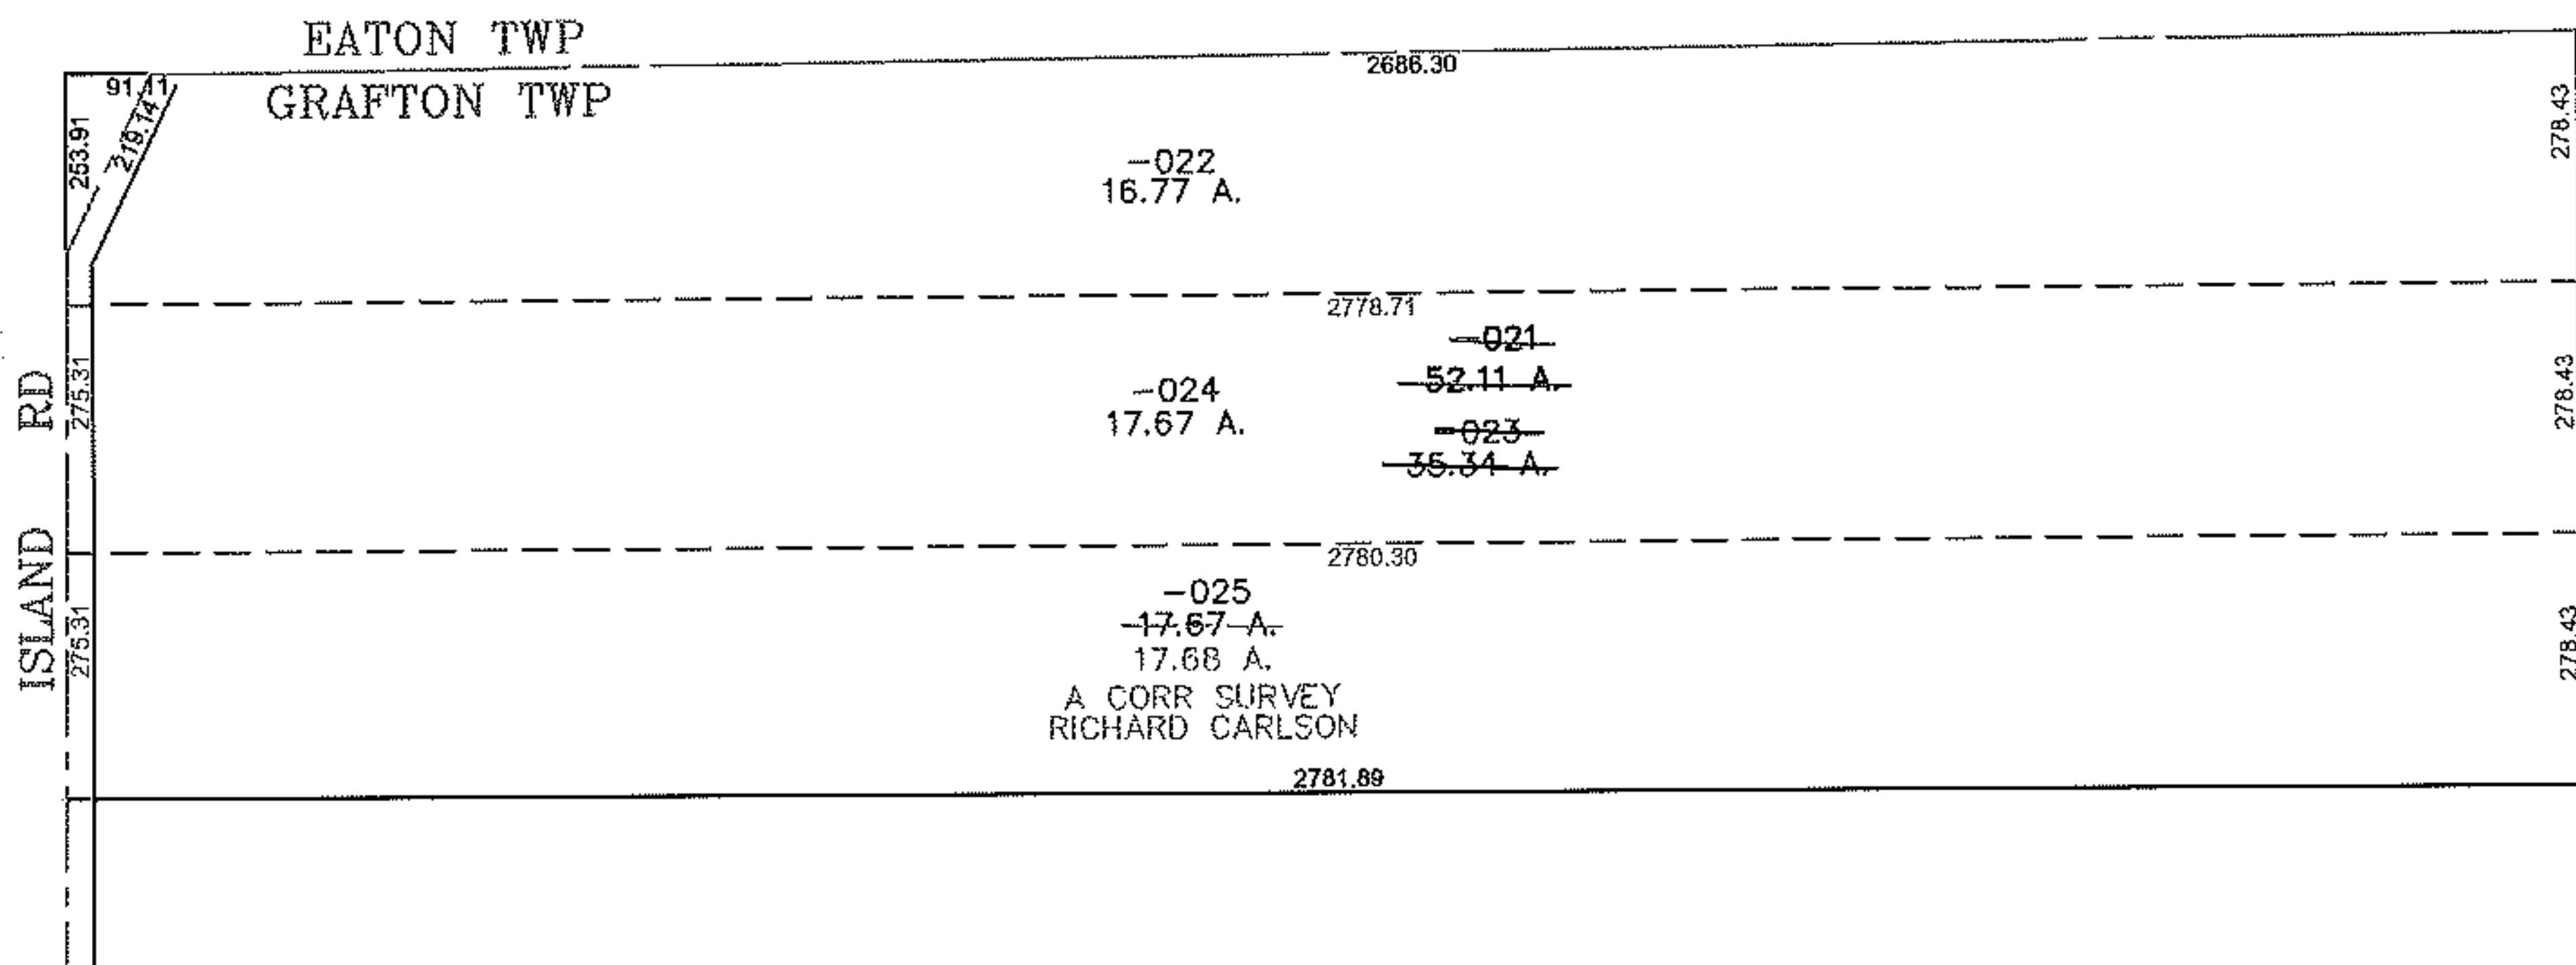


PARENT PARCEL: 16-00-008-000-021

CHILD PARCEL: 16-00-008-000-022 THRU -025

STARTING POINT: CENTERLINE OF ISLAND RD & O.L. 8 GRAFTON TWP

09-02771

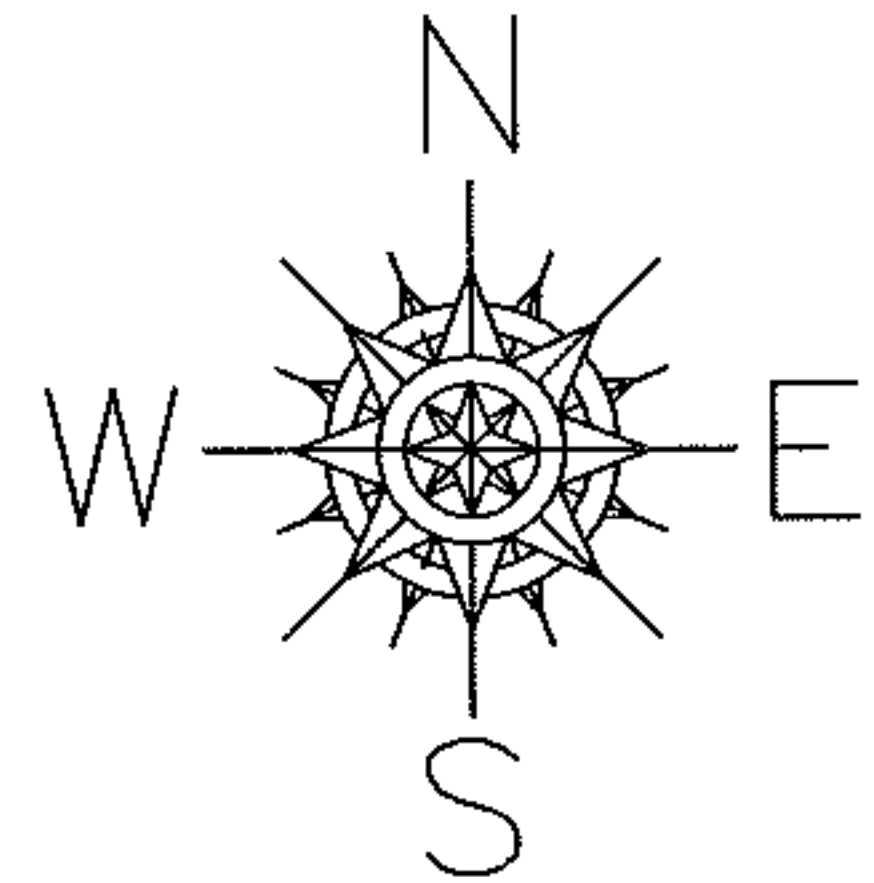

SPLITS/DEEDS PROCESSED

LORAIN COUNTY TAX MAP DEPARTMENT
226 MIDDLE AVE. ELYRIA, OHIO

SURVEYED BY: RICHARD CARLSON

CLOSURE: 0.00 : 10,000

MAP PAGE(S): 16-D

APPROVED BY: JAH DATE: 11-23-09

SCALE: 1" = 400' PRIOR INSTRUMENT: 20080274772