
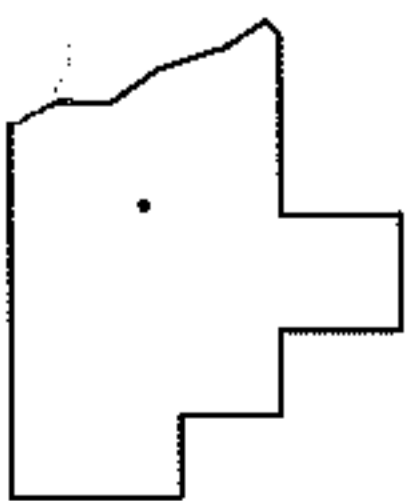
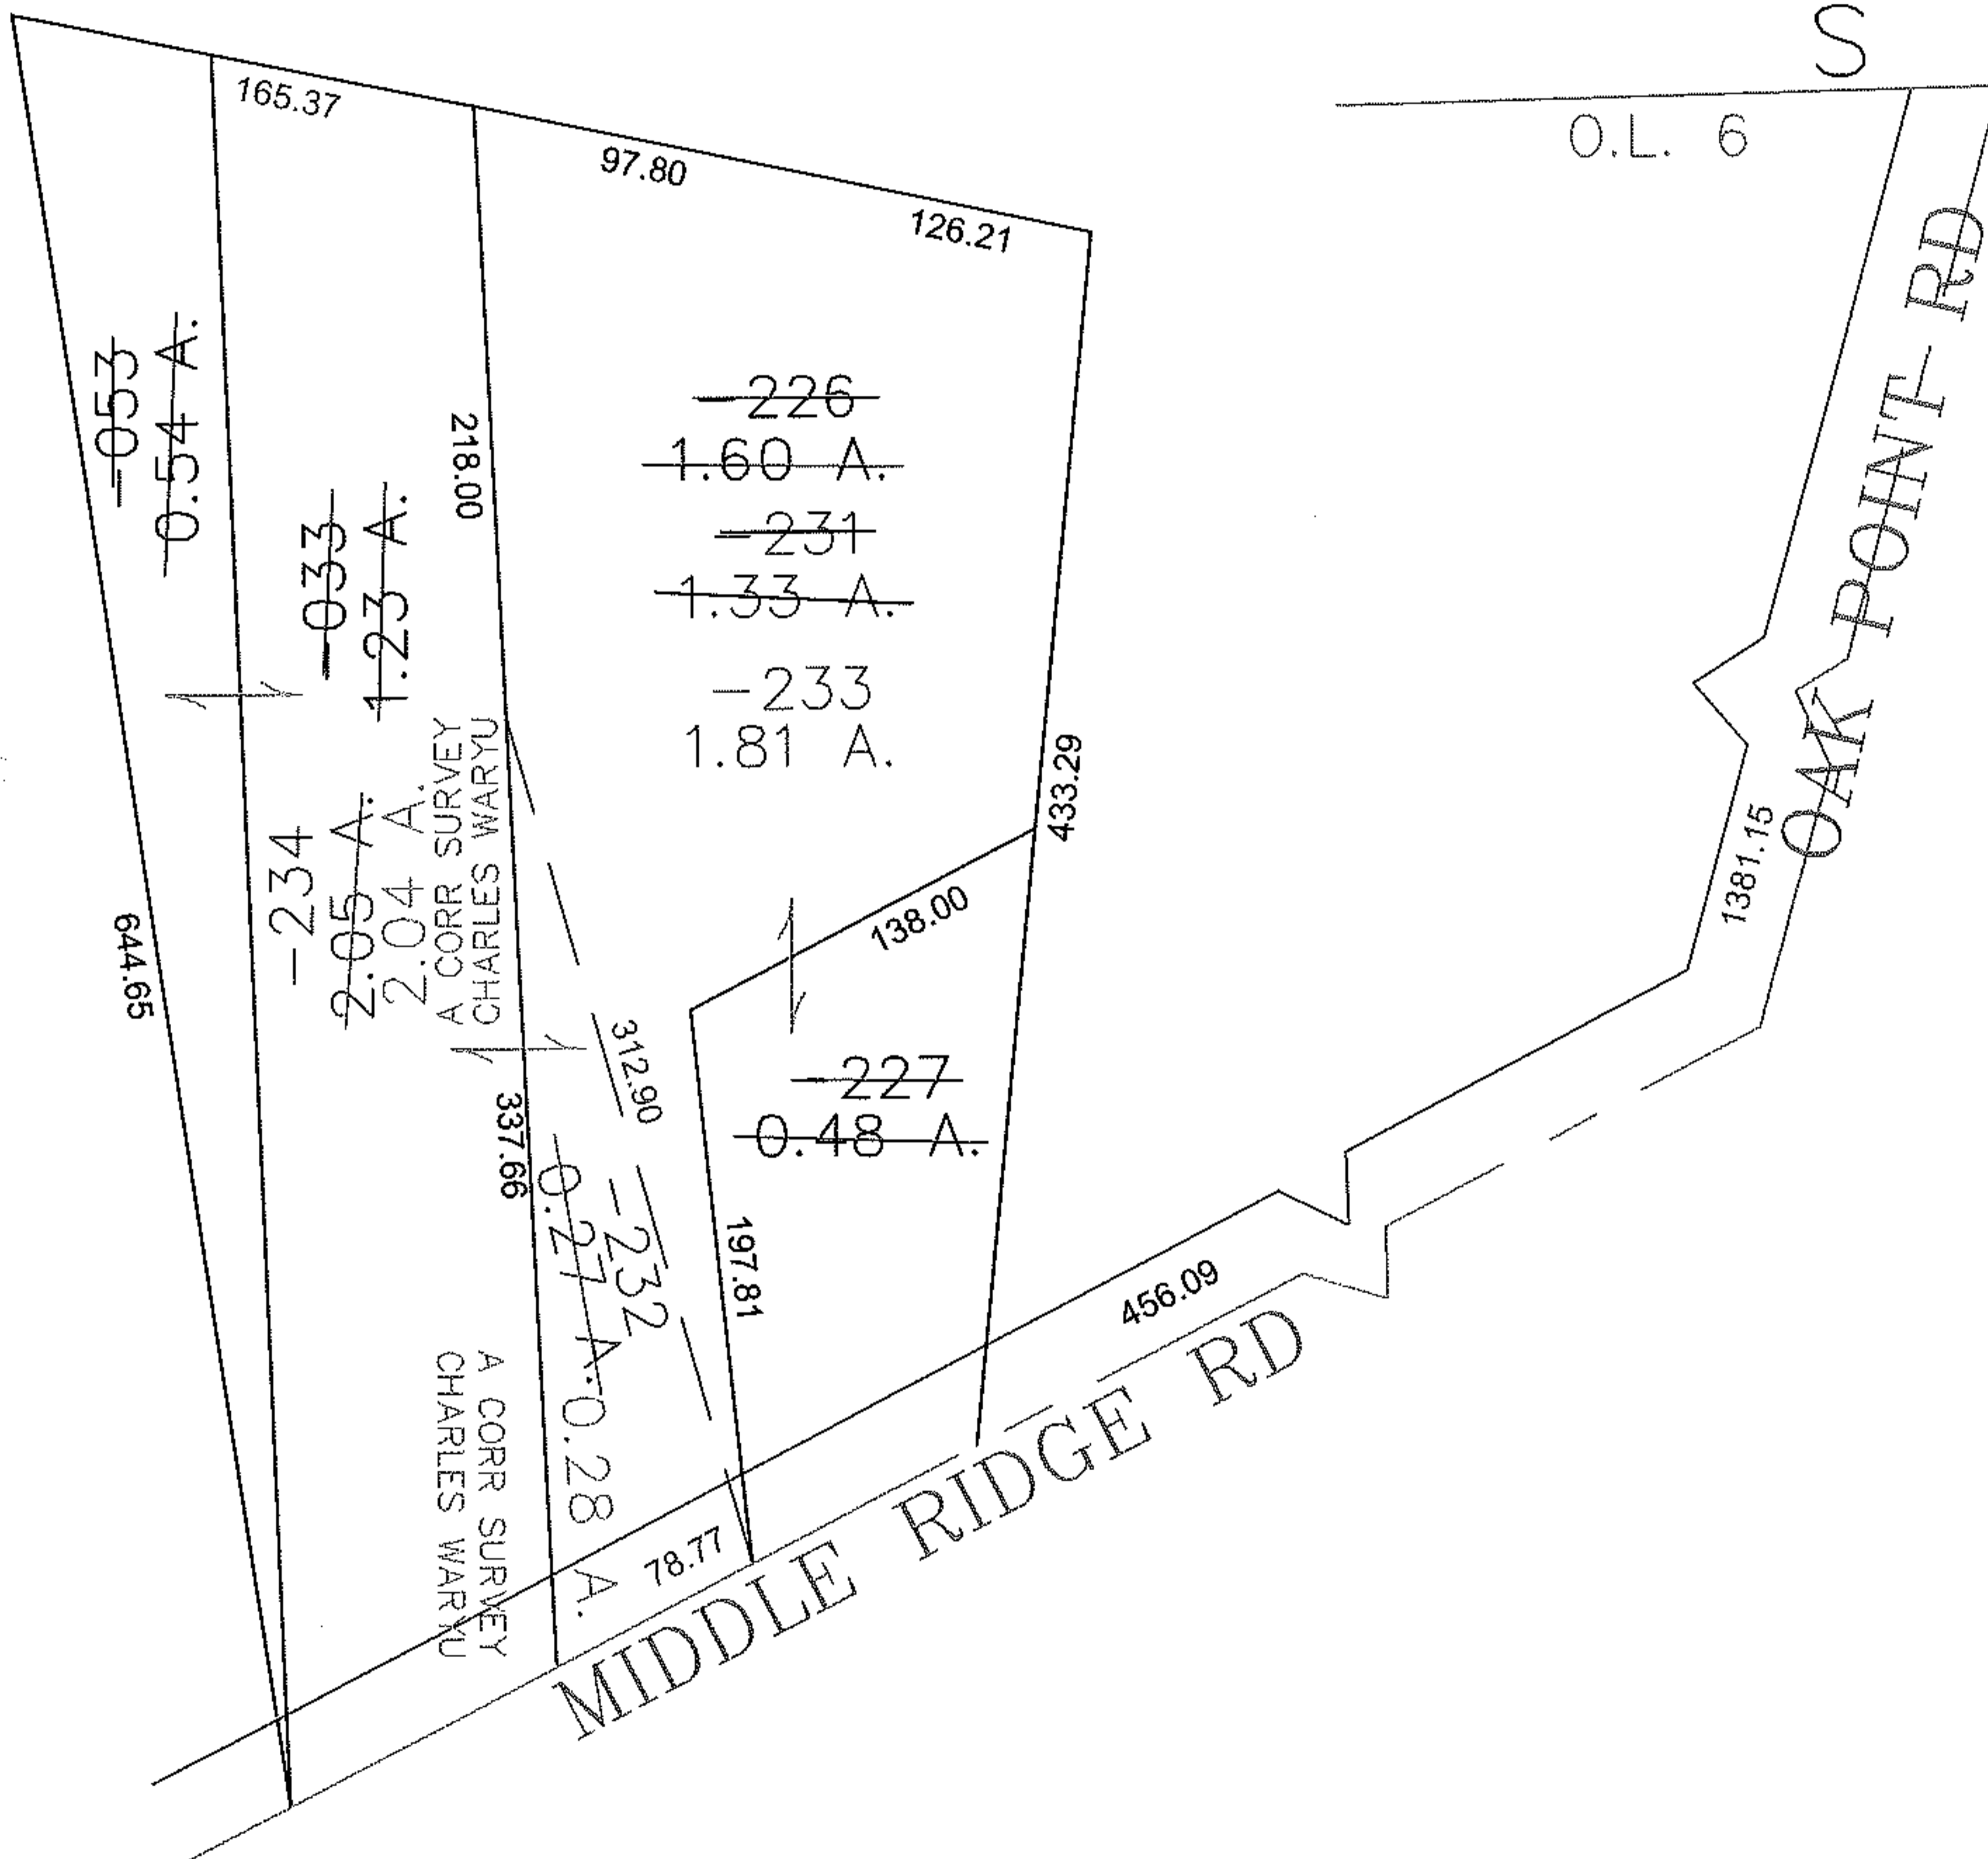


PARENT PARCEL: 05-00-006-000-226, -033, -053

CHILD PARCEL: 05-00-006-000-231 THRU -234

STARTING POINT: CENTERLINE OF OAK POINT RD & O.L. 6

09-02772

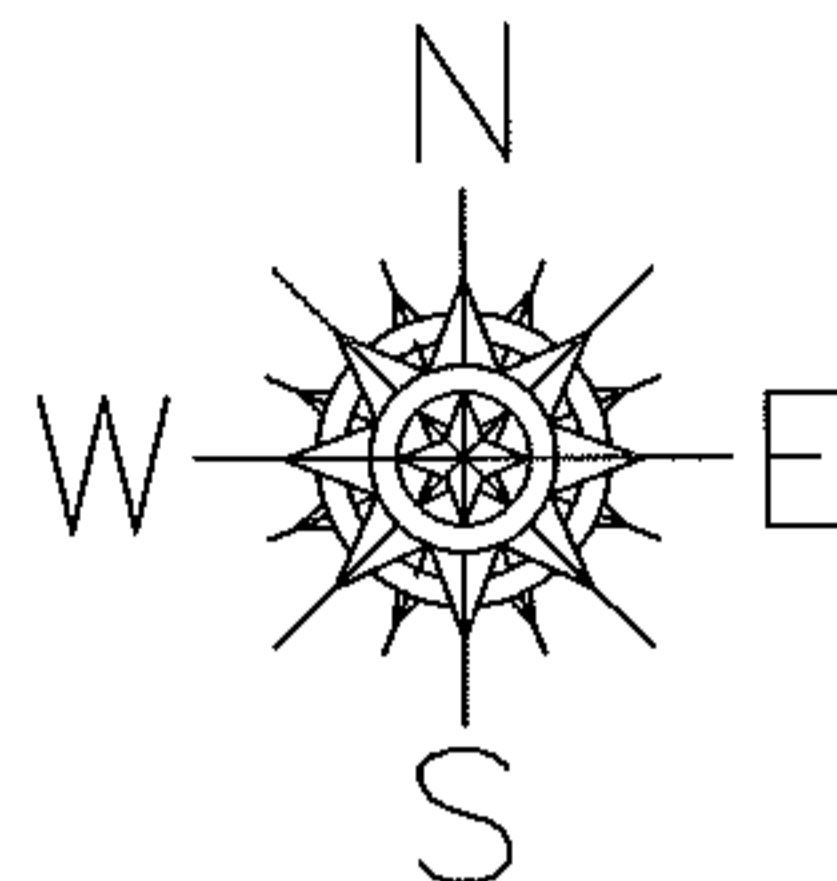

SPLITS/DEEDS PROCESSED

LORAIN COUNTY TAX MAP DEPARTMENT
226 MIDDLE AVE. ELYRIA, OHIO

SURVEYED BY: CHARLES WARYU
 CLOSURE: 0.00 : 10.000
 MAP PAGE(S): 05-00-006-A
 APPROVED BY: JAH DATE: 12-1-09
 SCALE: 1" = 100' PRIOR INSTRUMENT: 20050102414