
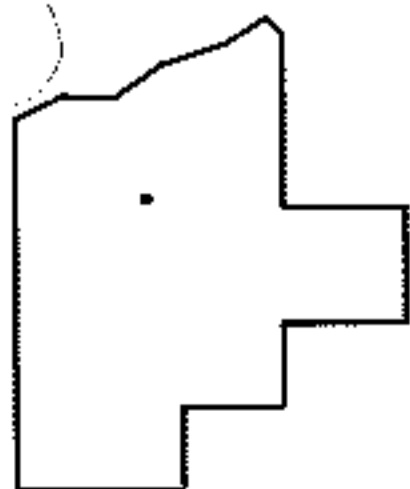
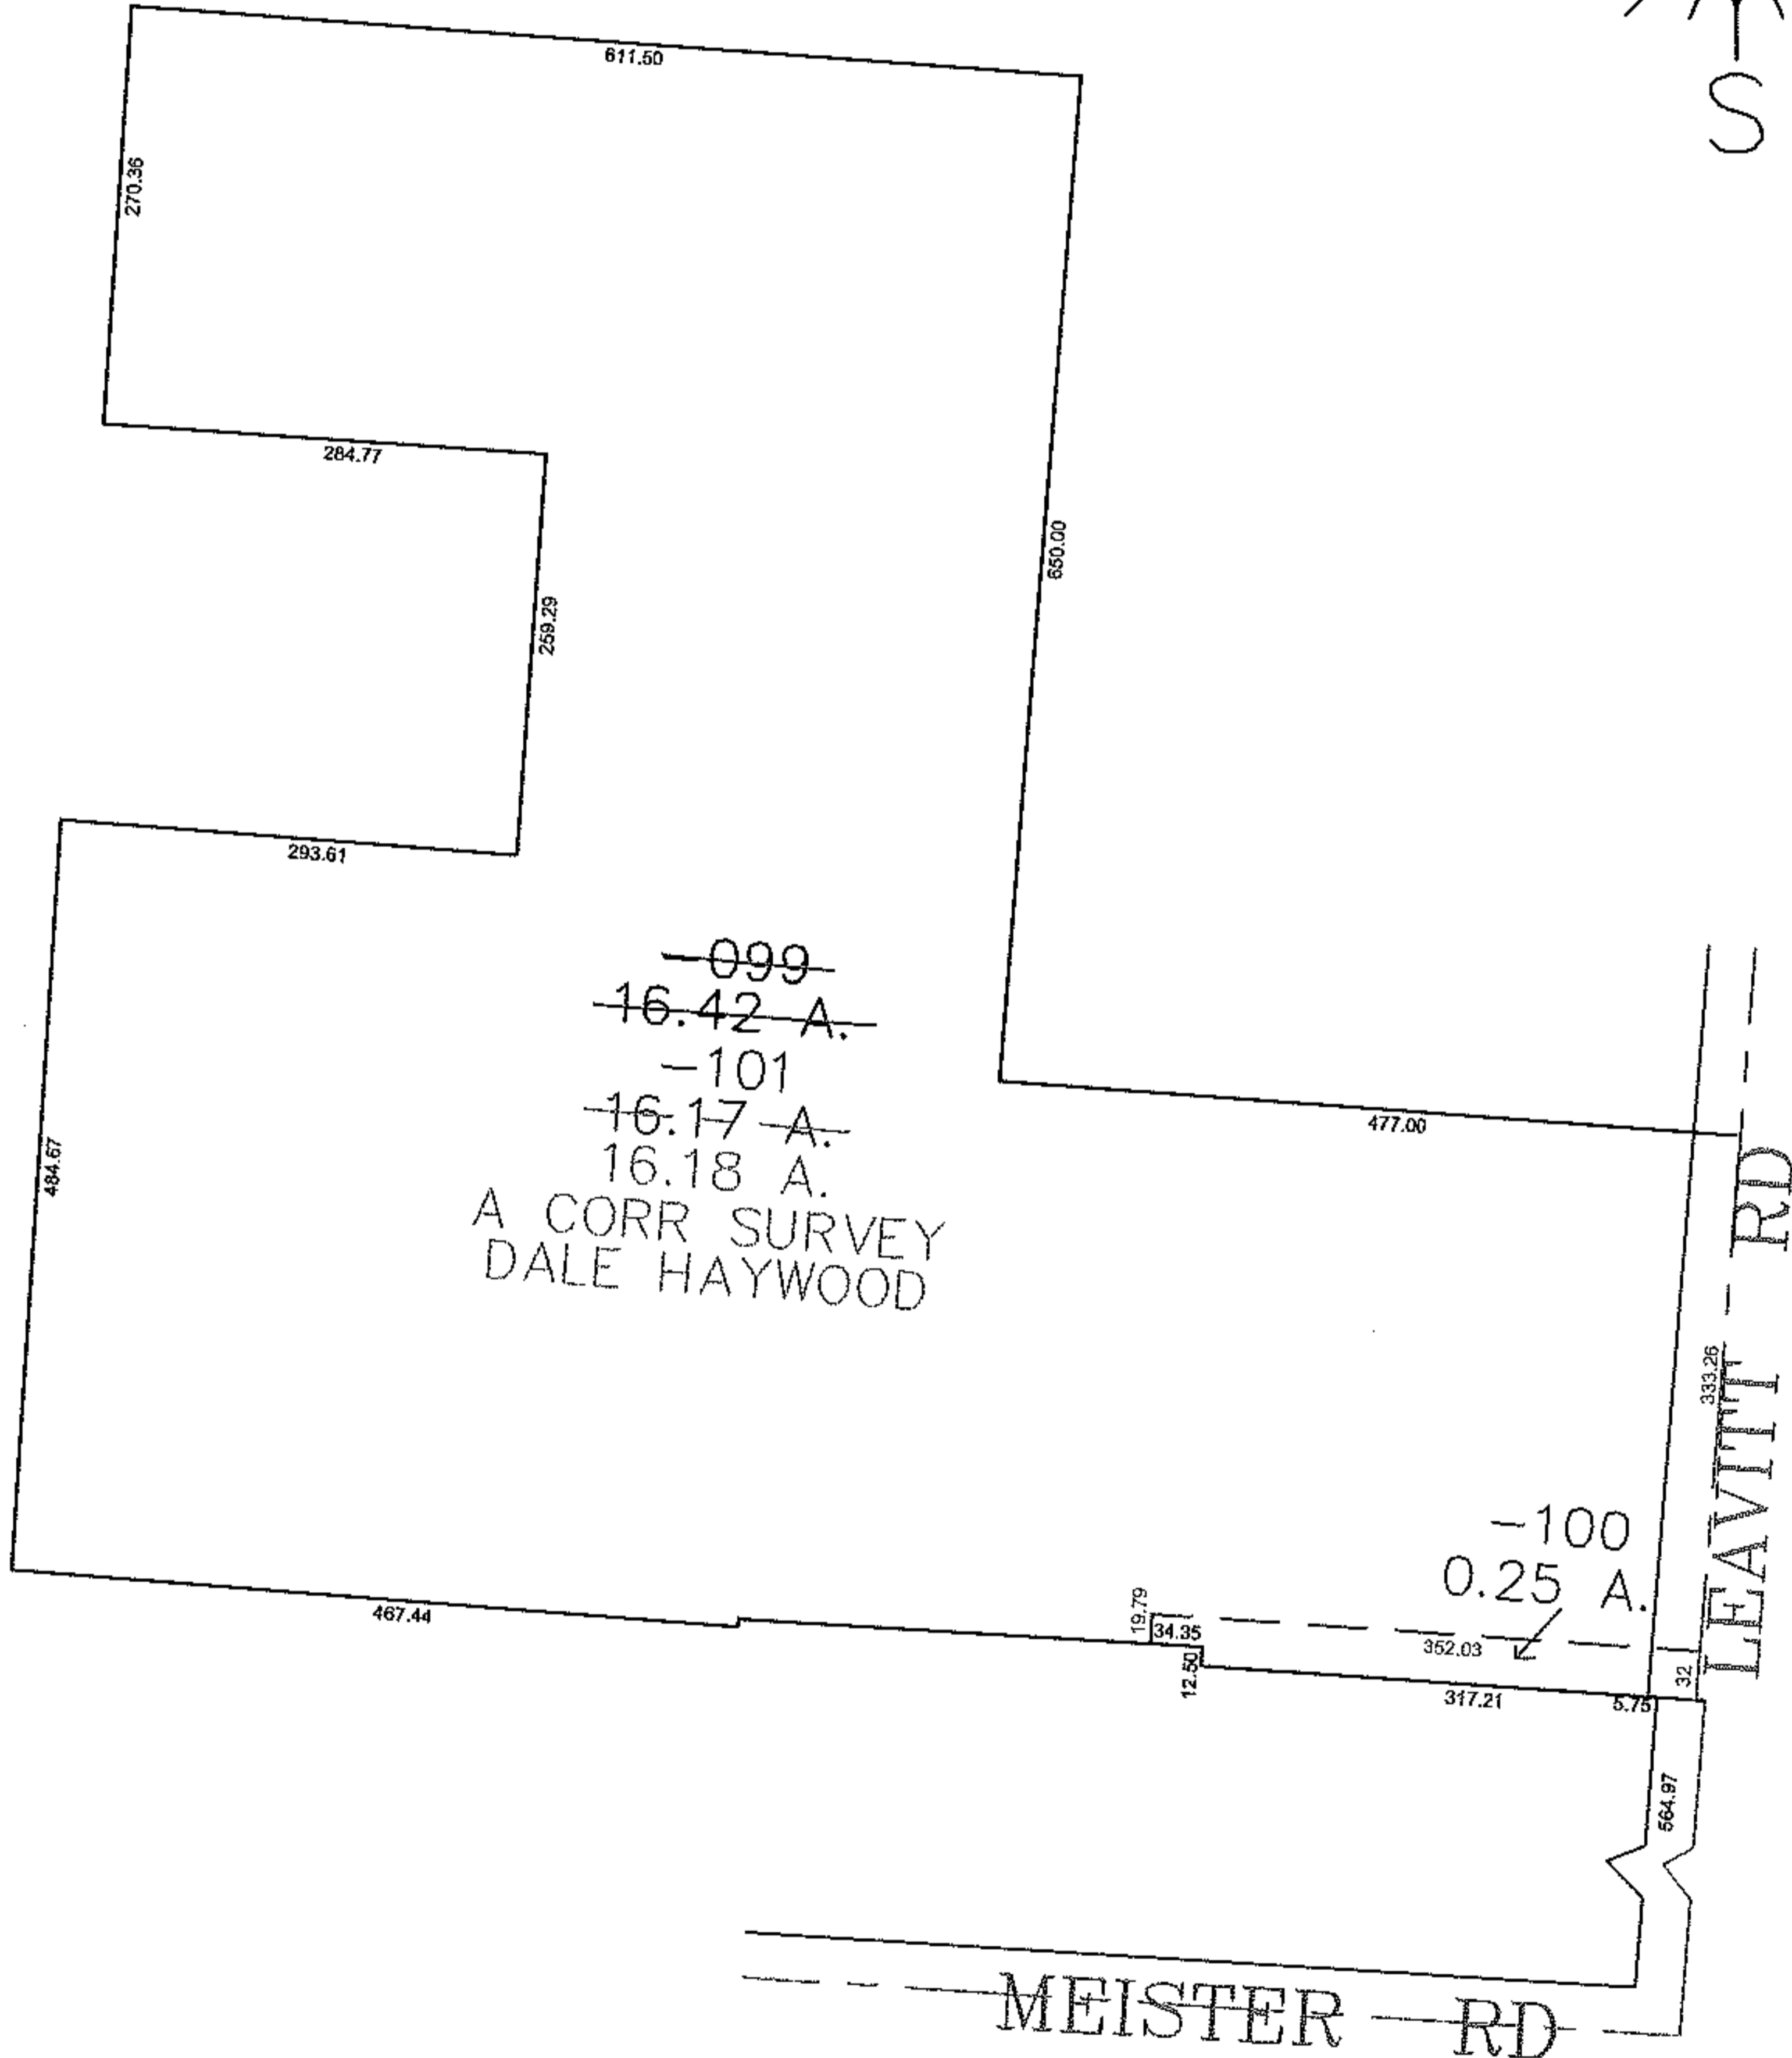


PARENT PARCEL: 02-02-018-000-099

CHILD PARCEL: 02-02-018-000-100, -101

STARTING POINT: CENTERLINE OF MEISTER RD & LEAVITT RD

09-02774

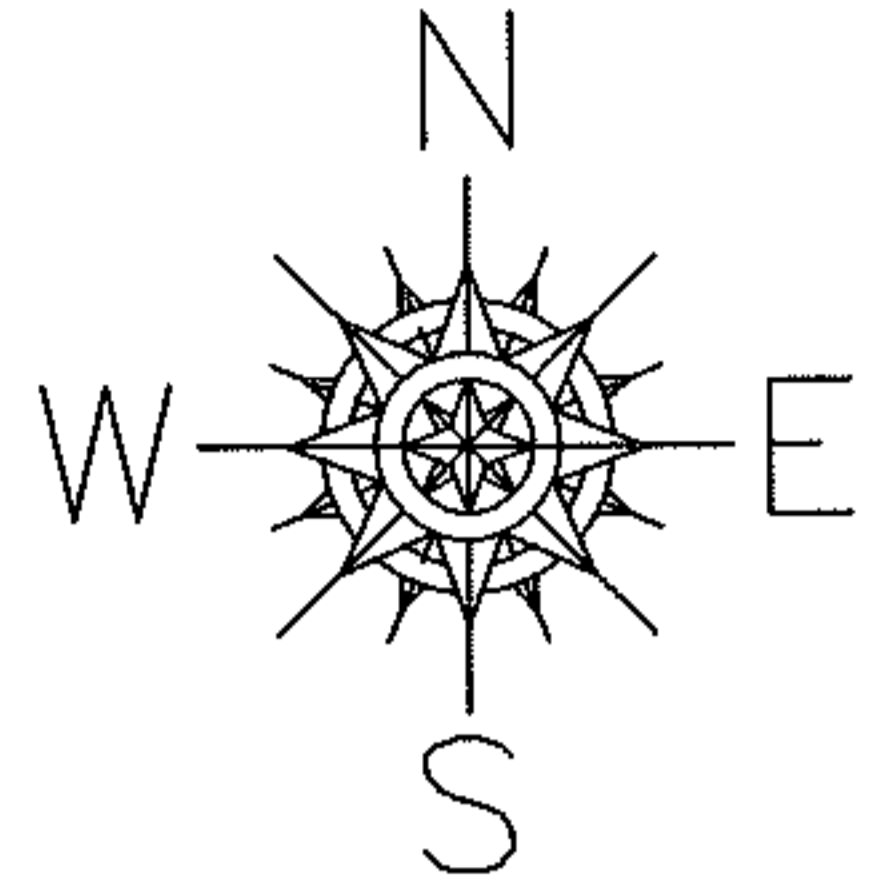

SPLITS/DEEDS PROCESSED

LORAIN COUNTY TAX MAP DEPARTMENT
226 MIDDLE AVE. ELYRIA, OHIO

SURVEYED BY: DALE HAYWOOD

CLOSURE: 0.00 : 10,000

MAP PAGE(S): 02-02-018-B

APPROVED BY: JAH DATE: 12-7-09

SCALE: 1" = 200 PRIOR INSTRUMENT: 20070216073

RASTER