

PARENT PARCEL: 15-00-069-000-055




13-02777-D

CHILD PARCEL: _____

STARTING POINT: AT A MON BOX AT THE INTERSECTION OF C/L OF INDIAN HOLLOW RD. AND NORTH LINE OF O.L.69

O.L. 52

O.L. 69

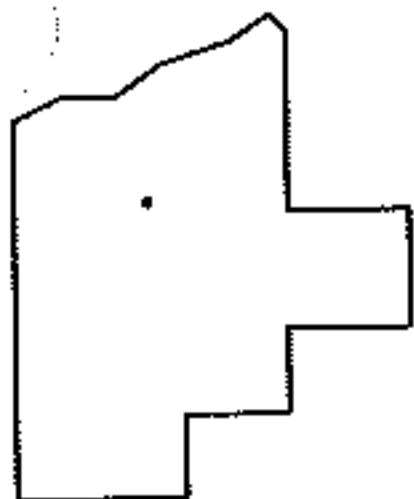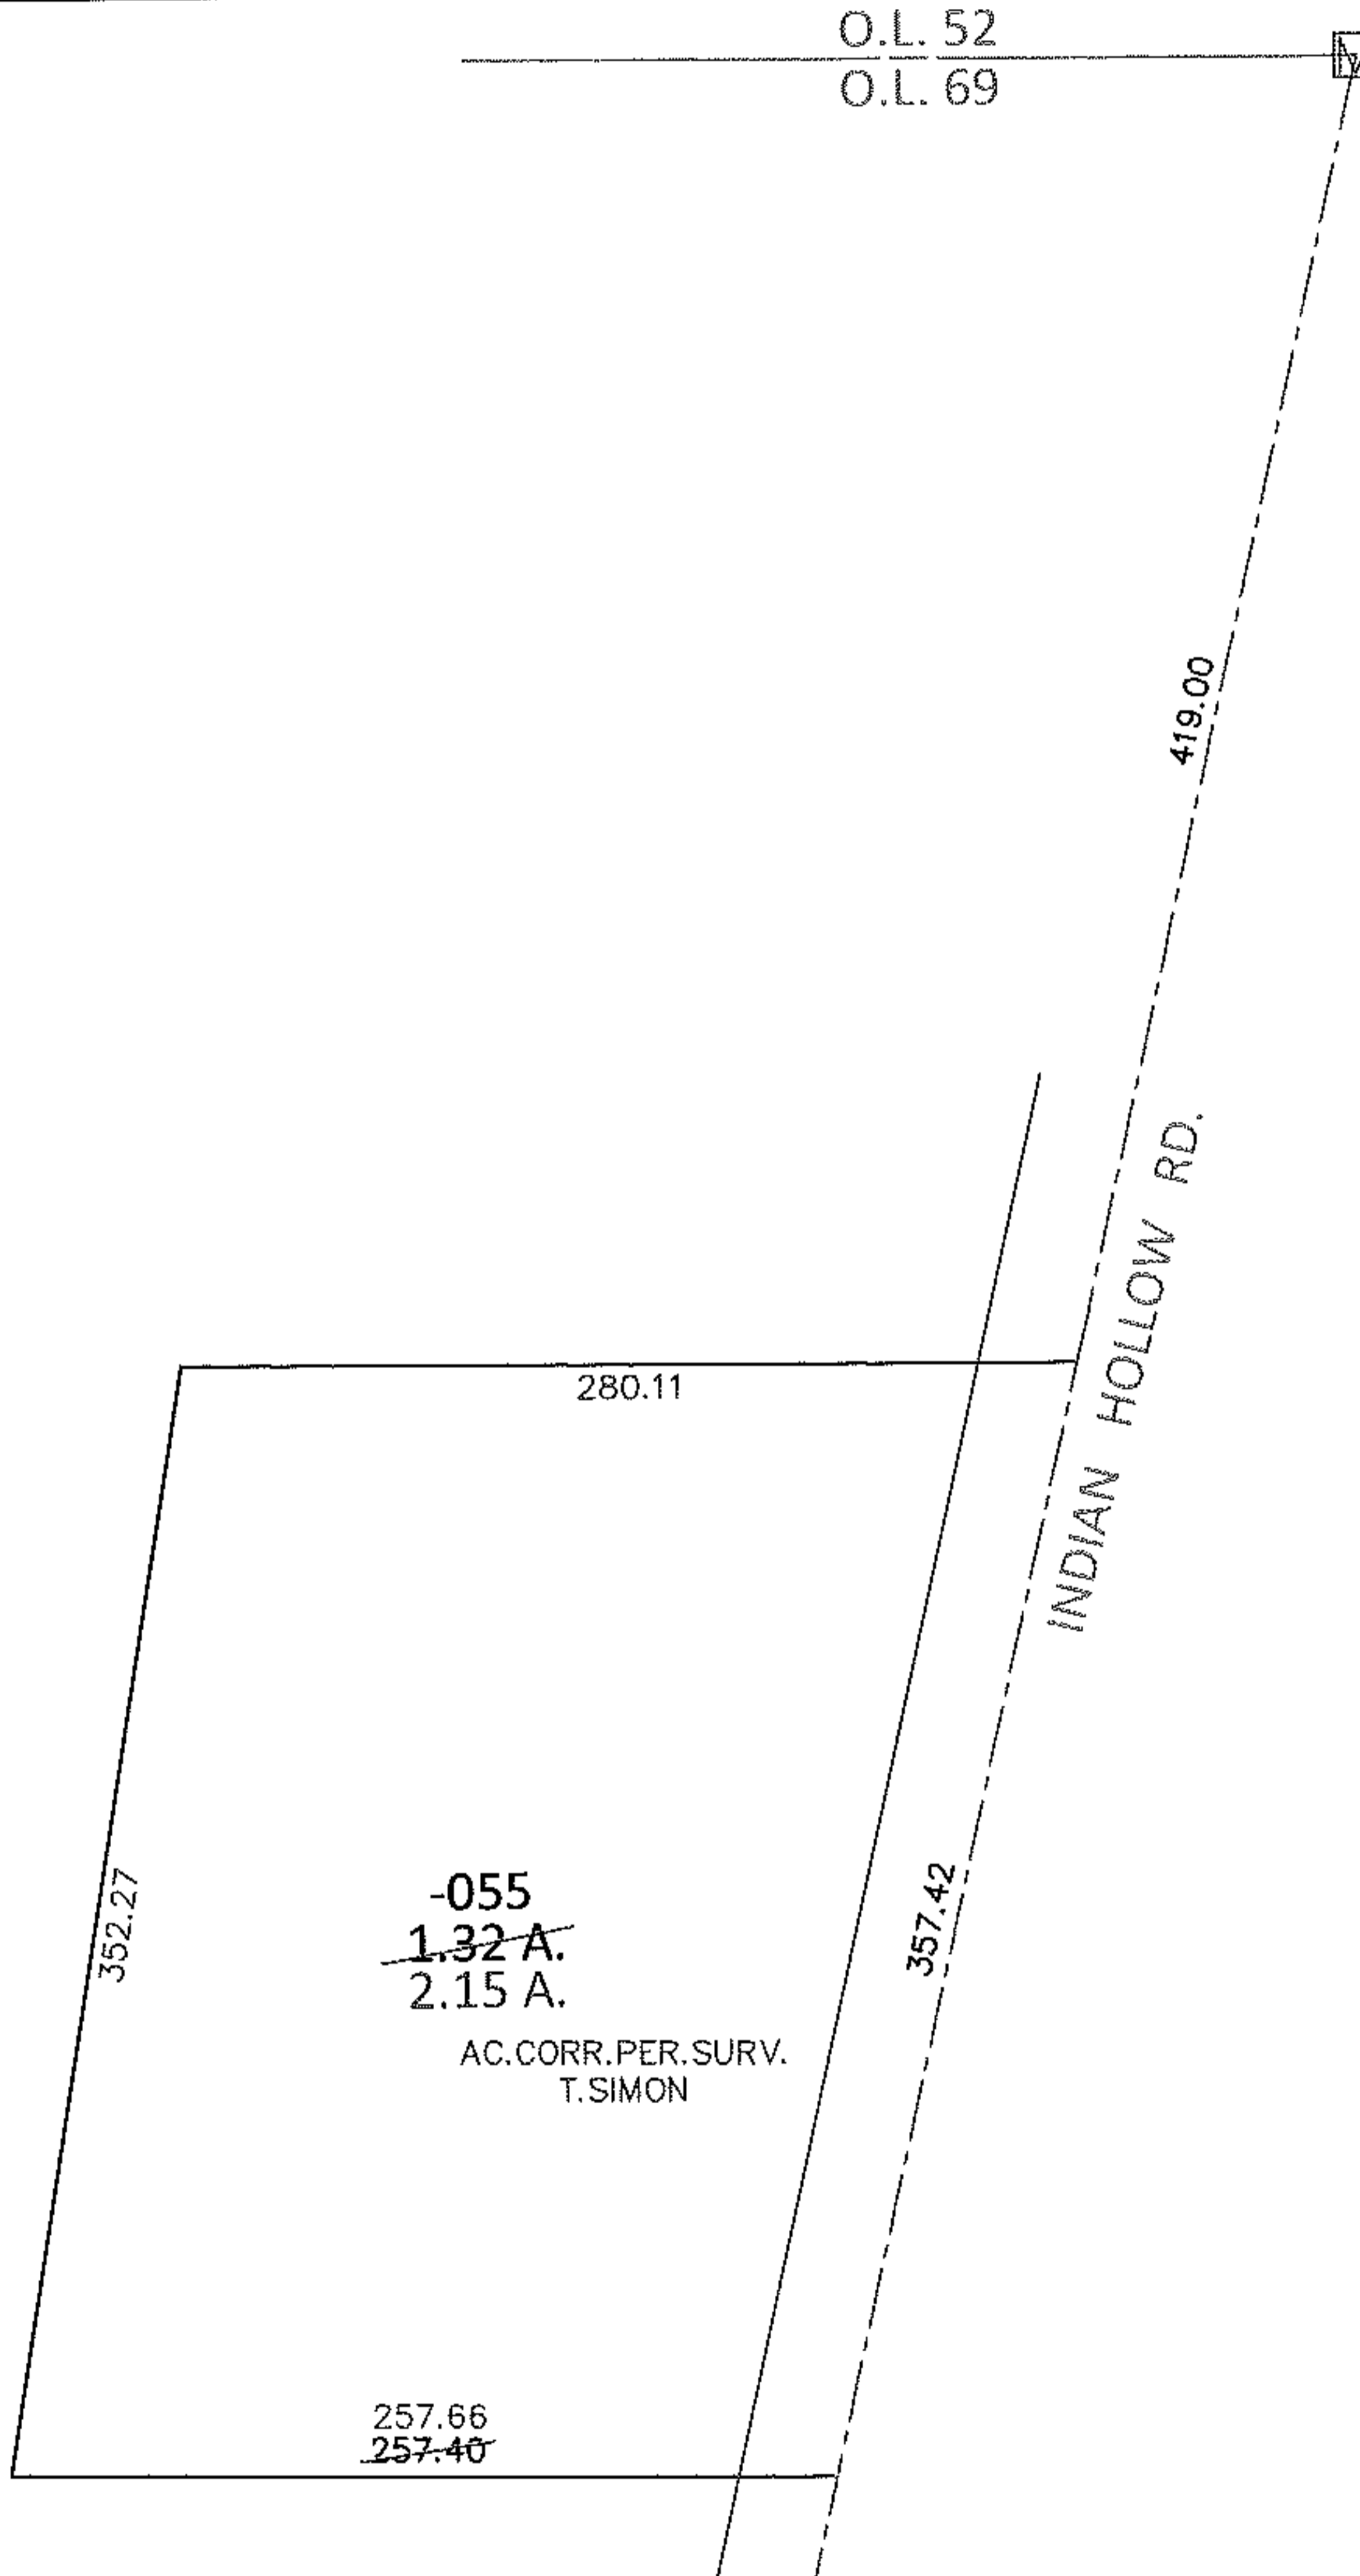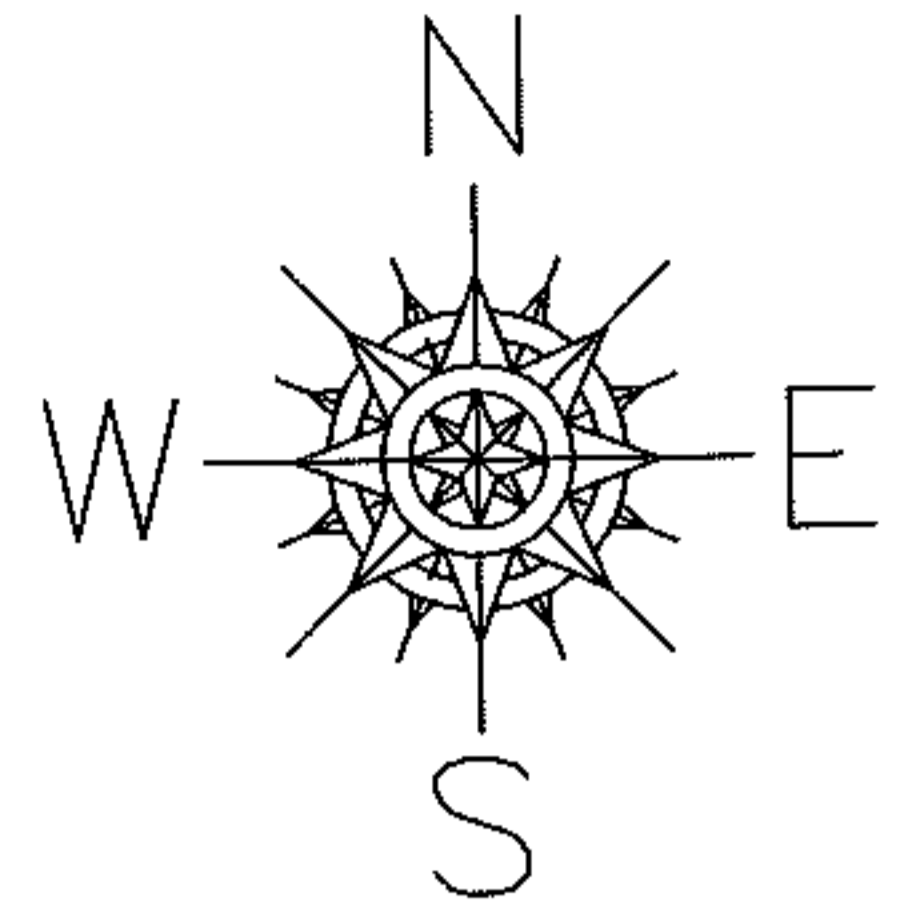

SPLITS/DEEDS PROCESSED

LORAIN COUNTY TAX MAP DEPARTMENT
226 MIDDLE AVE. ELYRIA, OHIO

SURVEYED BY: THOMAS A. SIMON

CLOSURE: .00:10,000

MAP PAGE(S): 15-H

APPROVED BY: RRM DATE: 8-13-13

SCALE: 1"= 100 PRIOR INST.: DV 1368/75