




MASTER

PARENT PARCEL: 04-00-020-104-620, -621 (ST)

CHILD PARCEL: 04-00-020-104-644, -645

STARTING POINT: CENTERLINE OF LEAR NAGLE RD & COUNTRY CLUB DR

09-02779

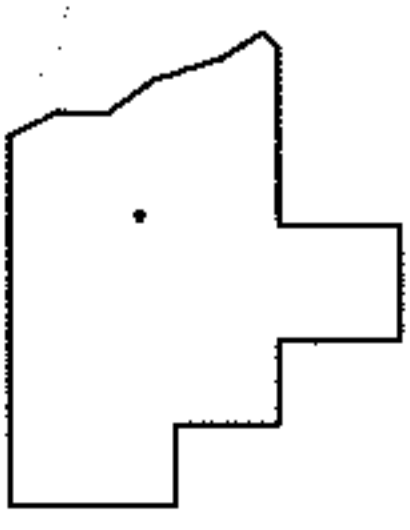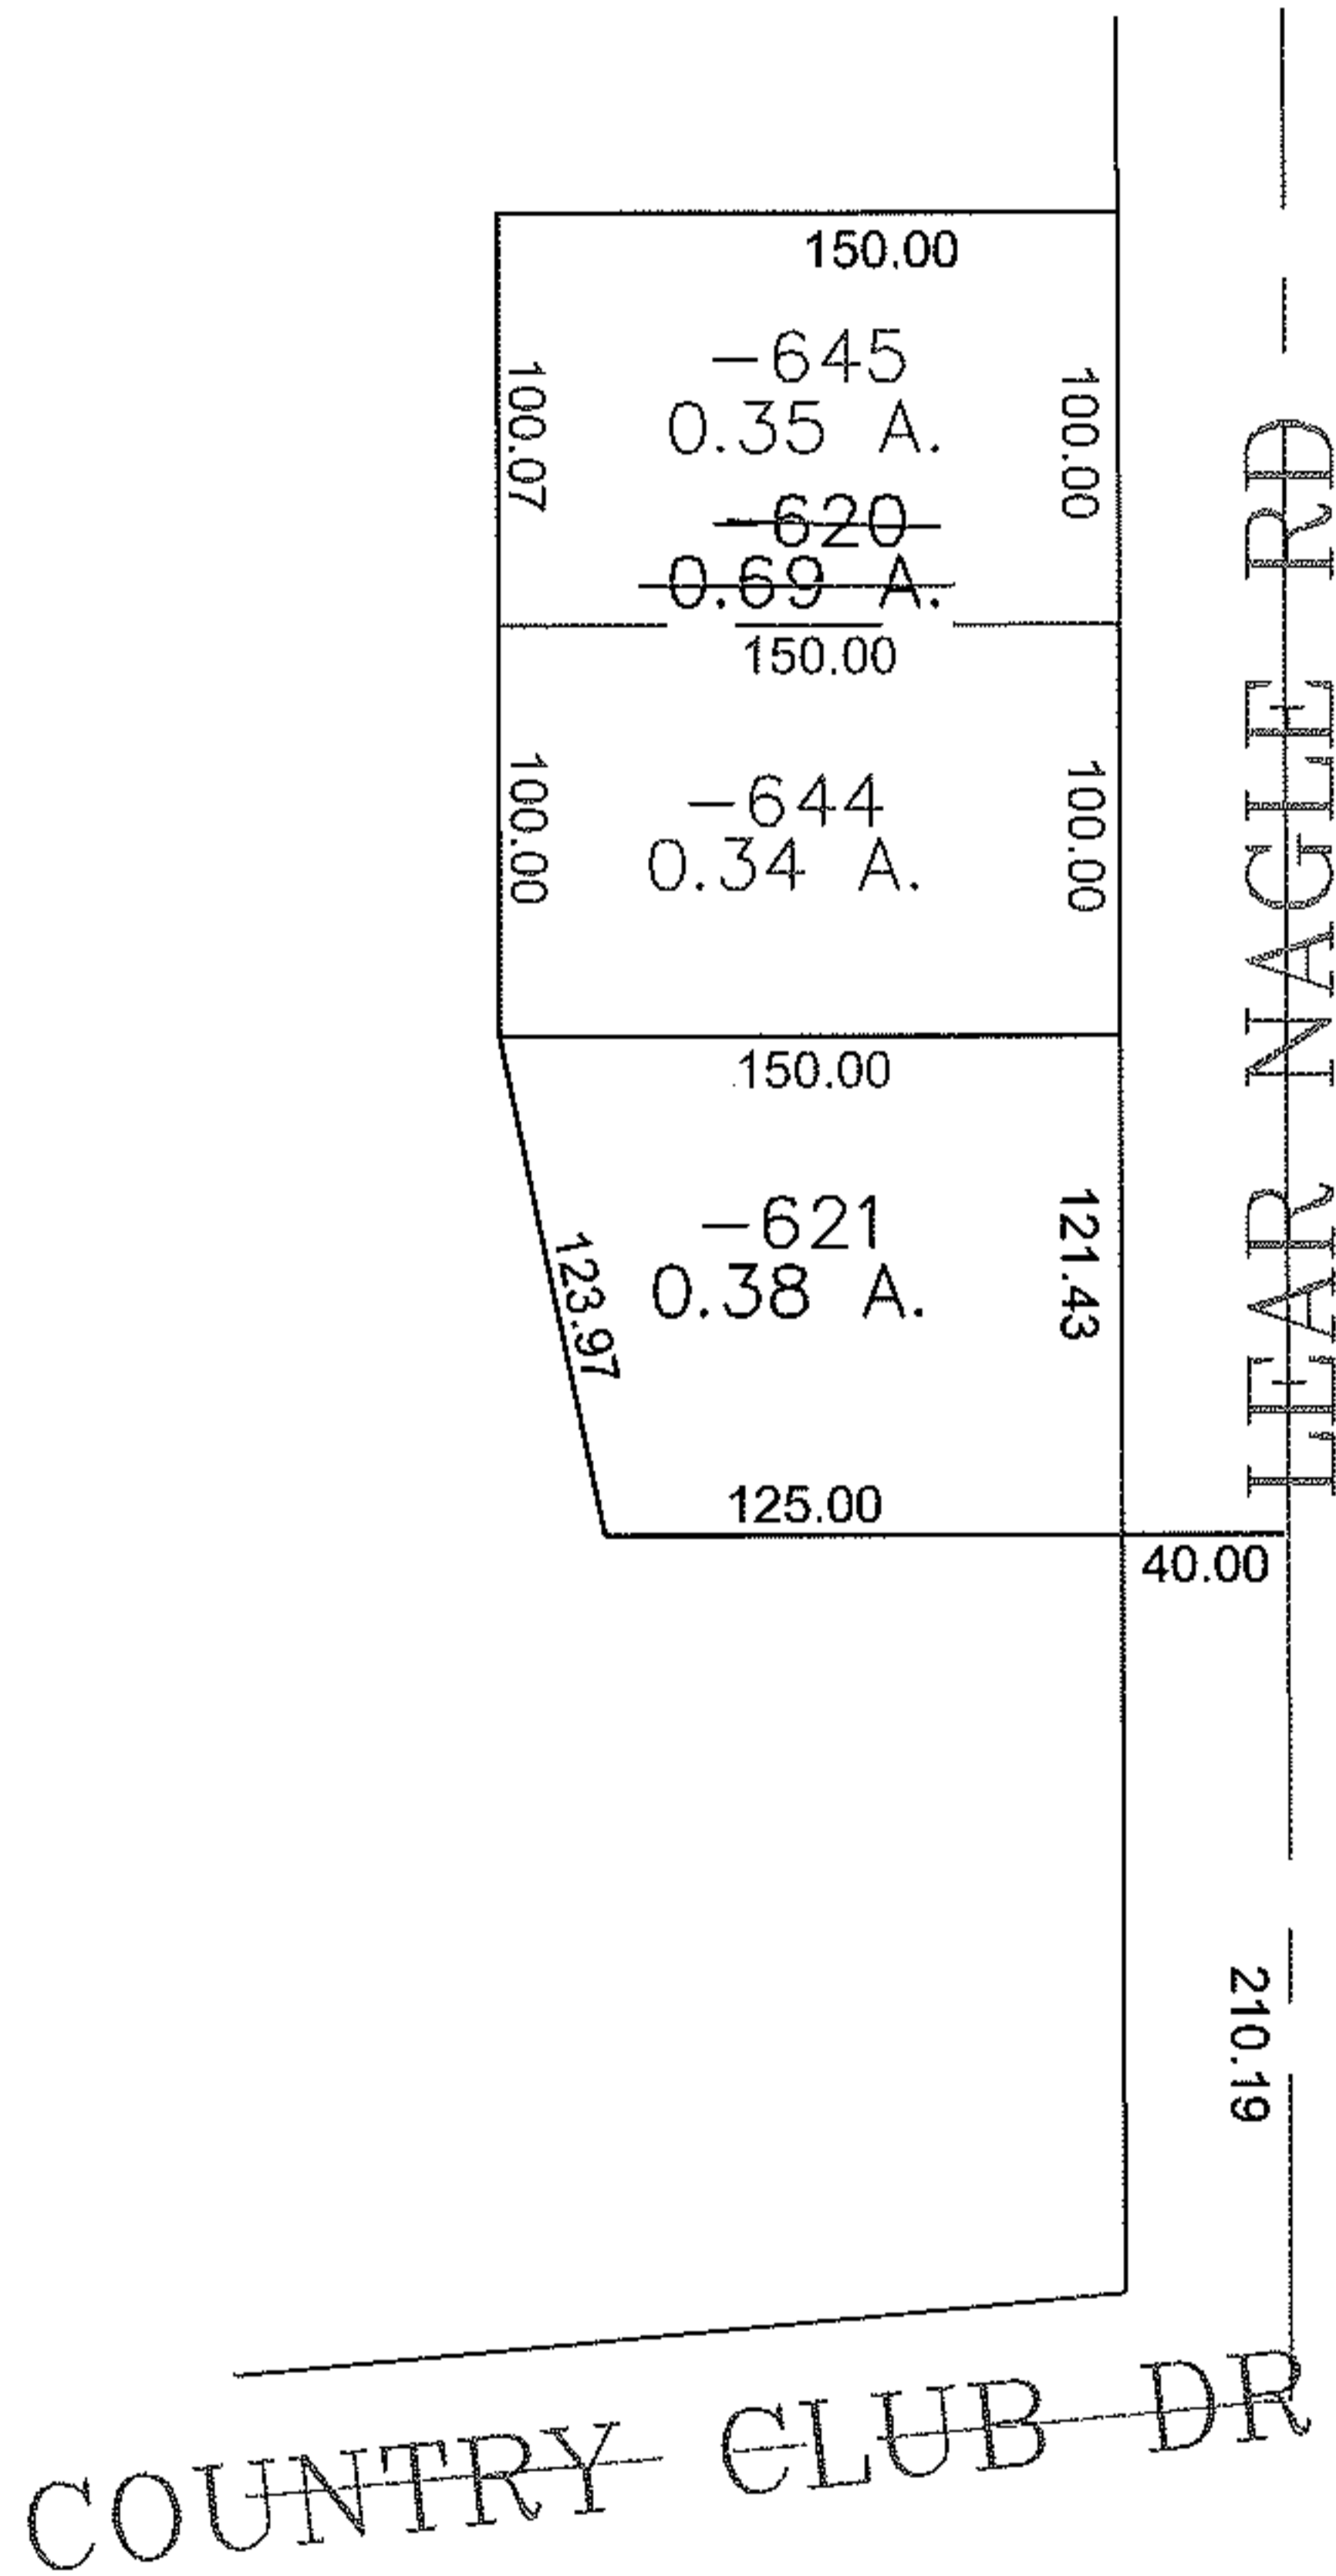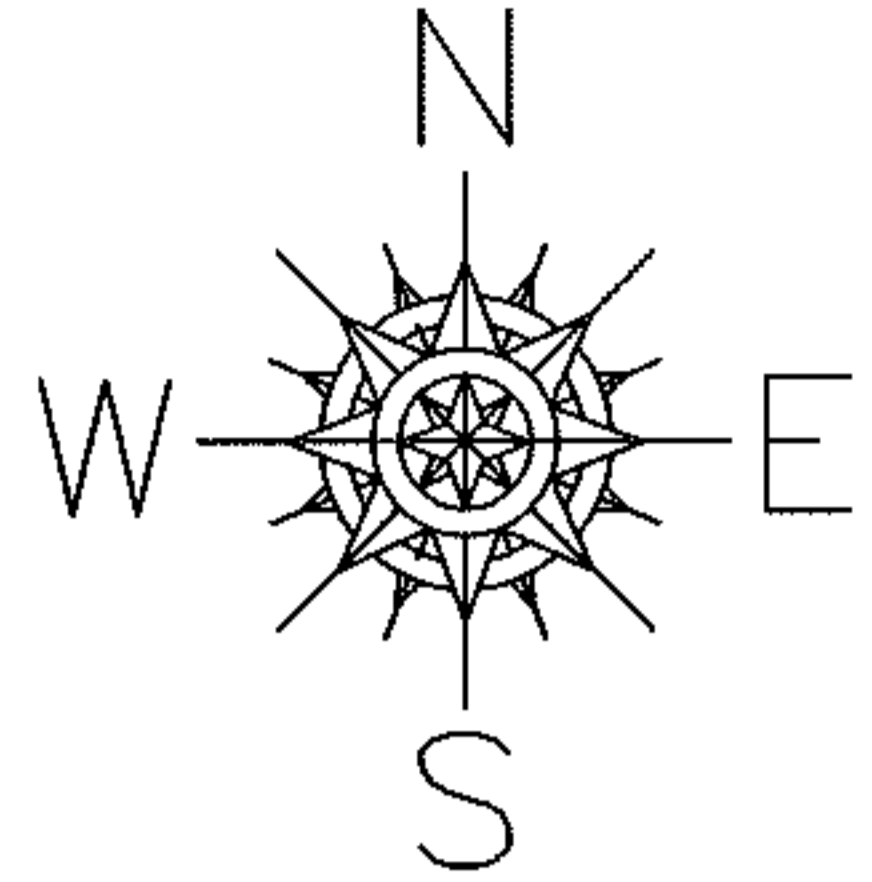

SPLITS/DEEDS PROCESSED

LORAIN COUNTY TAX MAP DEPARTMENT
226 MIDDLE AVE. ELYRIA, OHIO

SURVEYED BY: JAMES T SAYLER

CLOSURE: 0.00 : 10.000

MAP PAGE(S): 04-00-020-H

APPROVED BY: JAH DATE: 12-10-09

SCALE: 1" = 100 PRIOR INSTRUMENT: OR 96/342