
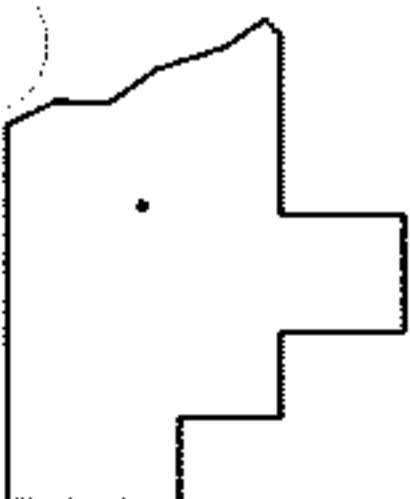
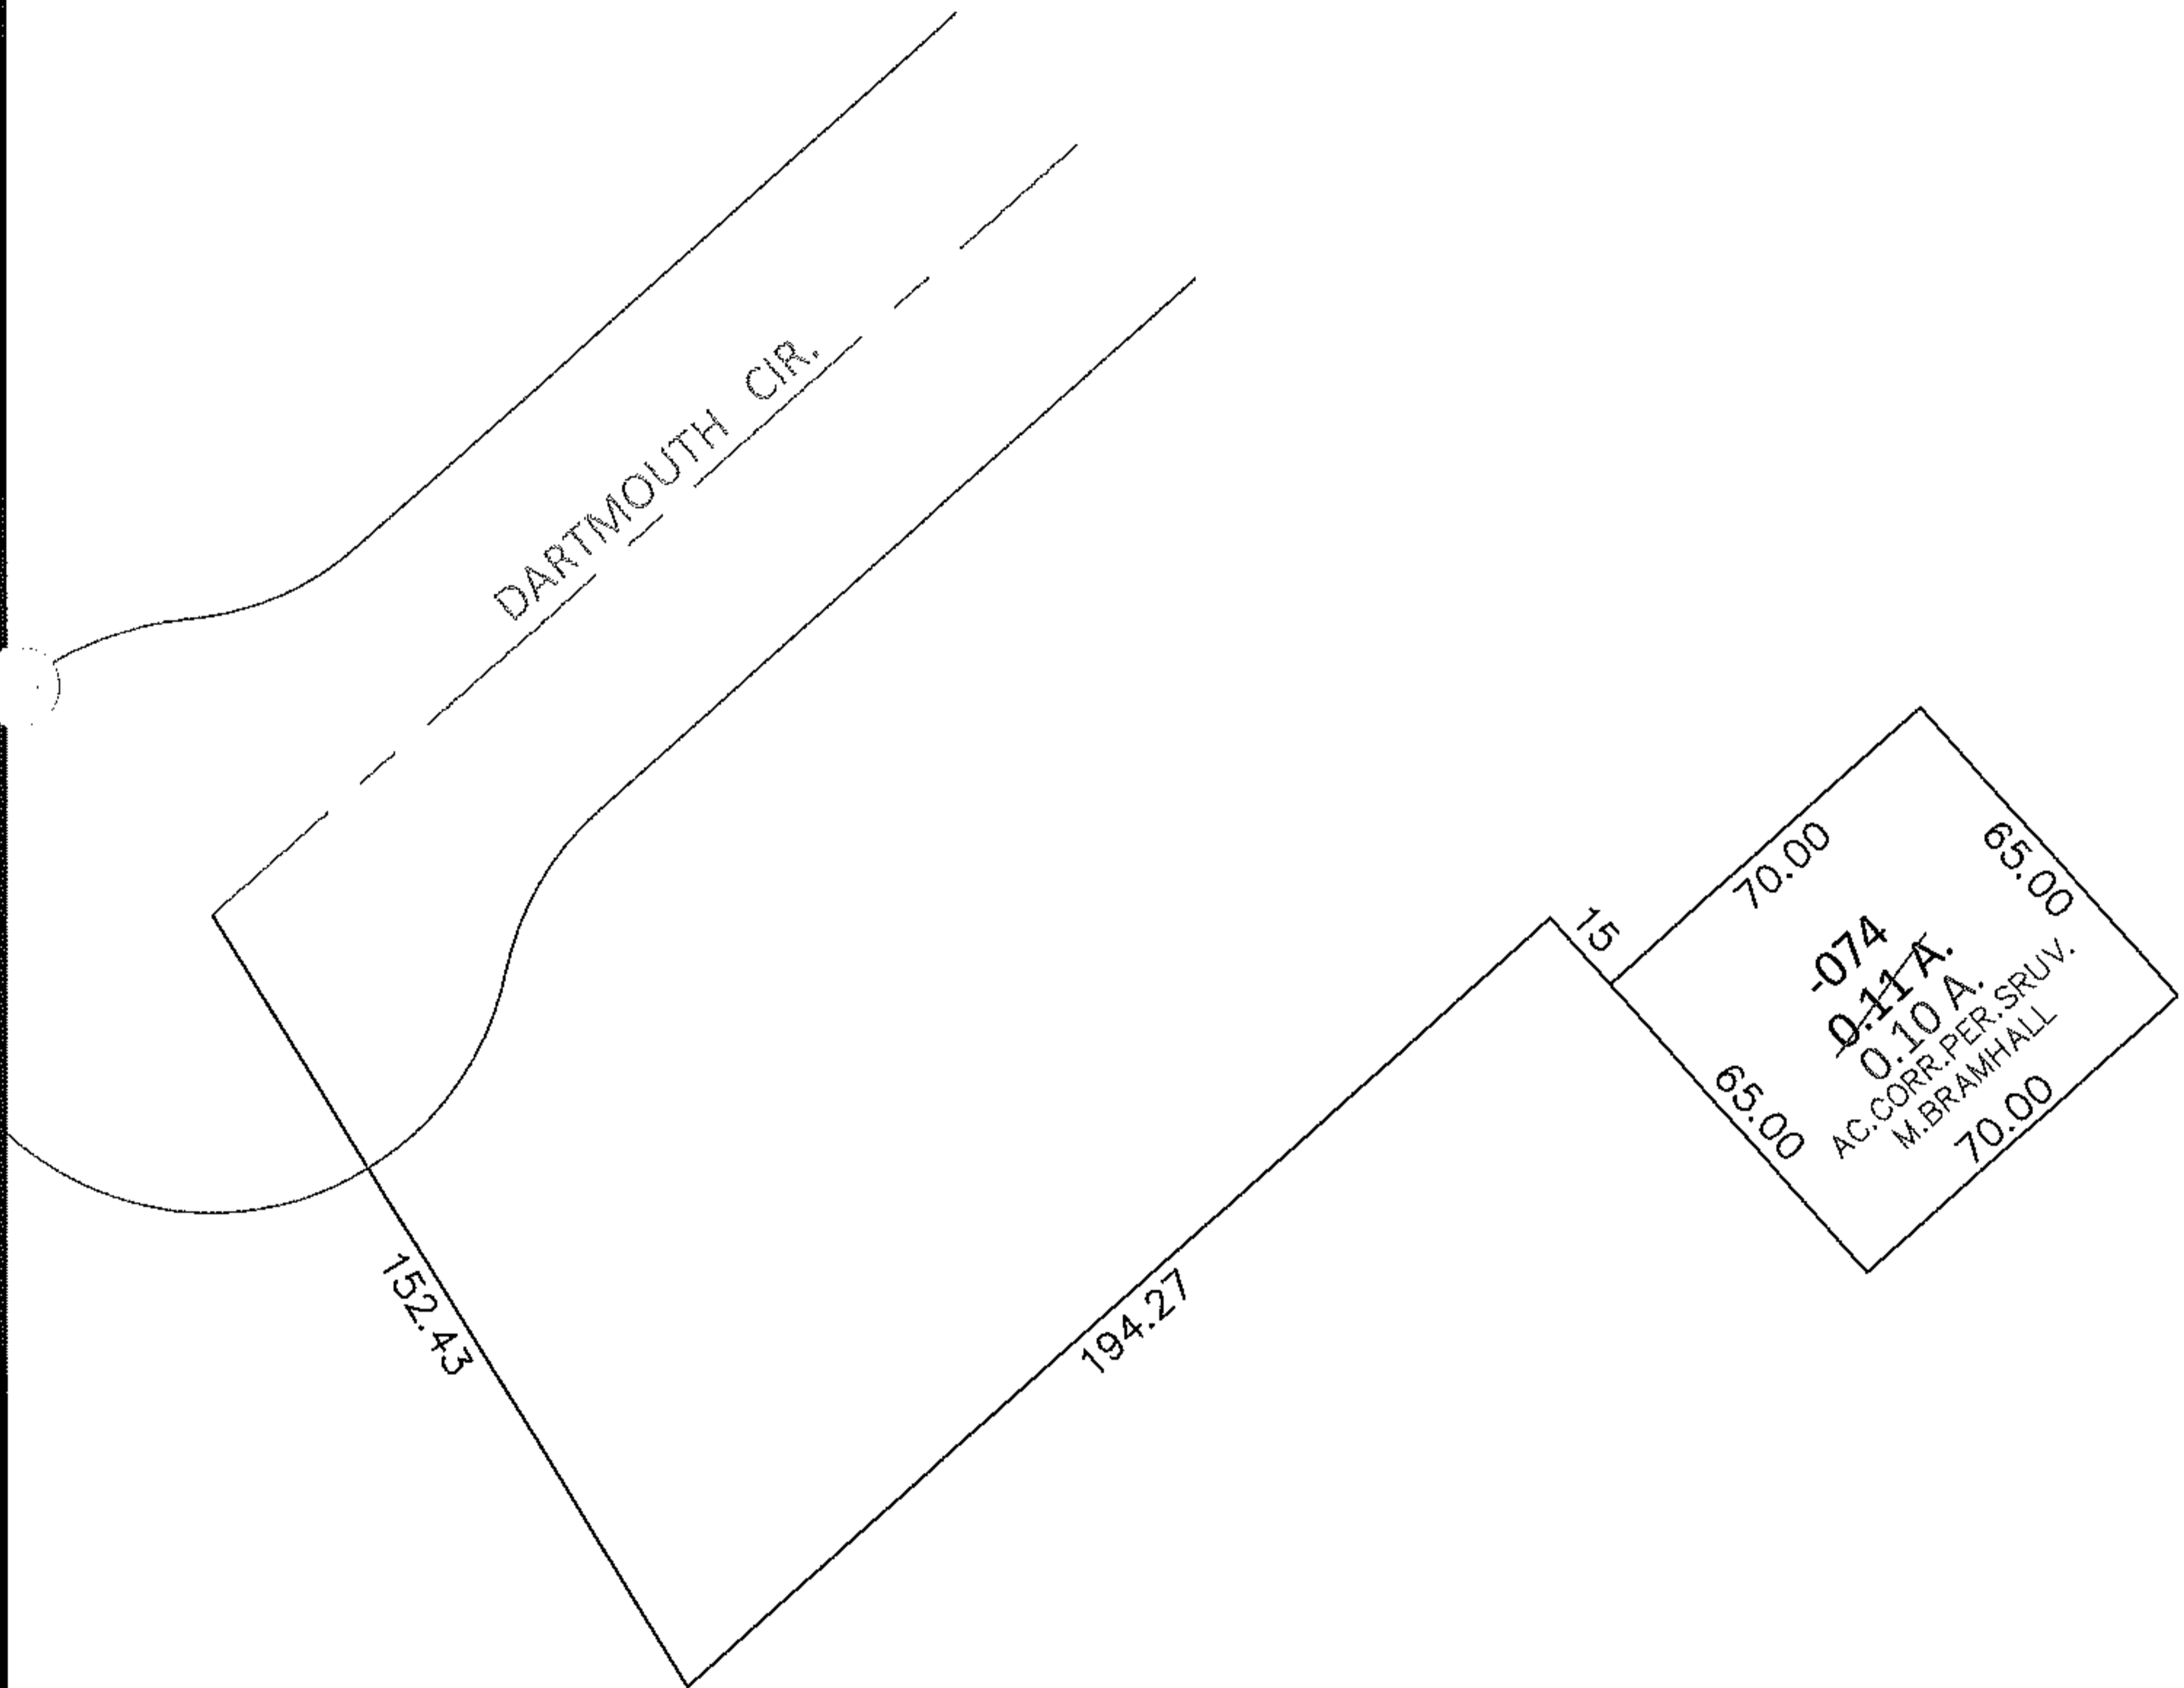


PARENT PARCEL: 06-25-002-113-074

CHILD PARCEL: \_\_\_\_\_

STARTING POINT: CENTER OF CUL-DE-SEC OF DARTMOUTH CIR.

13-02782-A

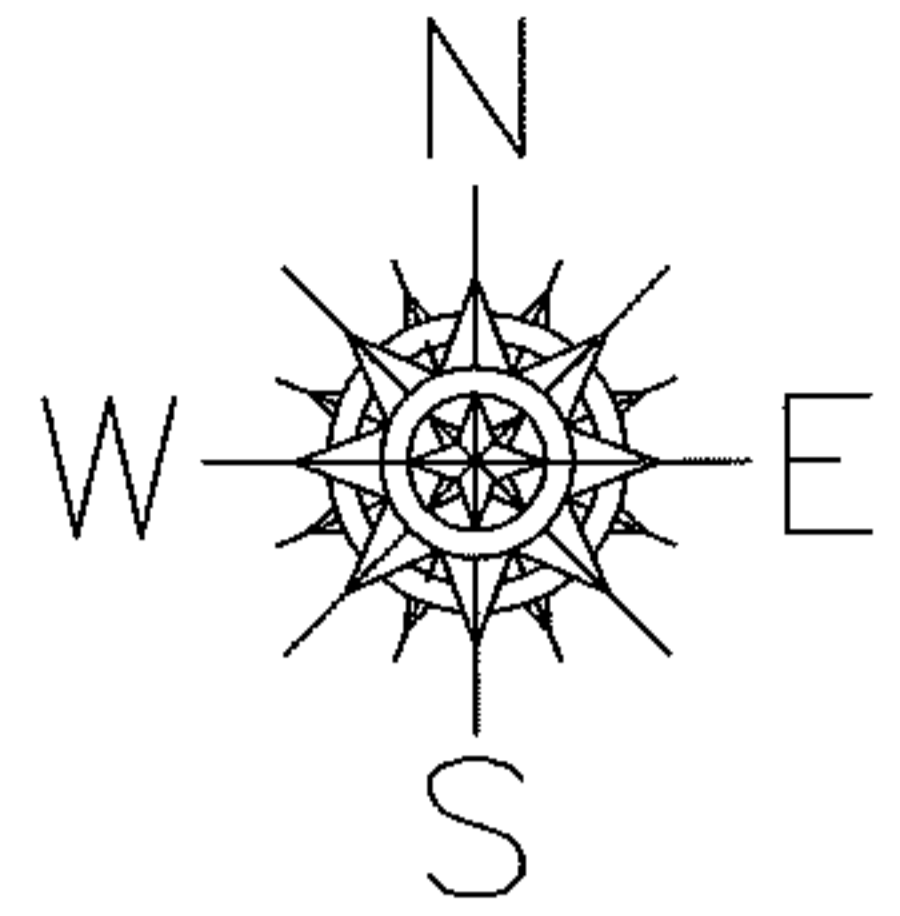

**SPLITS/DEEDS PROCESSED**

LORAIN COUNTY TAX MAP DEPARTMENT  
226 MIDDLE AVE. ELYRIA, OHIO

SURVEYED BY: MICHAEL BRAMHALL

CLOSURE: .00:10,000

MAP PAGE(S): 6-141

APPROVED BY: RRM DATE: 8-19-13

SCALE: 1"= 50' PRIOR INST.: 20130473740