



RASTER

PARENT PARCEL: 04-00-023-108-080, -003

CHILD PARCEL: 04-00-023-108-128 THRU -130

STARTING POINT: CENTERLINE OF SCHWARTZ RD & JAYCOX RD

09-02783

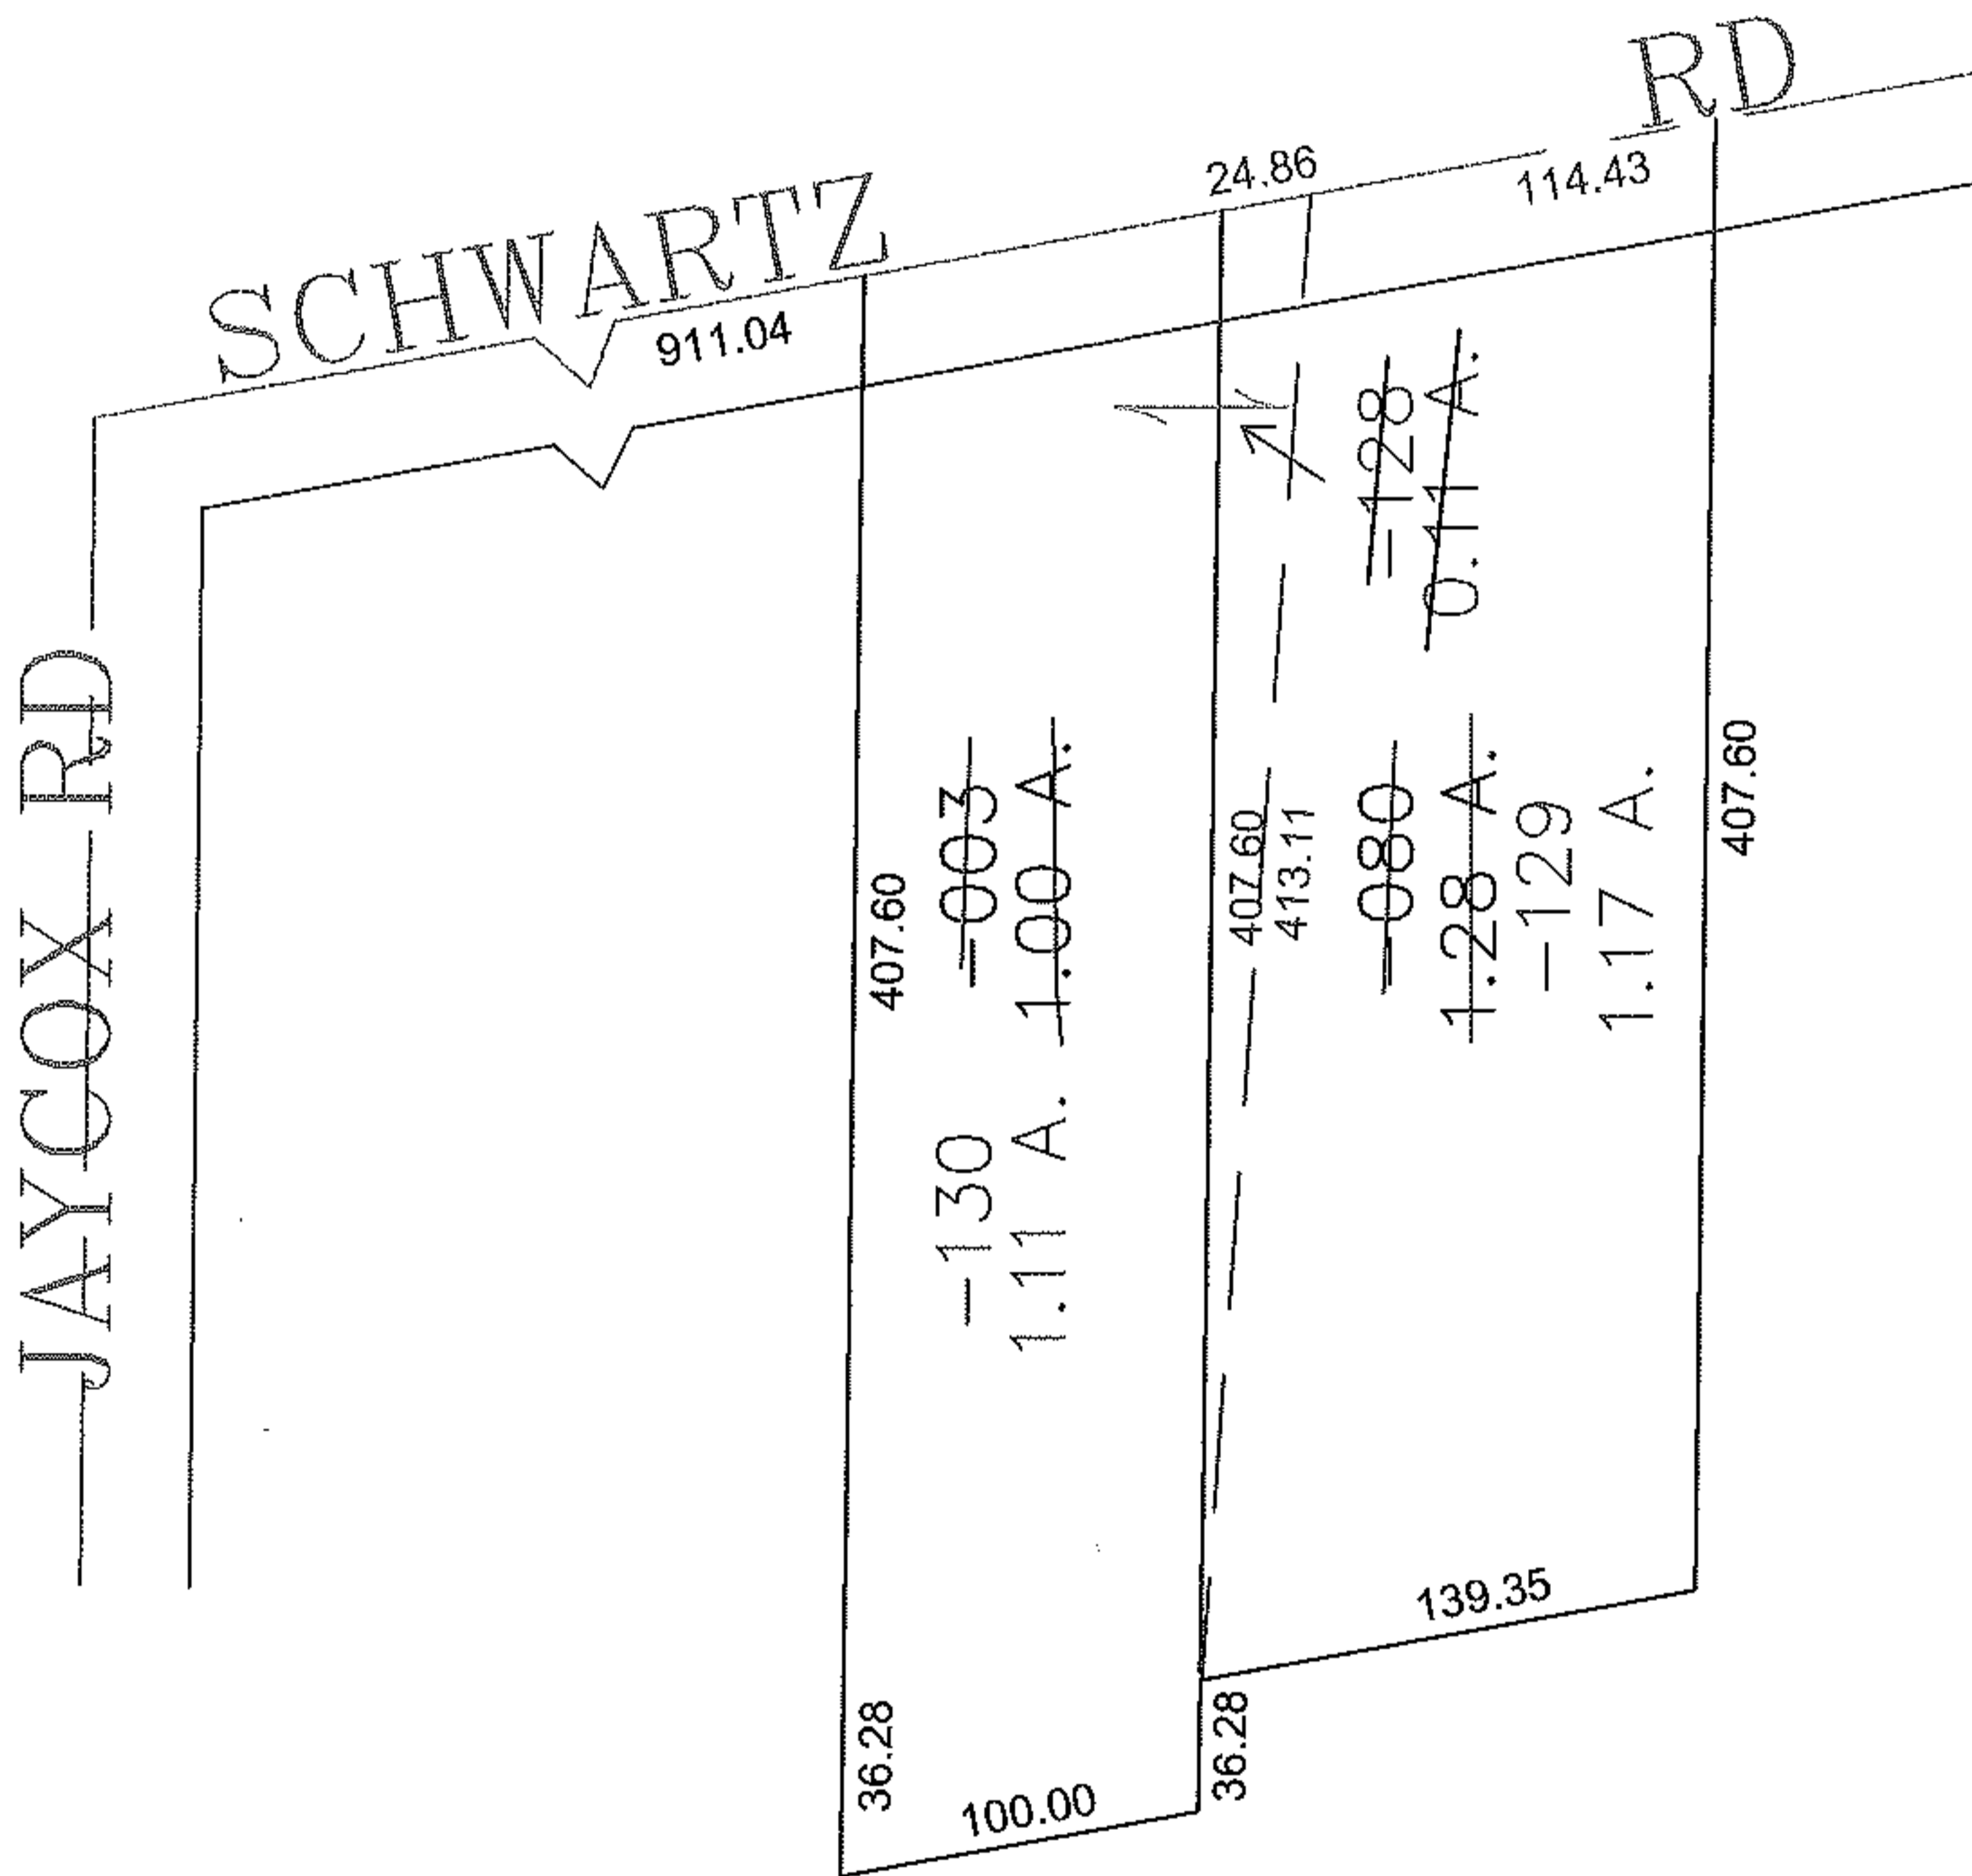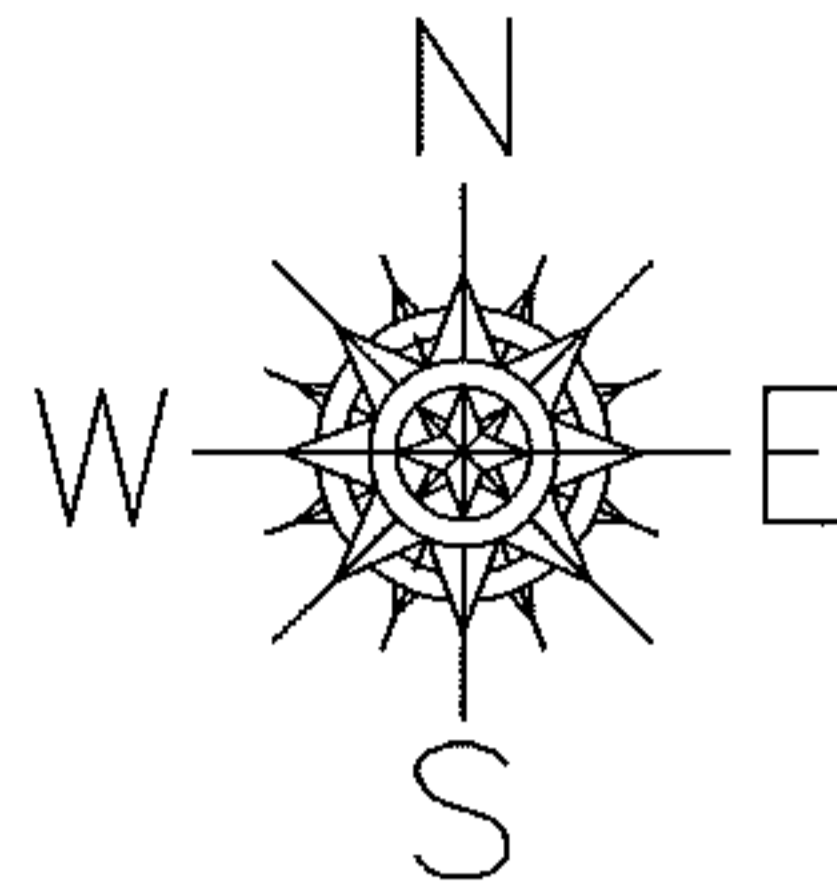

SPLITS/DEEDS PROCESSED

LORAIN COUNTY TAX MAP DEPARTMENT
226 MIDDLE AVE. ELYRIA, OHIO

SURVEYED BY: DANE HAPONEK

CLOSURE: 0.00 : 10.000

MAP PAGE(S): 04-00-023-G

APPROVED BY: JAH DATE: 12-15-09

SCALE: 1" = 100 PRIOR INSTRUMENT: 20090284171