

PARENT PARCEL: 11-00-075-000-012 & -025

CHILD PARCEL: 11-00-075-000-044

STARTING POINT: CL OF DURKEE RD. & CL OF ELYRIA-TWINSBURG (S.R. 82)


NO. 09-02787

COMBINATION


~~11-00-075-000-012~~
~~0.13 A.~~

~~11-00-075-000-025~~
~~0.50 A.~~

11-00-075-000-044
0.63 A.

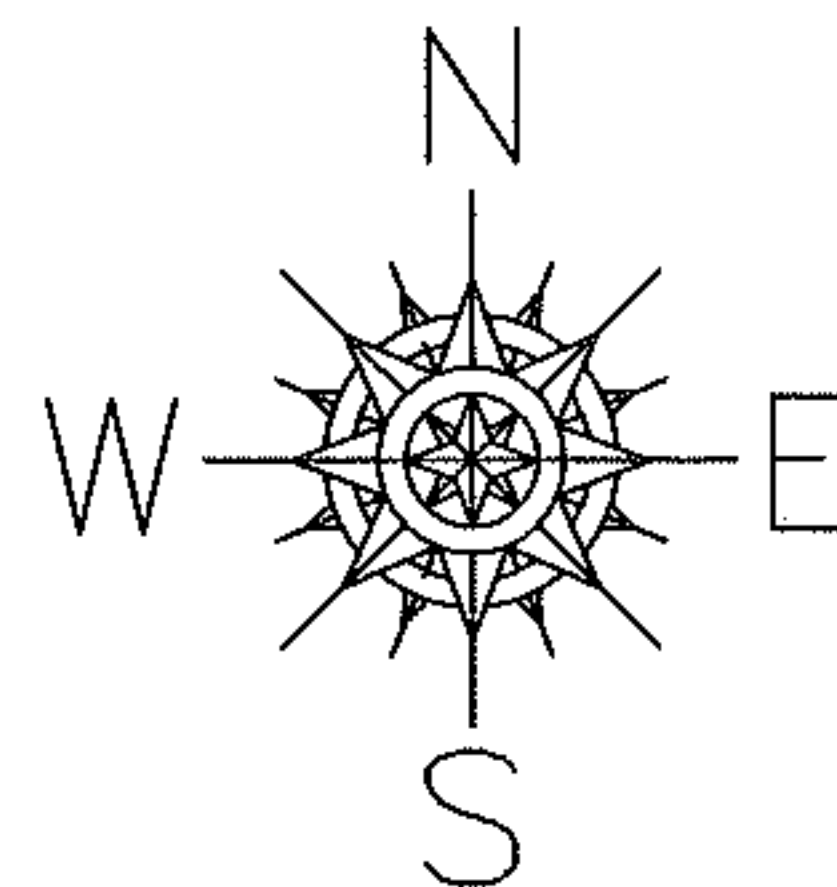

DURKEE RD. 60'

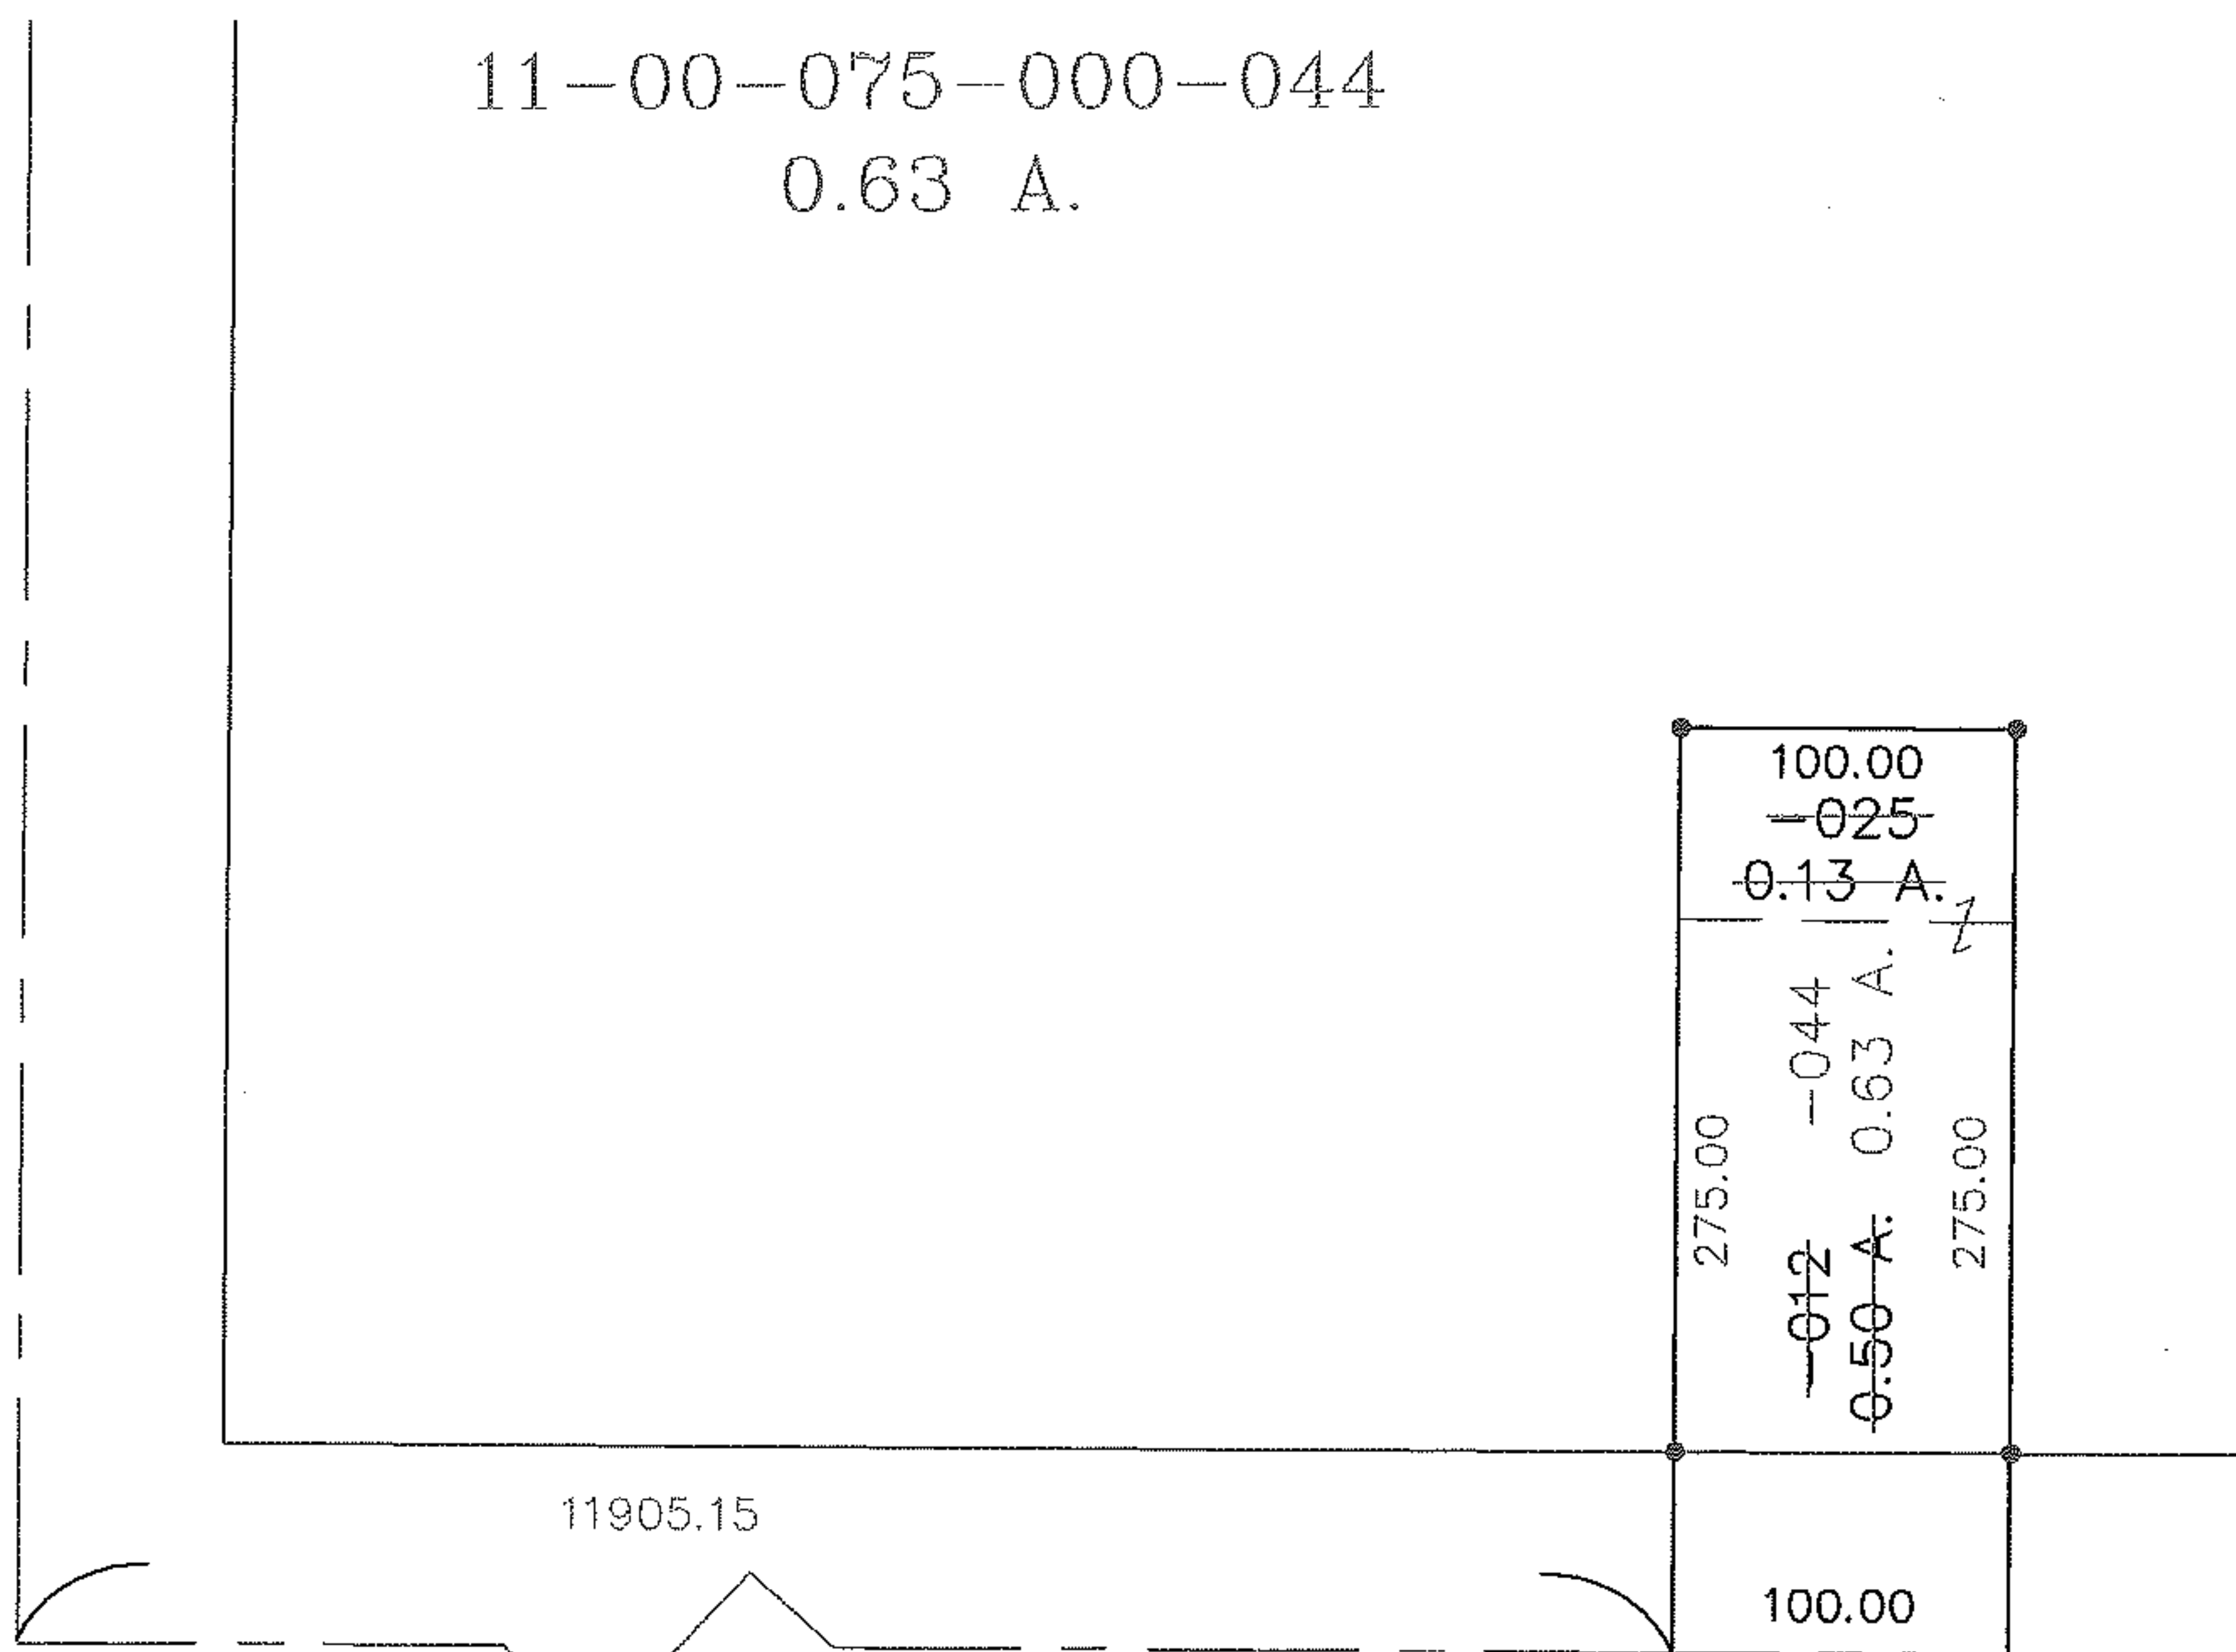

ELYRIA - TWINSBURG RD. (S.R. 82) 120'

SPLITS/DEEDS PROCESSED

LORAIN COUNTY TAX MAP DEPARTMENT
226 MIDDLE AVE. ELYRIA, OHIO

SURVEYED BY: RICHARD A. FREDRICKSON

CLOSURE: 0.00 : 10,000

MAP PAGE(S): 11-00-075B

APPROVED BY: TJS DATE: 12/23/09

SCALE: 1" = 100 PRIOR INSTRUMENT: OR 592/610