
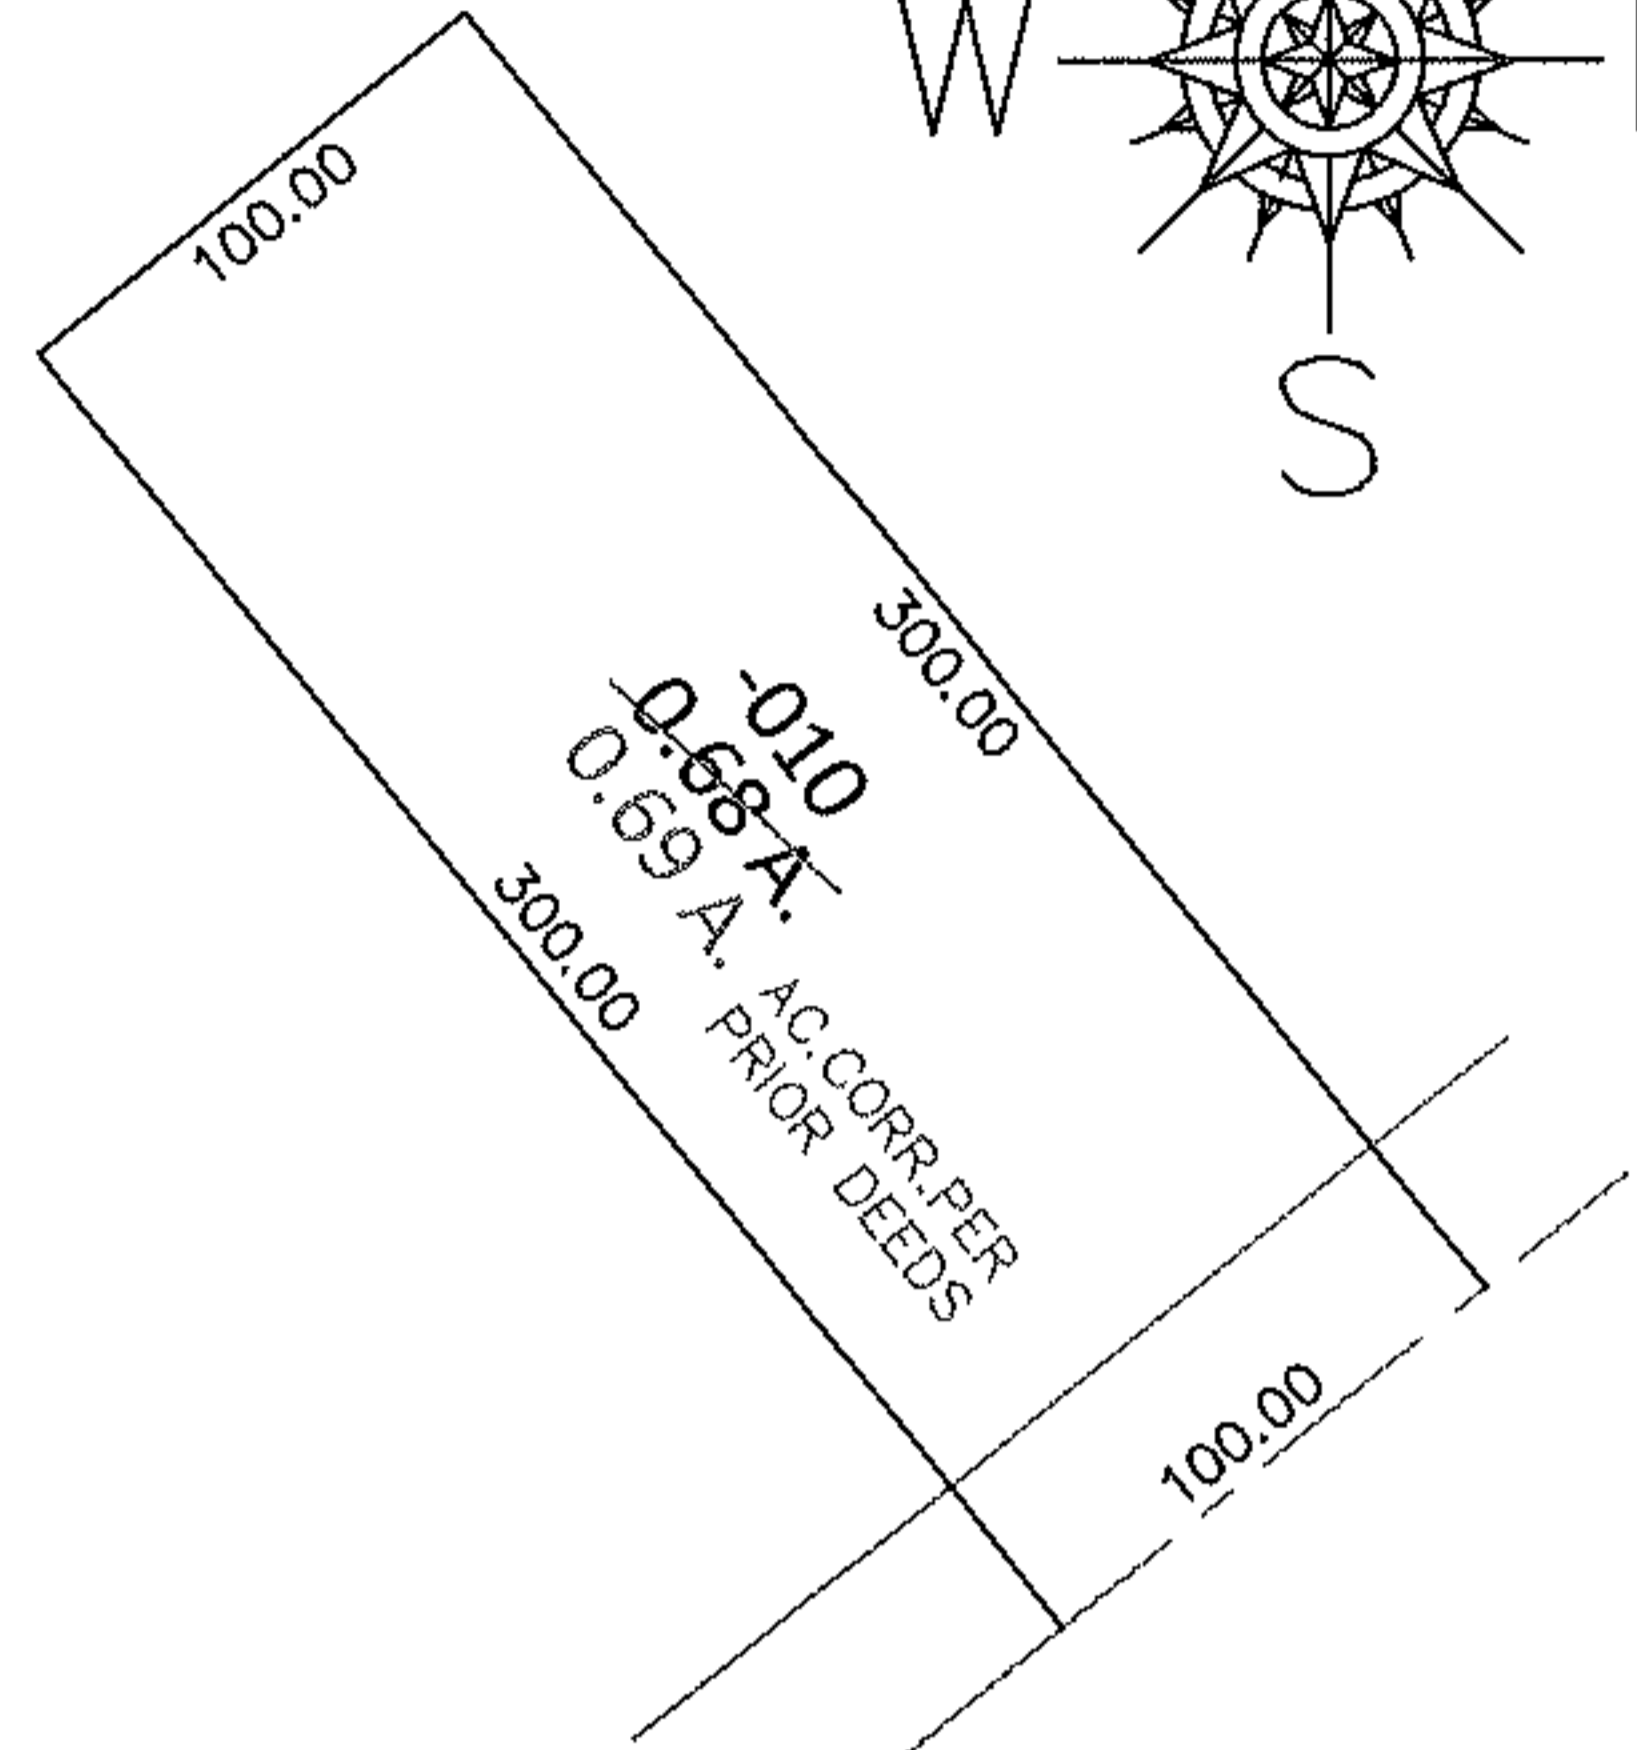


PARENT PARCEL: 05-00-097-102-010

CHILD PARCEL: \_\_\_\_\_

13-02788-A

STARTING POINT: INTERSECTION OF C/L OF CROSSE RD. AND C/L OF NORTH RIDGE RD.

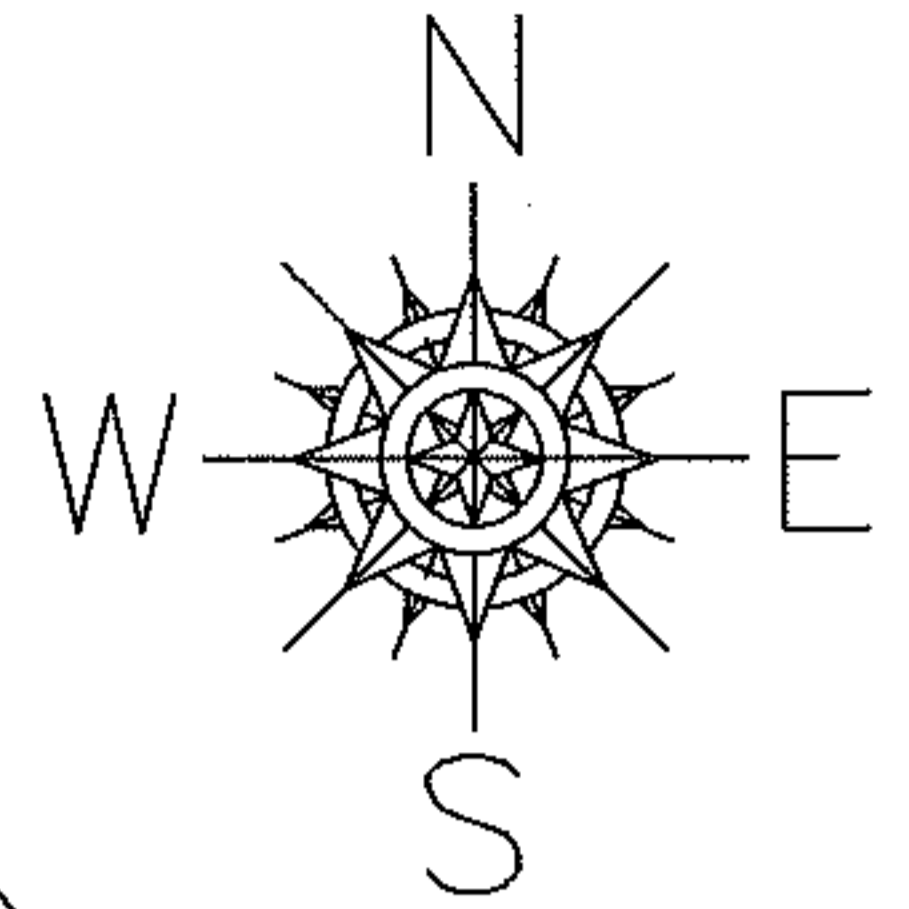


CROSSE RD.

NORTH RIDGE RD.

357.75

642.25

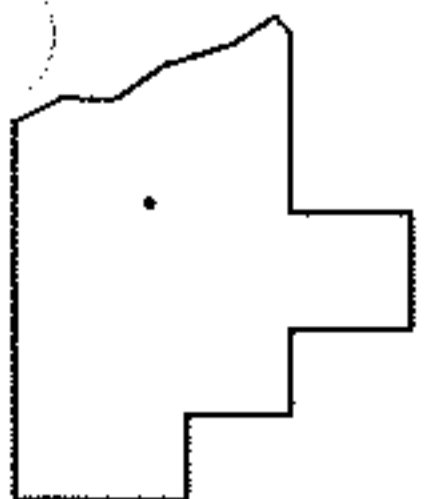

**SPLITS/DEEDS PROCESSED**

LORAIN COUNTY TAX MAP DEPARTMENT  
226 MIDDLE AVE. ELYRIA, OHIO

SURVEYED BY: N/A

CLOSURE: .00:10,000

MAP PAGE(S): 5-00-097-B

APPROVED BY: RRM DATE: 8-23-13

SCALE: 1"= 100 PRIOR INST.: 20130474410