
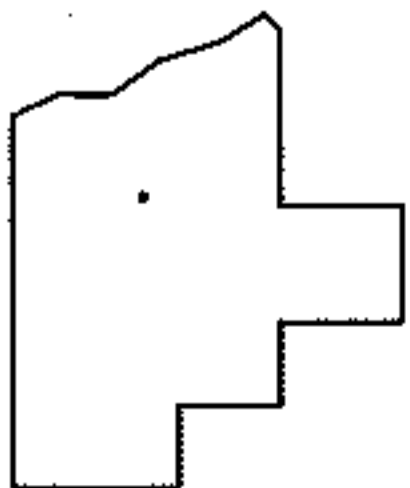
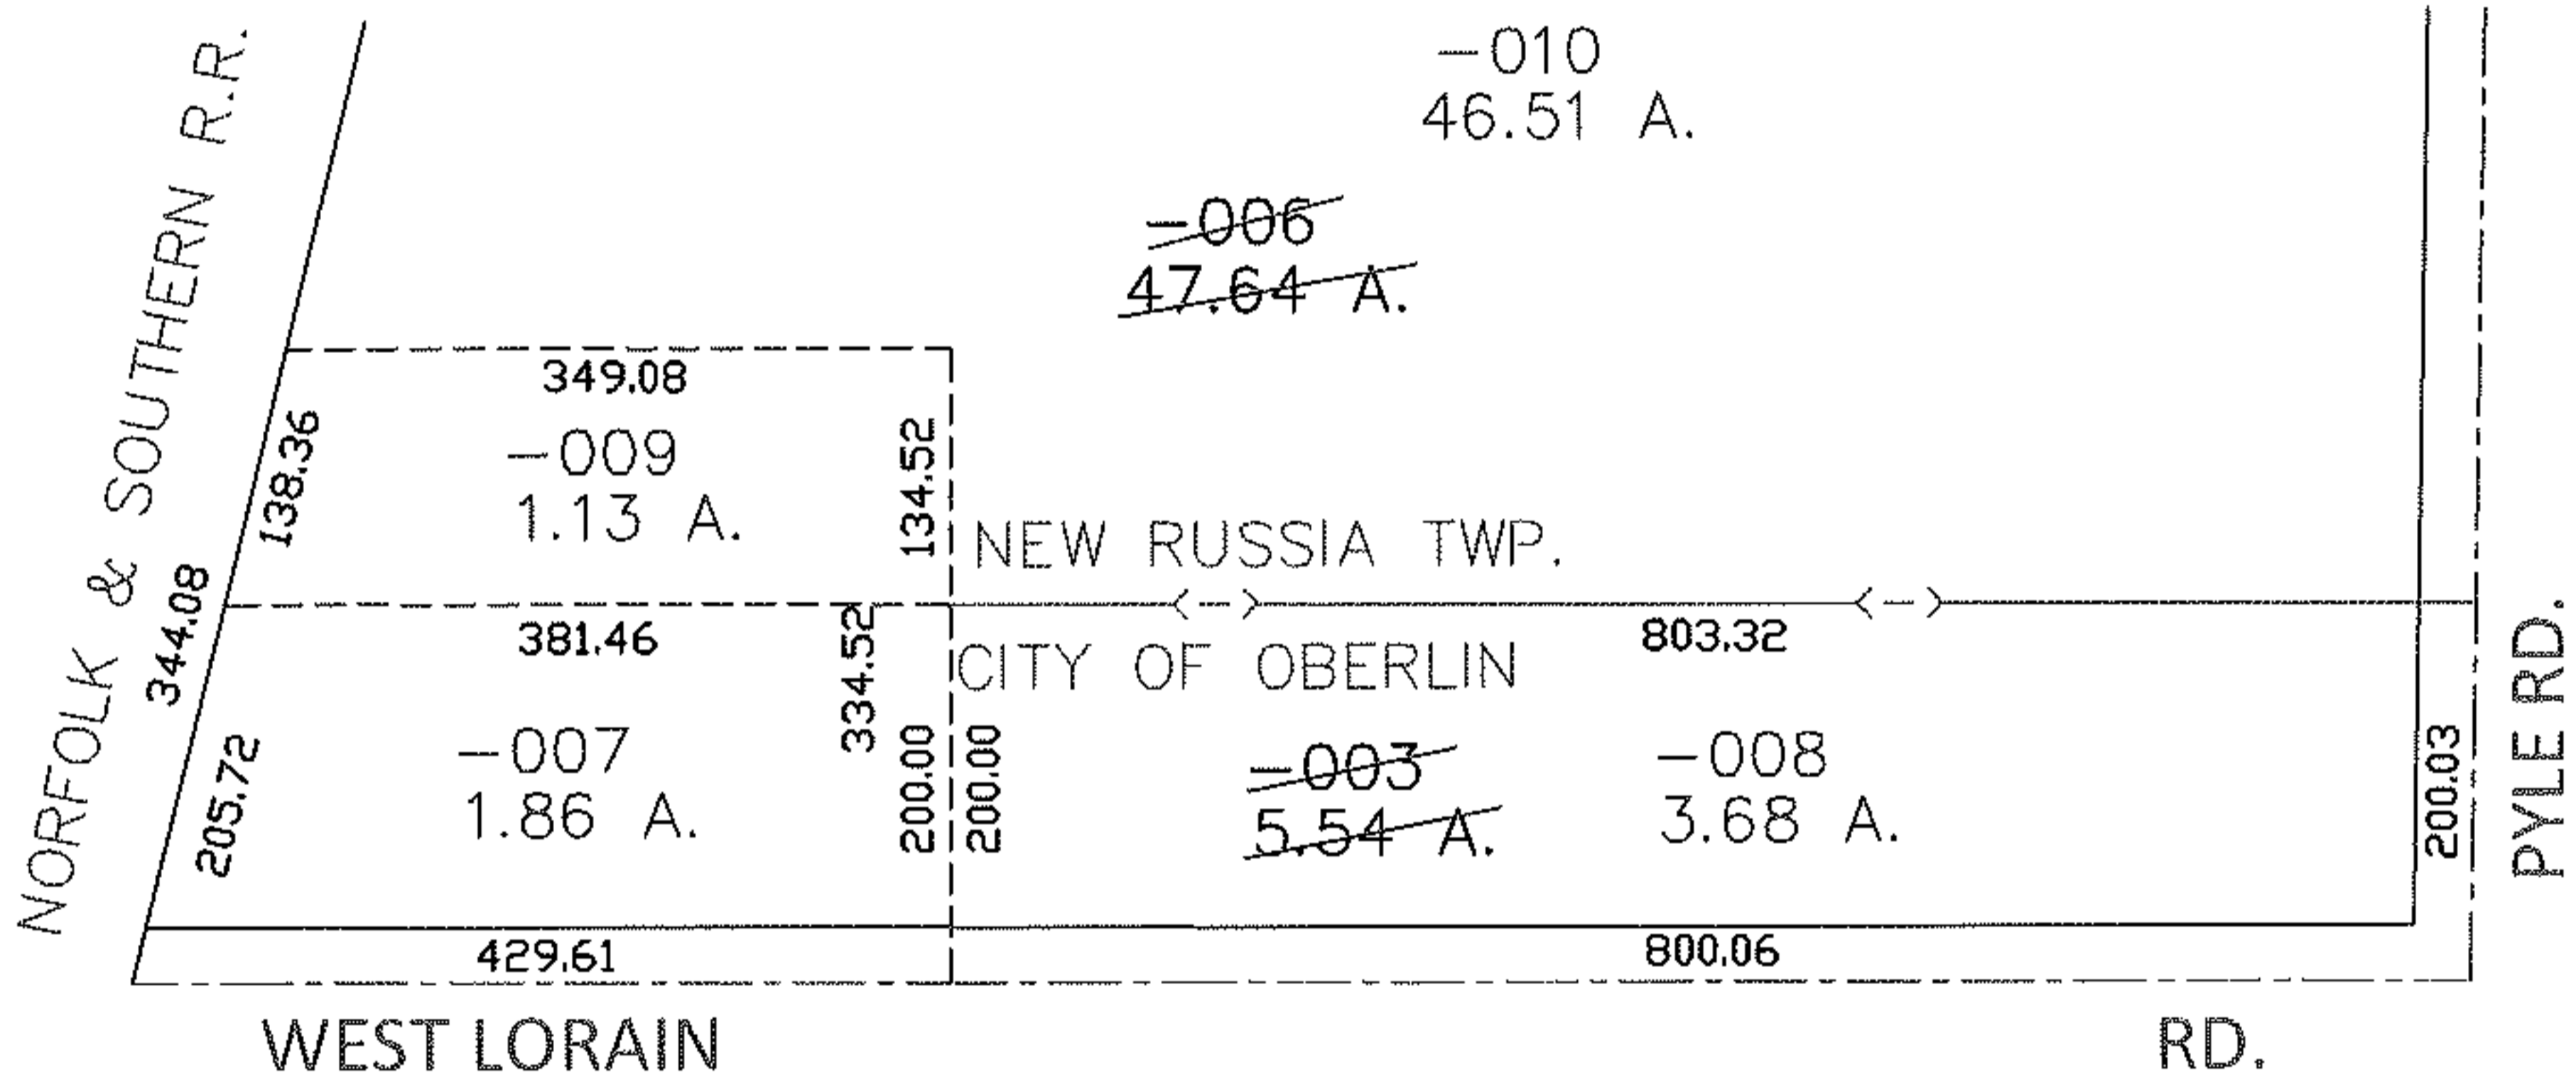


PARENT PARCEL: 09-00-073-000-003,-006

CHILD PARCEL: 09-00-073-000-007 THRU -010

STARTING POINT: INTERSECTION OF C/L OF PYLE RD. AND C/L OF WEST LORAIN RD.

09-02790

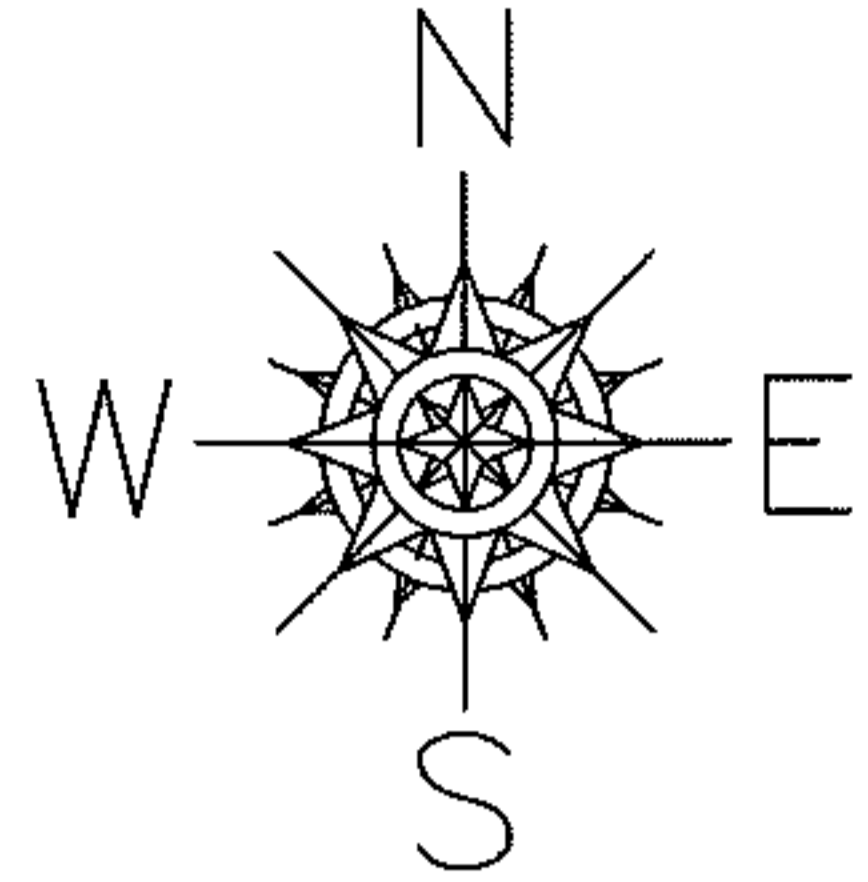

**SPLITS/DEEDS PROCESSED**

LORAIN COUNTY TAX MAP DEPARTMENT  
226 MIDDLE AVE. ELYRIA, OHIO

SURVEYED BY: DALE R. HAYWOOD

CLOSURE: .01:10,000

MAP PAGE(S): 9-00-073-B

APPROVED BY: RRM DATE: 12-23-09

SCALE: 1"= 200 PRIOR INST.: 20040038922