
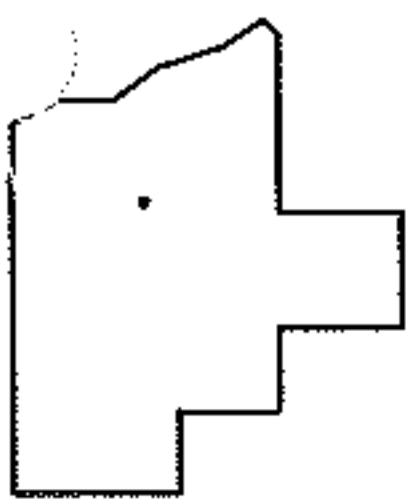
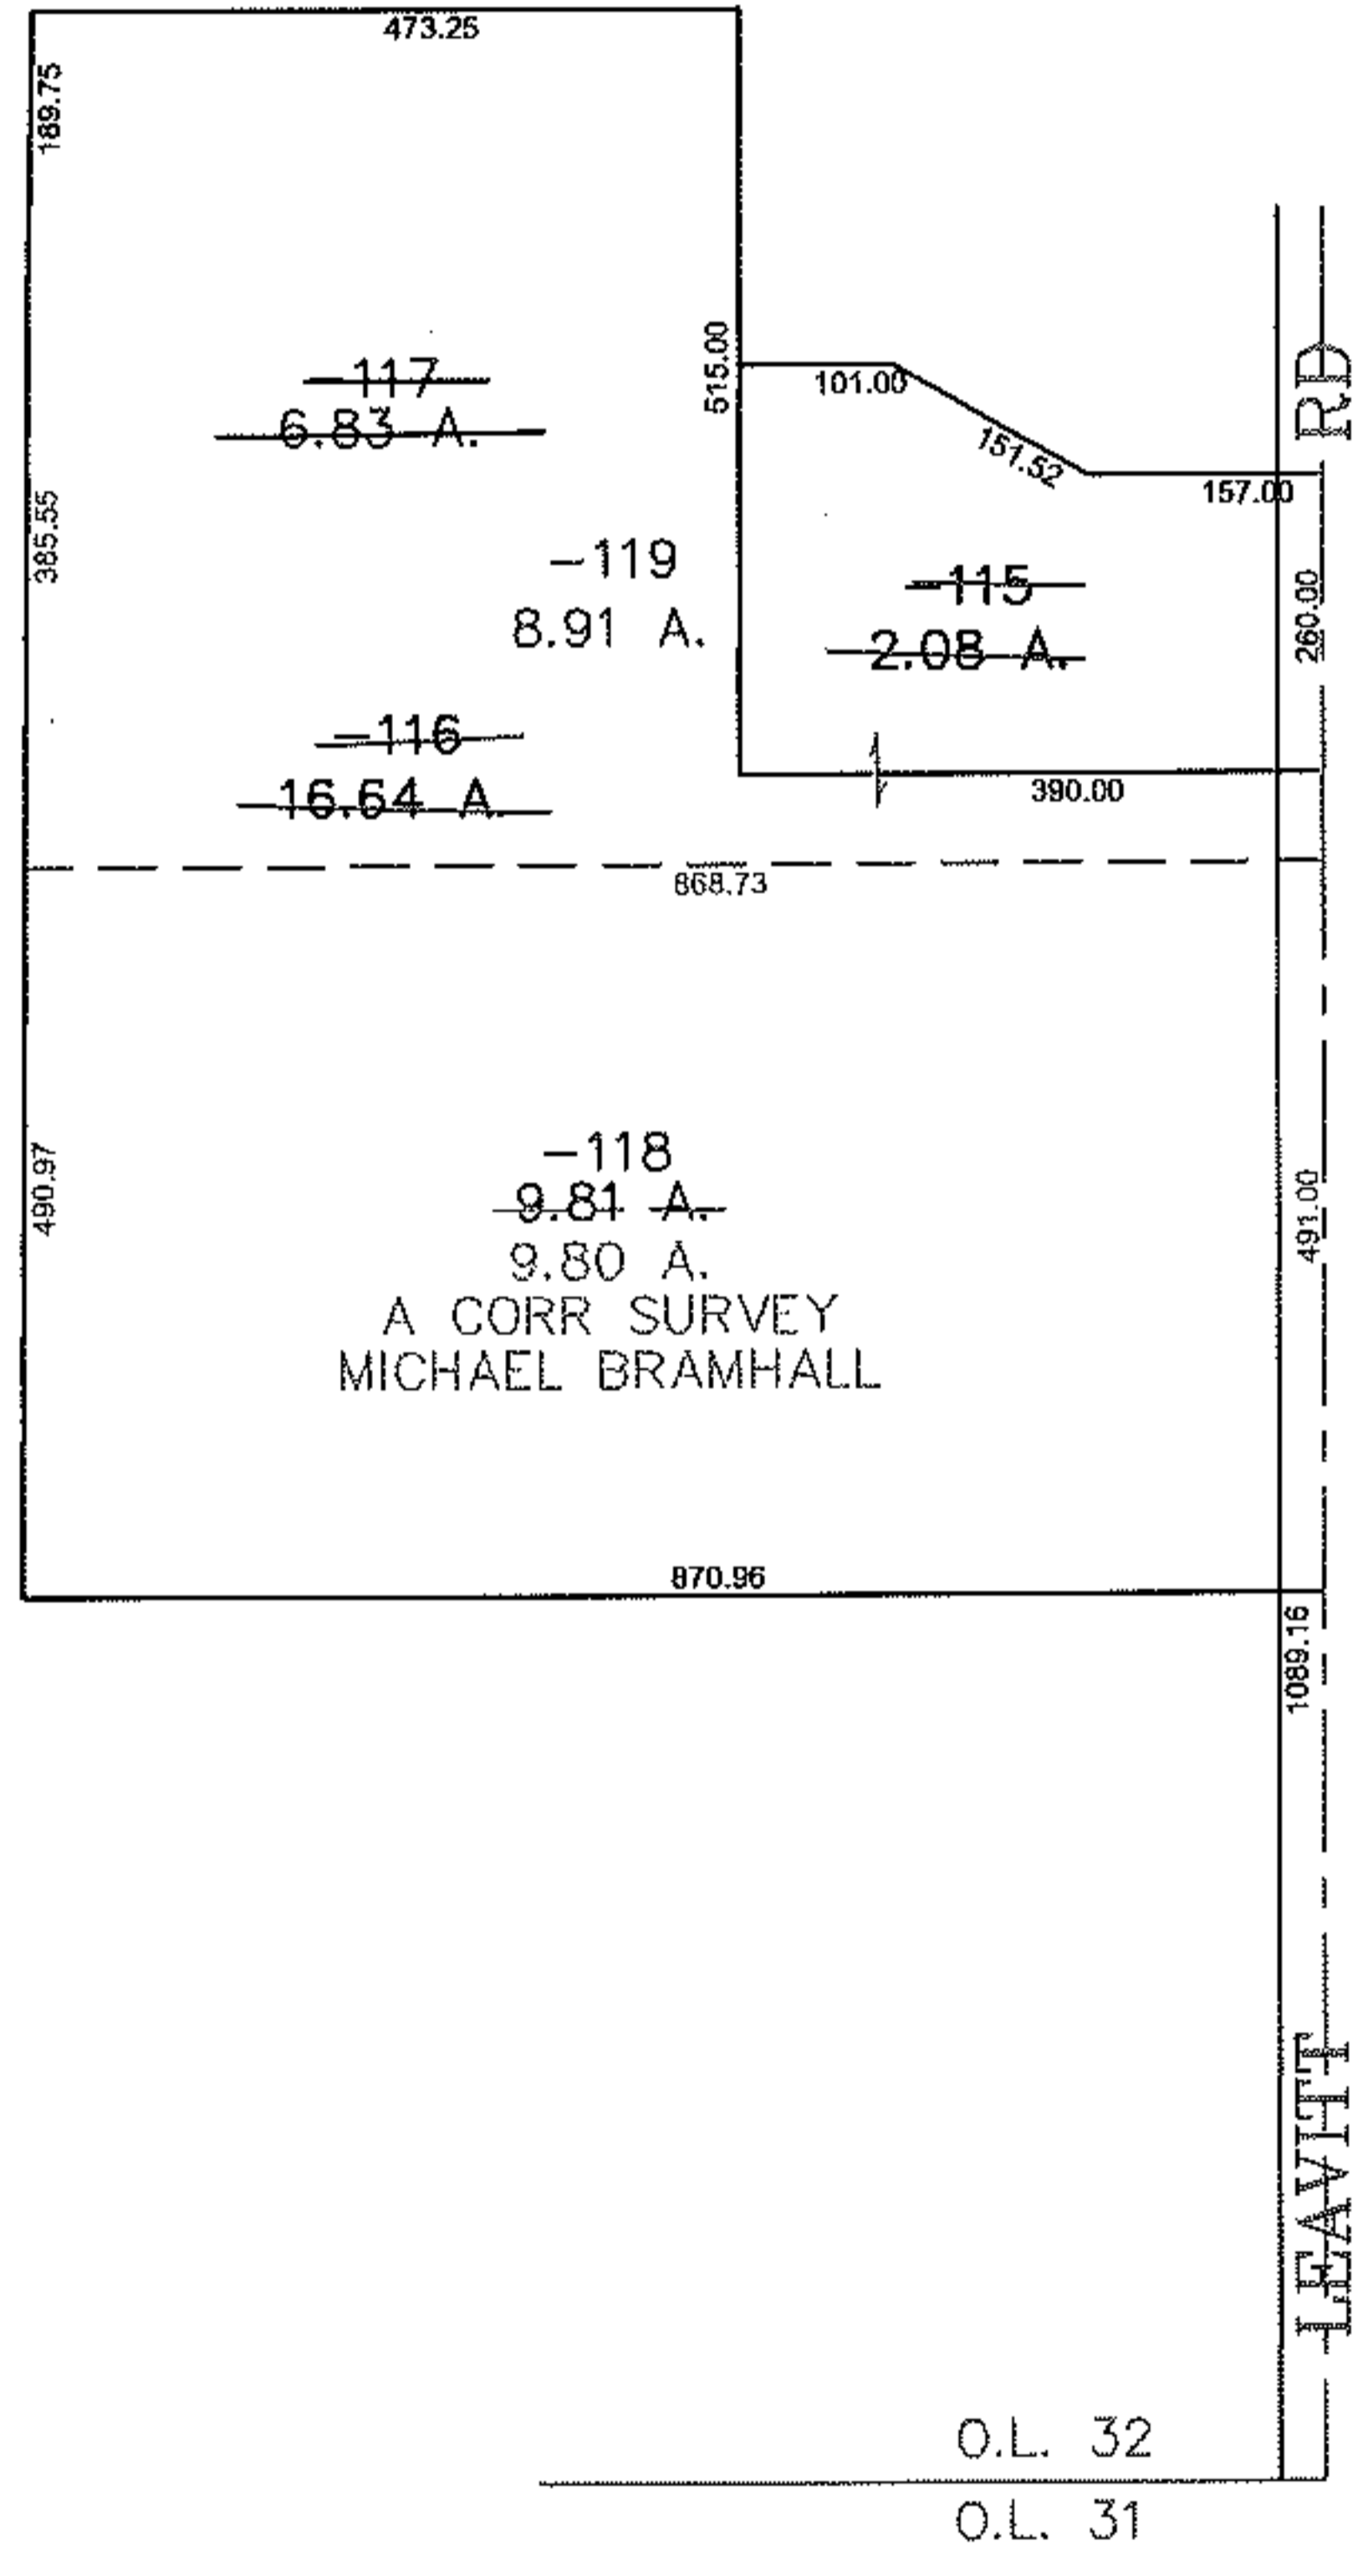


PARENT PARCEL: 05-00-032-000-116, -115  
CHILD PARCEL: 05-00-032-000-117 THRU -119  
STARTING POINT: CENTERLINE OF LEAVITT RD & O.L. 32

10-02793

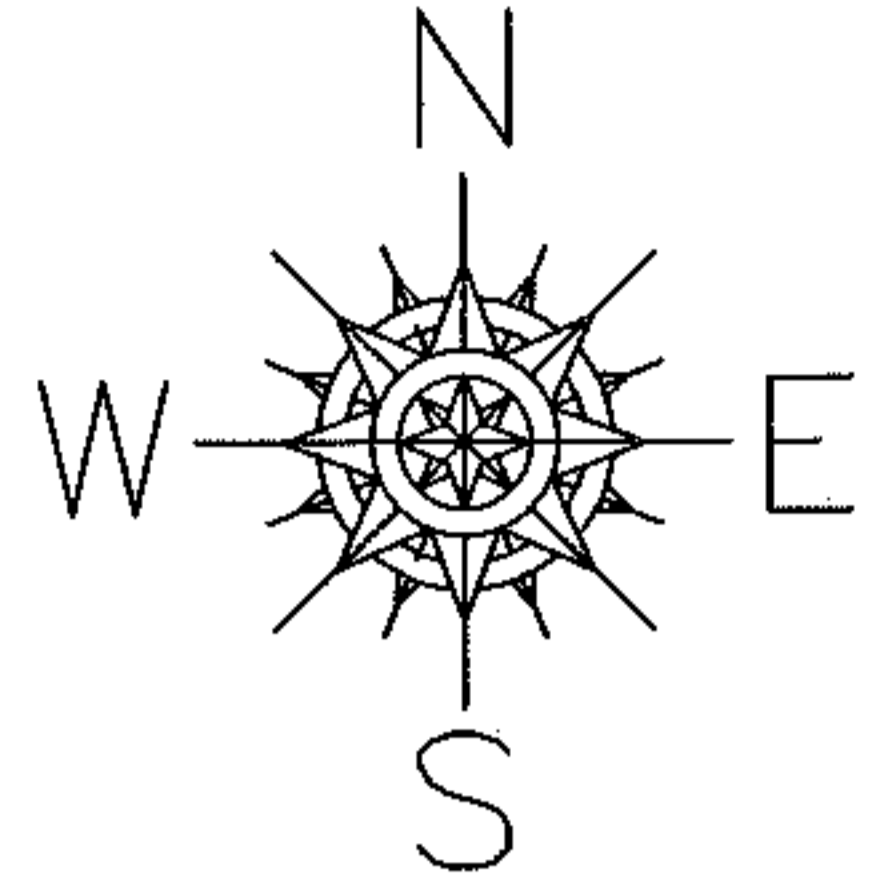

**SPLITS/DEEDS PROCESSED**  
LORAIN COUNTY TAX MAP DEPARTMENT  
226 MIDDLE AVE. ELYRIA, OHIO

SURVEYED BY: MICHAEL BRAMHALL  
CLOSURE: 0.00 : 10,000  
MAP PAGE(S): 05-00-032-B  
APPROVED BY: JAH DATE: 1-4-10  
SCALE: 1" = 300 PRIOR INSTRUMENT: OR 295/395