

PARENT PARCEL: 16-00-095-000-001, -002, 16-00-094-000-011

CHILD PARCEL: 16-00-095-000-027

STARTING POINT: CENTERLINE OF WOOSTER-AVON LAKE RD & NEFF RD

10-02794

COMBINATION

ACREAGE CORRECTION

~~16-00-095-000-001~~

~~36.42 A.~~

~~16-00-095-000-002~~

~~32.15 A.~~

16-00-095-000-027

~~68.57 A.~~

68.78 A.

AC. CORR. PER SURV.
RICHARD CARLSON

16-00-094-000-011

~~15.12 A.~~

15.11 A.



AC. CORR. PER SURV.
RICHARD CARLSON

ADD TO DUP.

16-00-095-000-028

0.01 A.

PER DEED
V. J PG. 137

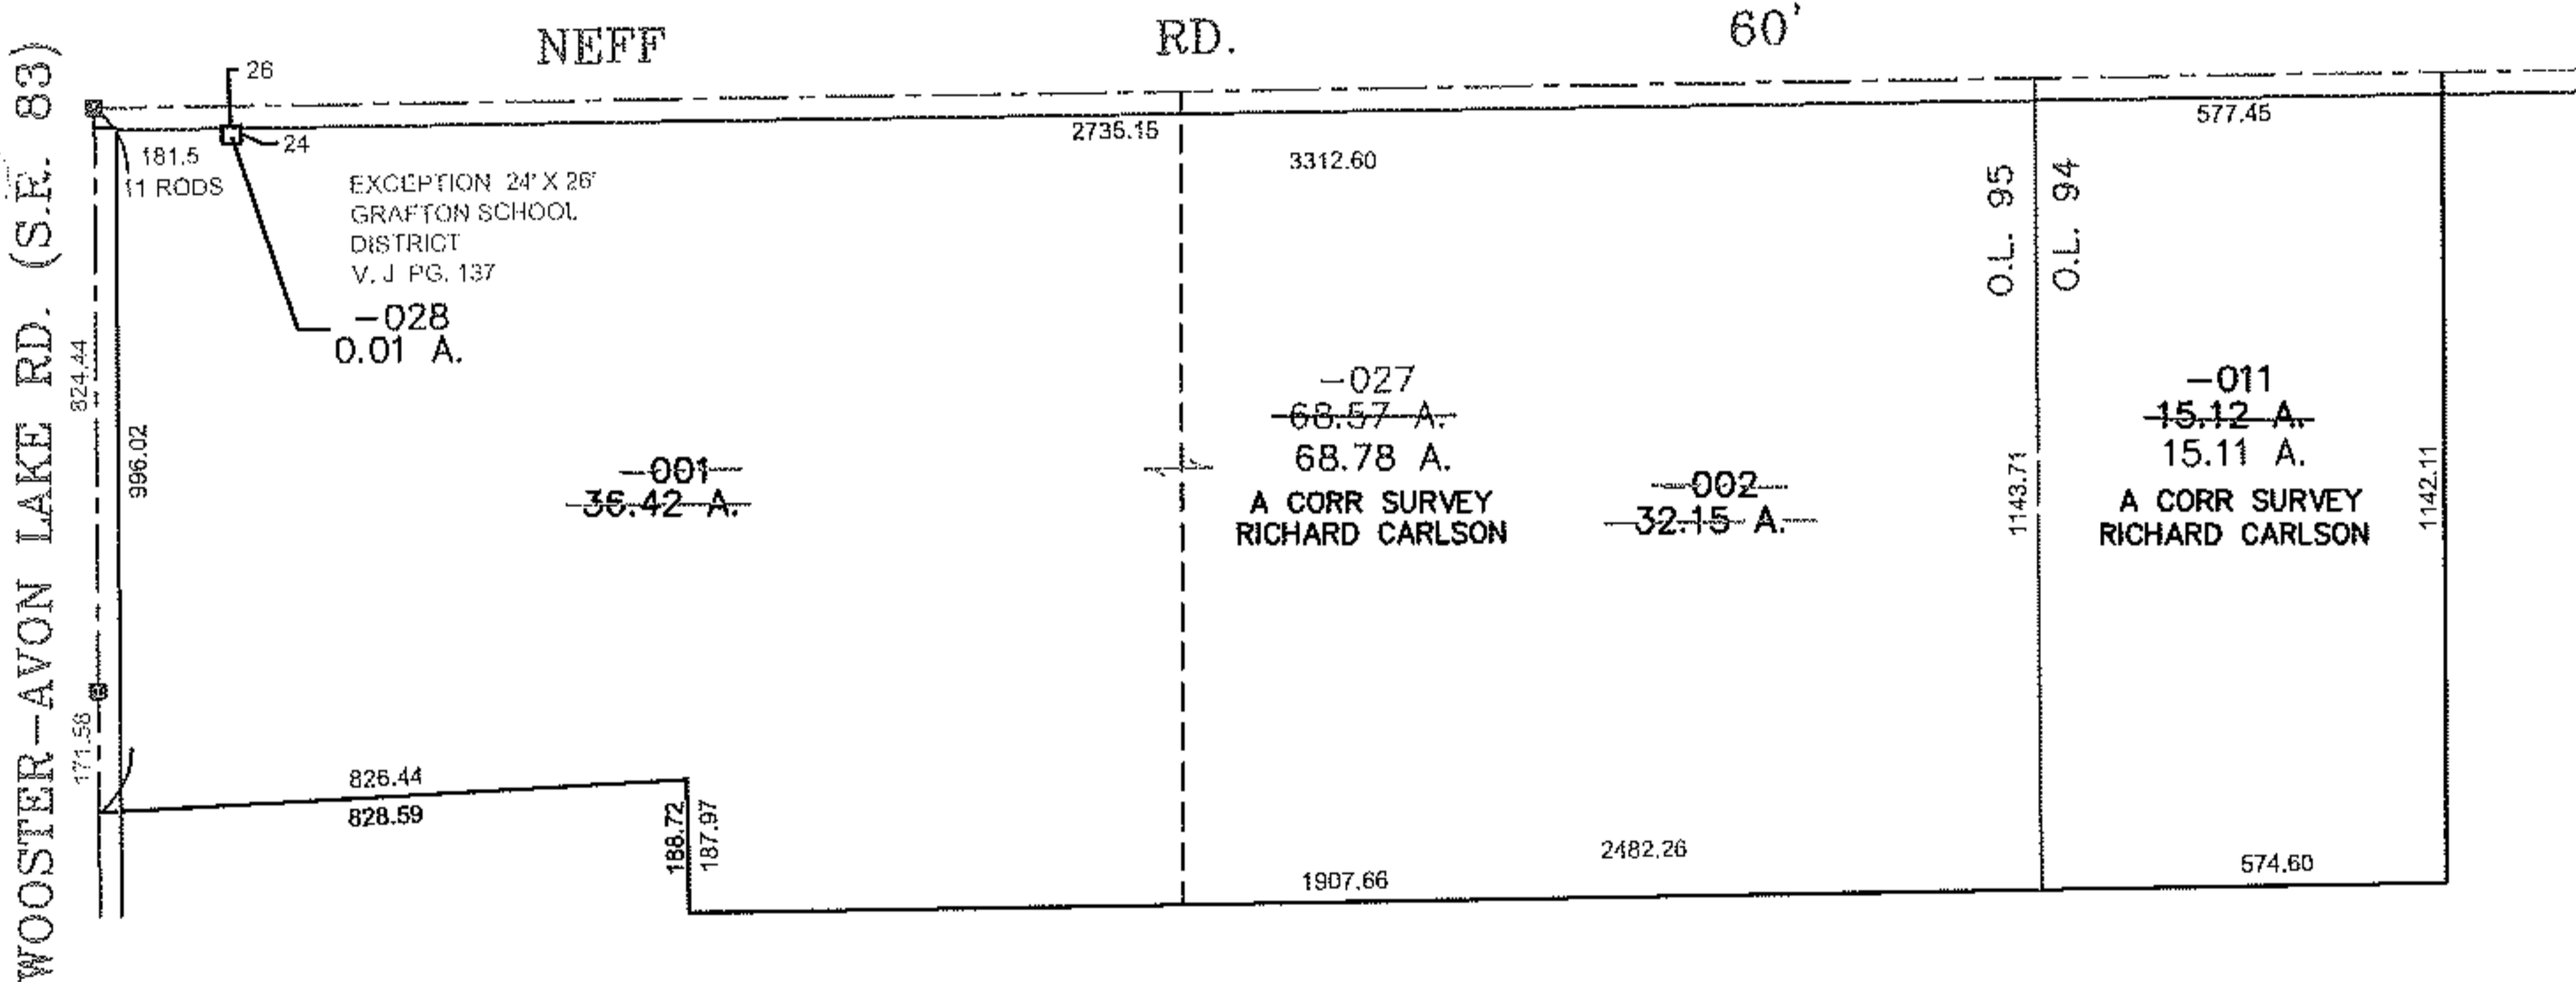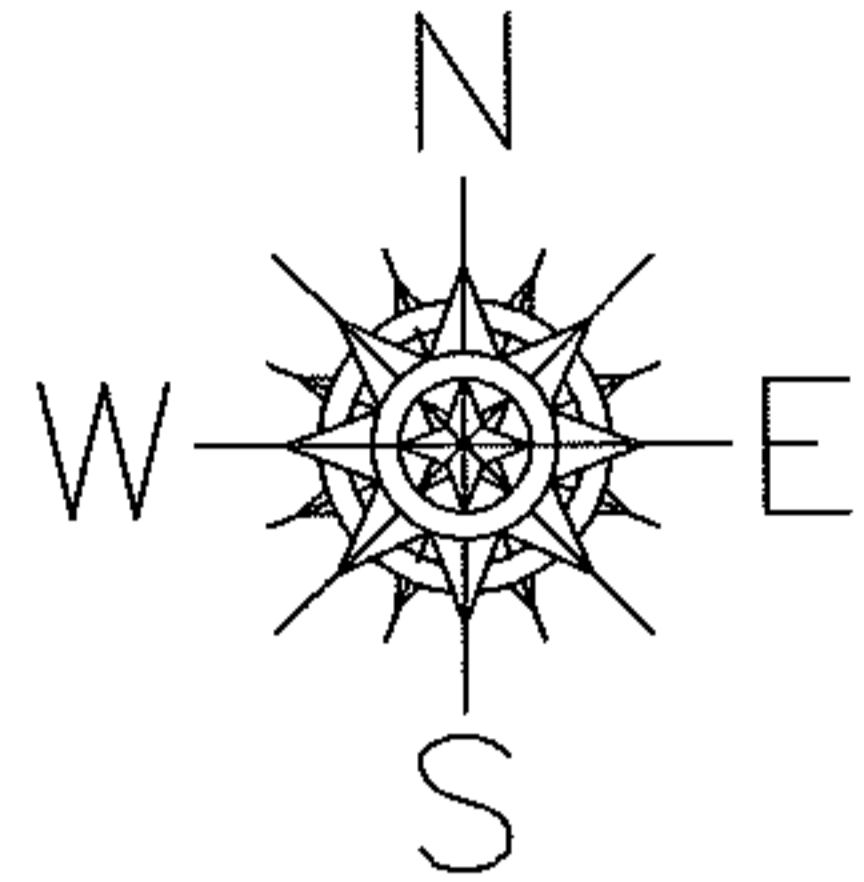

SPLITS/DEEDS PROCESSED

LORAIN COUNTY TAX MAP DEPARTMENT
226 MIDDLE AVE. ELYRIA, OHIO

SURVEYED BY: RICHARD CARLSON

CLOSURE: 0.00 : 10,000

MAP PAGE(S): 16-G

APPROVED BY: JAH DATE: 1-11-10

SCALE: 1" = 500 PRIOR INSTRUMENT: DV 1312/203