

PARENT PARCEL: 16-00-091-000-017

CHILD PARCEL: XX-XX-XXX-XXX-XXX

STARTING POINT: 5/8" REBAR FD., CL OF ERHART RD. AT THE S.E. CORNER OF O.L. 91

13-02796-C



ACREAGE CORRECTION

16-00-091-000-017

~~1.70~~ A.

1.74 A.

CORR. PER SURV.
WILFREDO BARBOSA

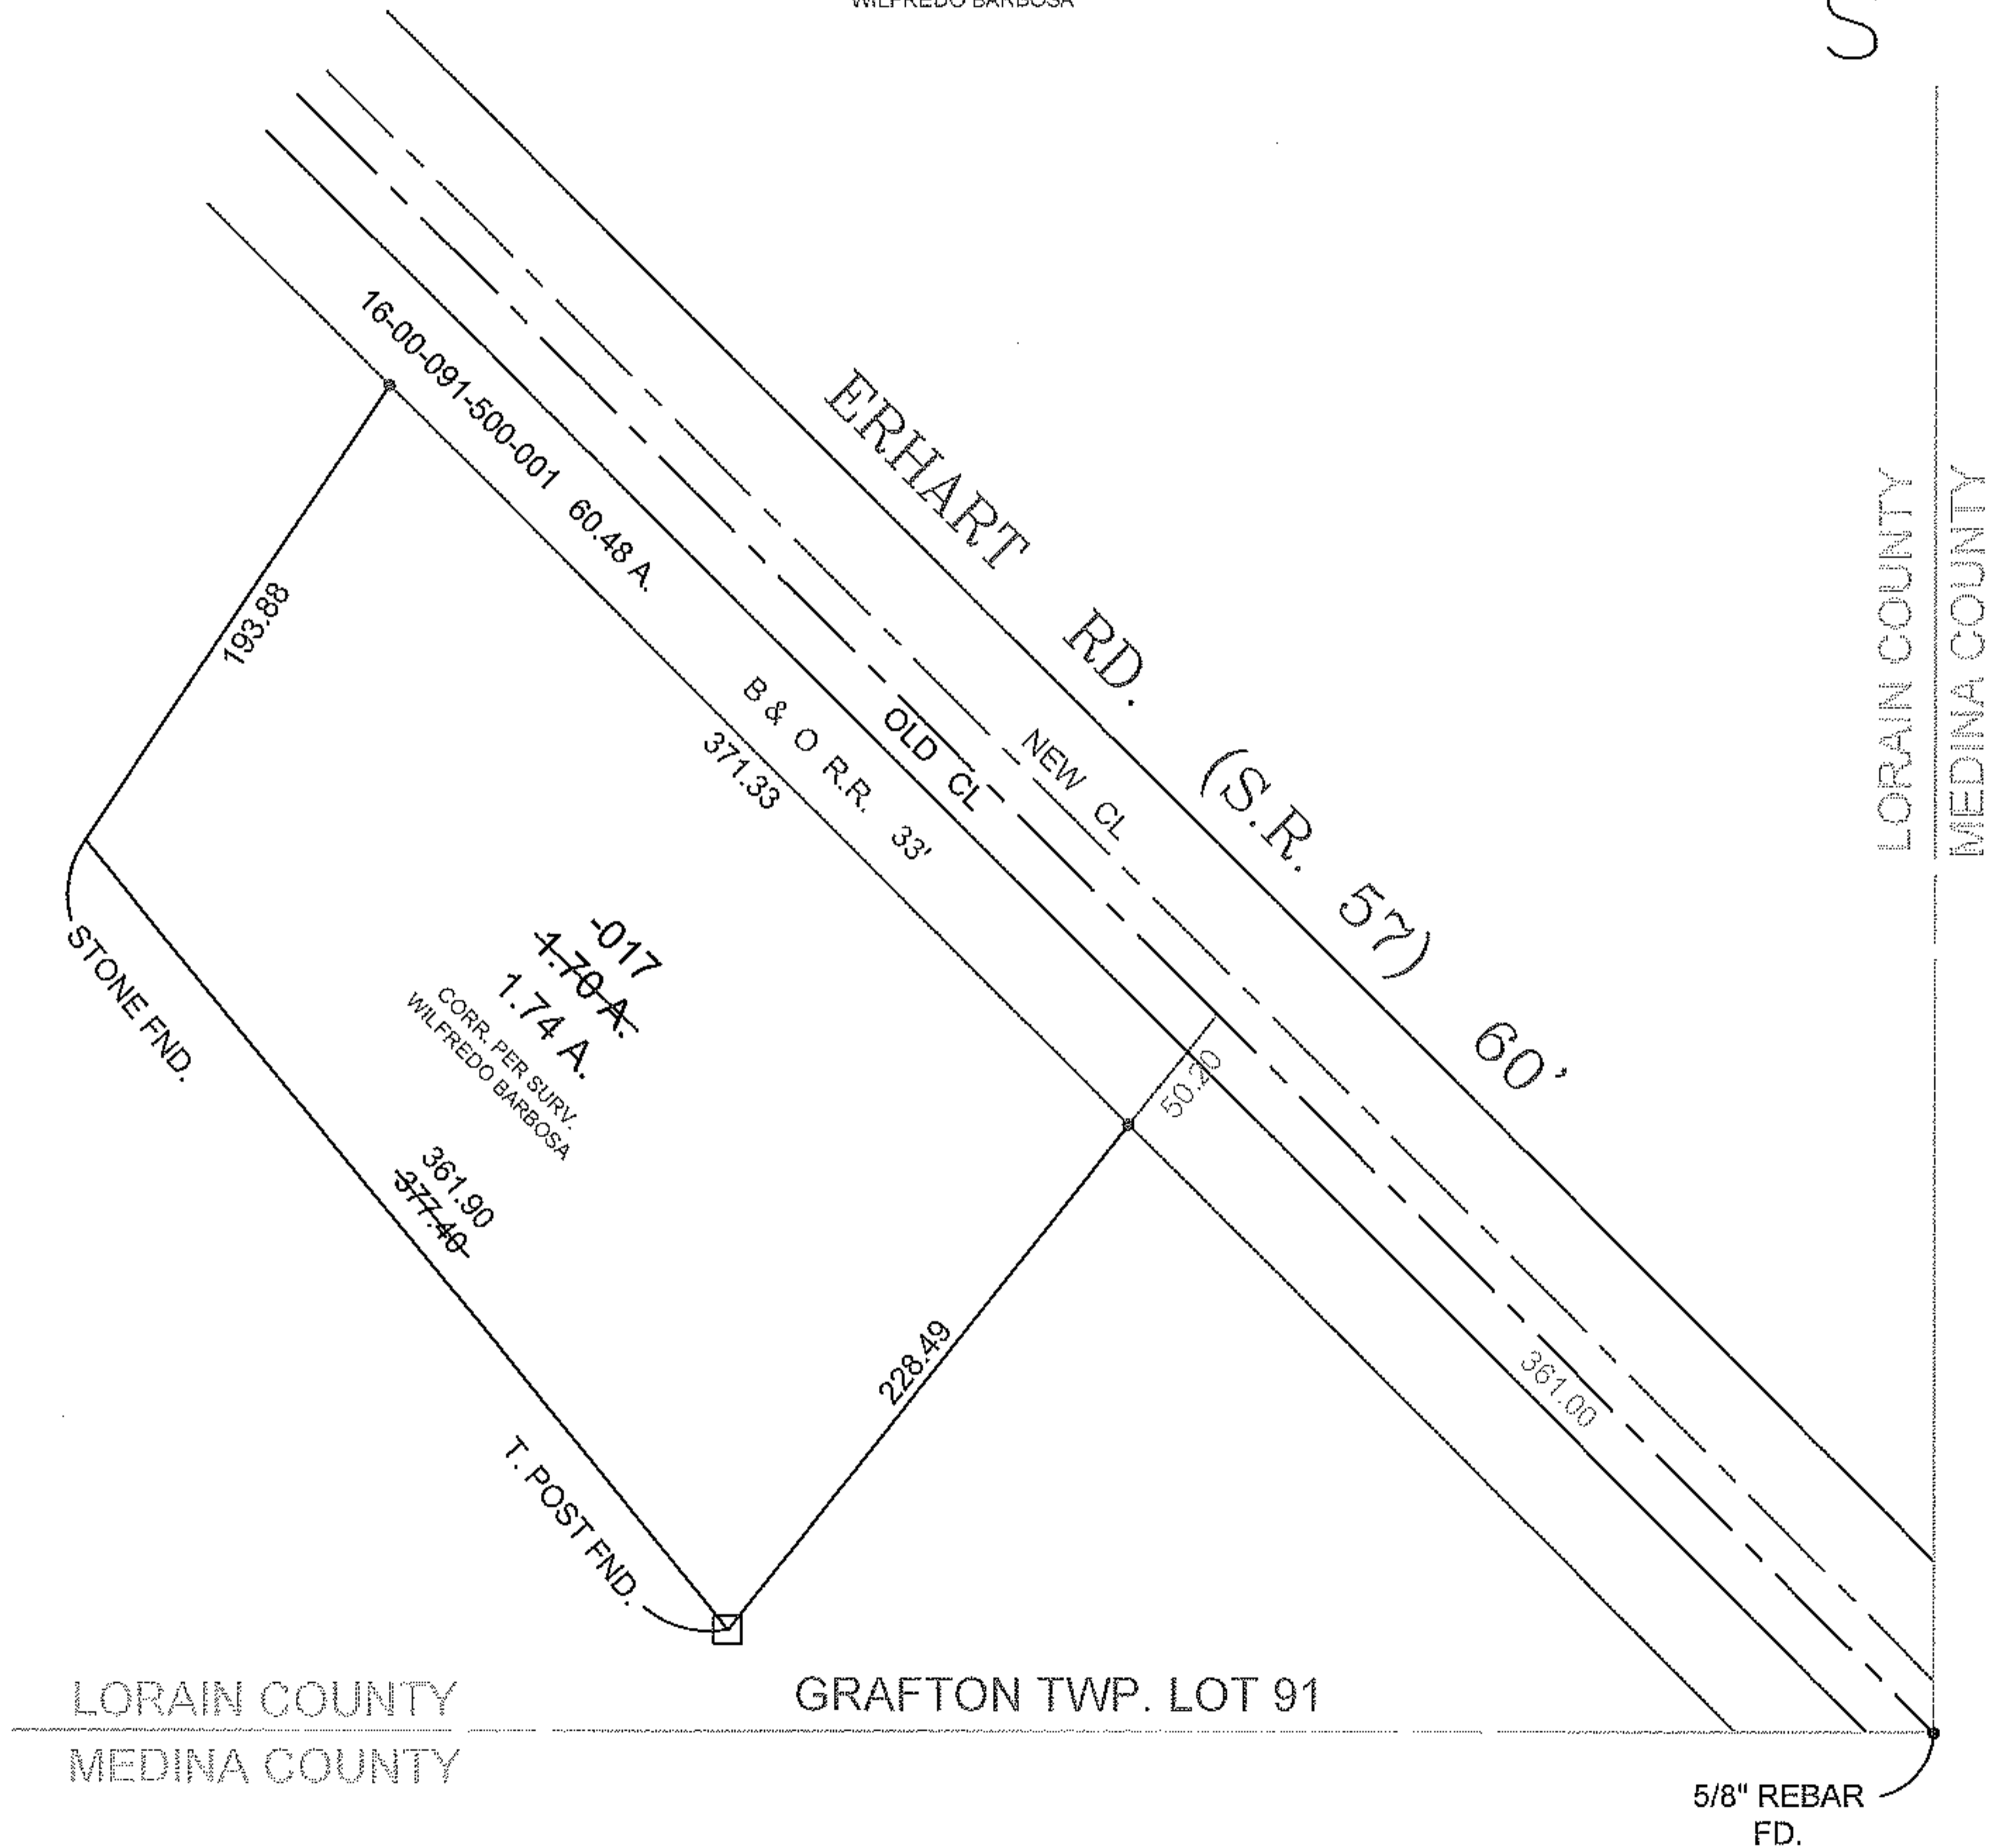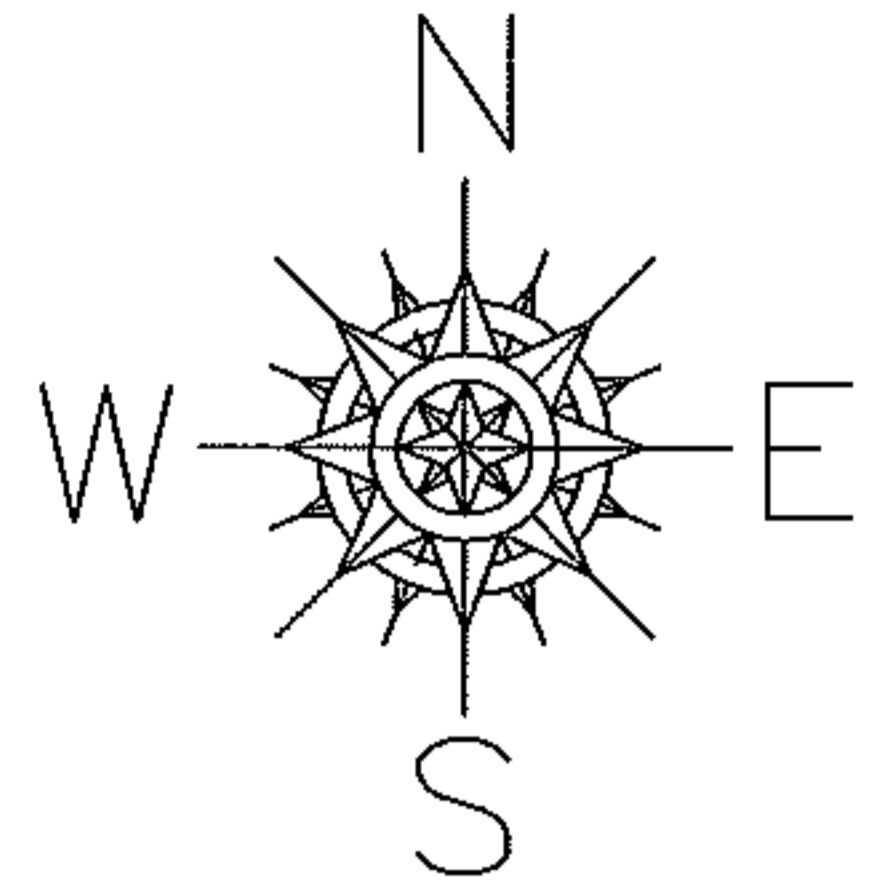


LORAIN COUNTY
MEDINA COUNTY

LORAIN COUNTY
MEDINA COUNTY

GRAFTON TWP. LOT 91

5/8" REBAR
FD.

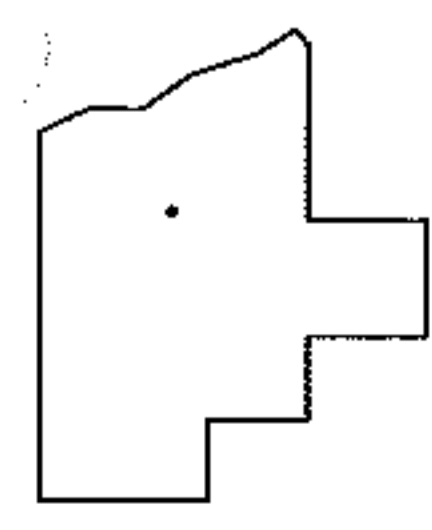

SPLITS/DEEDS PROCESSED

LORAIN COUNTY TAX MAP DEPARTMENT
226 MIDDLE AVE. ELYRIA, OHIO

SURVEYED BY: WILFREDO BARBOSA
 CLOSURE: 0.01 : 10,000
 MAP PAGE(S): 16-00-091-B
 APPROVED BY: TJS DATE: 9/12/13
 SCALE: 1" = 100' PRIOR INSTRUMENT: 20120423657