
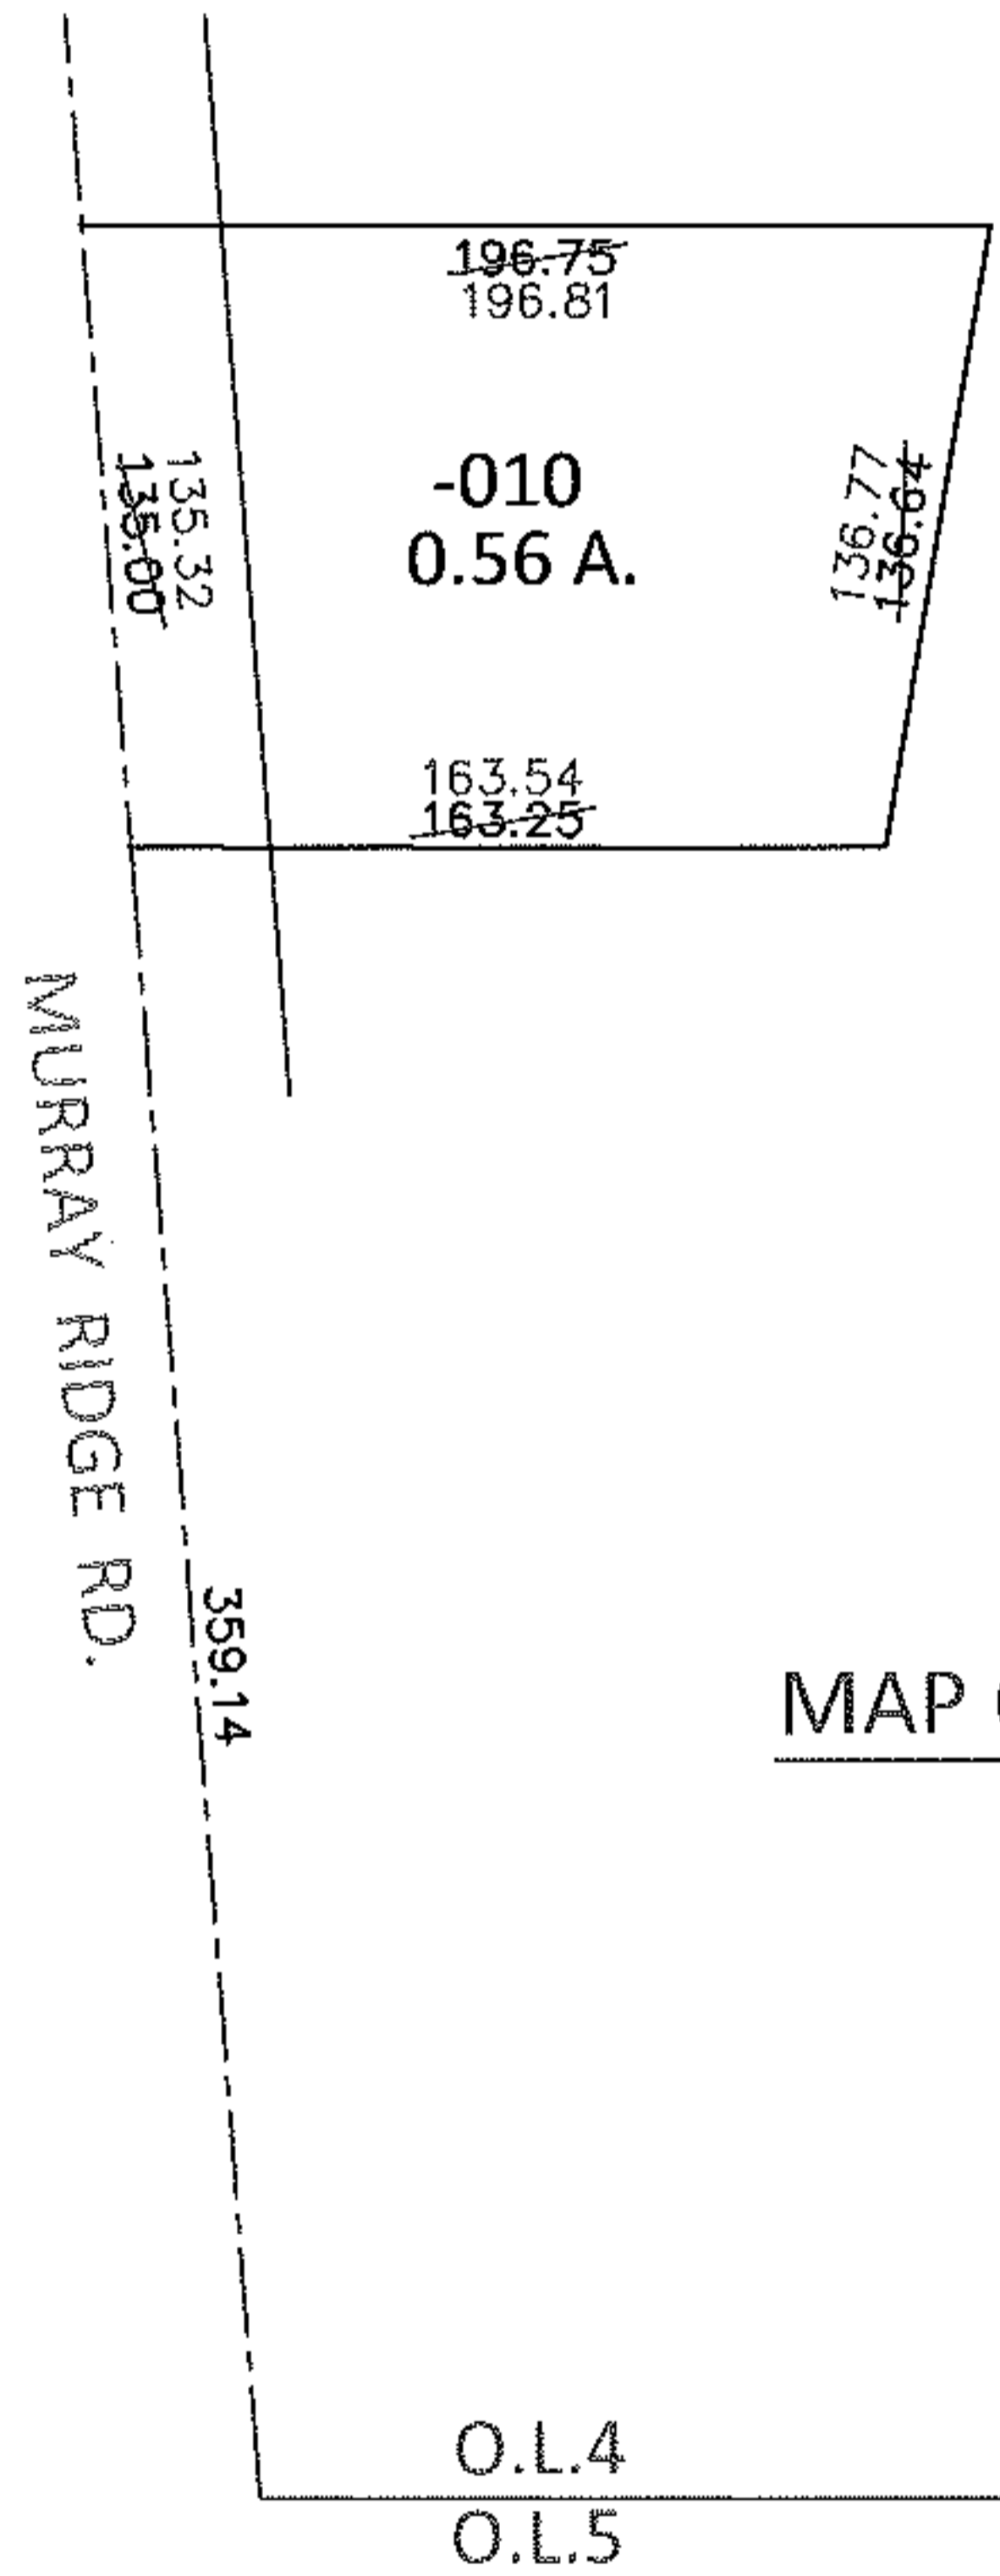


PARENT PARCEL: 06-24-004-000-010


CHILD PARCEL: _____

13-02799-D

STARTING POINT: INTERSECTION OF C/L OF MURRAY RIDGE RD. AND SOUTH LINE OF O.L.4

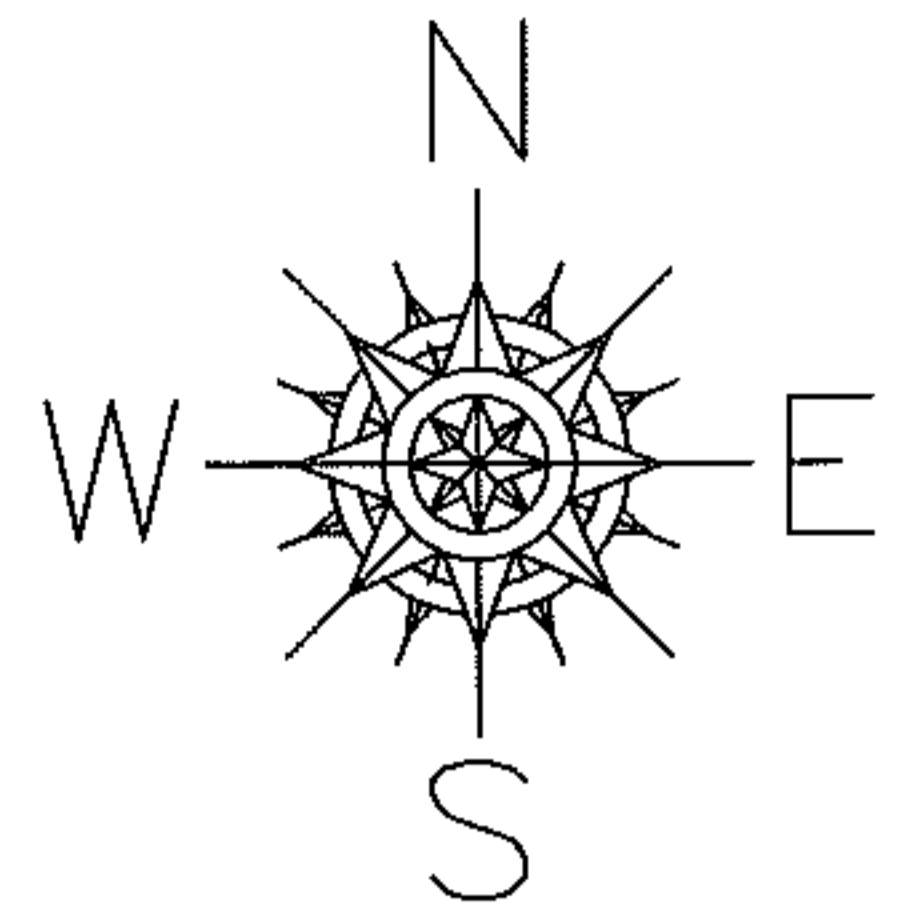

MAP CORRECTION ONLY

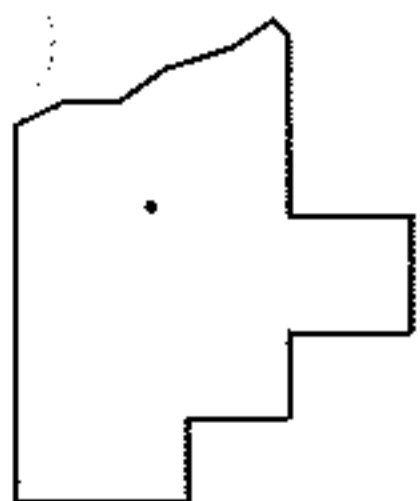

SPLITS/DEEDS PROCESSED

LORAIN COUNTY TAX MAP DEPARTMENT
226 MIDDLE AVE. ELYRIA, OHIO

SURVEYED BY: DALE R. HAYWOOD

CLOSURE: .01:10,000

MAP PAGE(S): 6-112

APPROVED BY: RRM DATE: 9-16-13

SCALE: 1" = 100 PRIOR INST.: 20070210267