
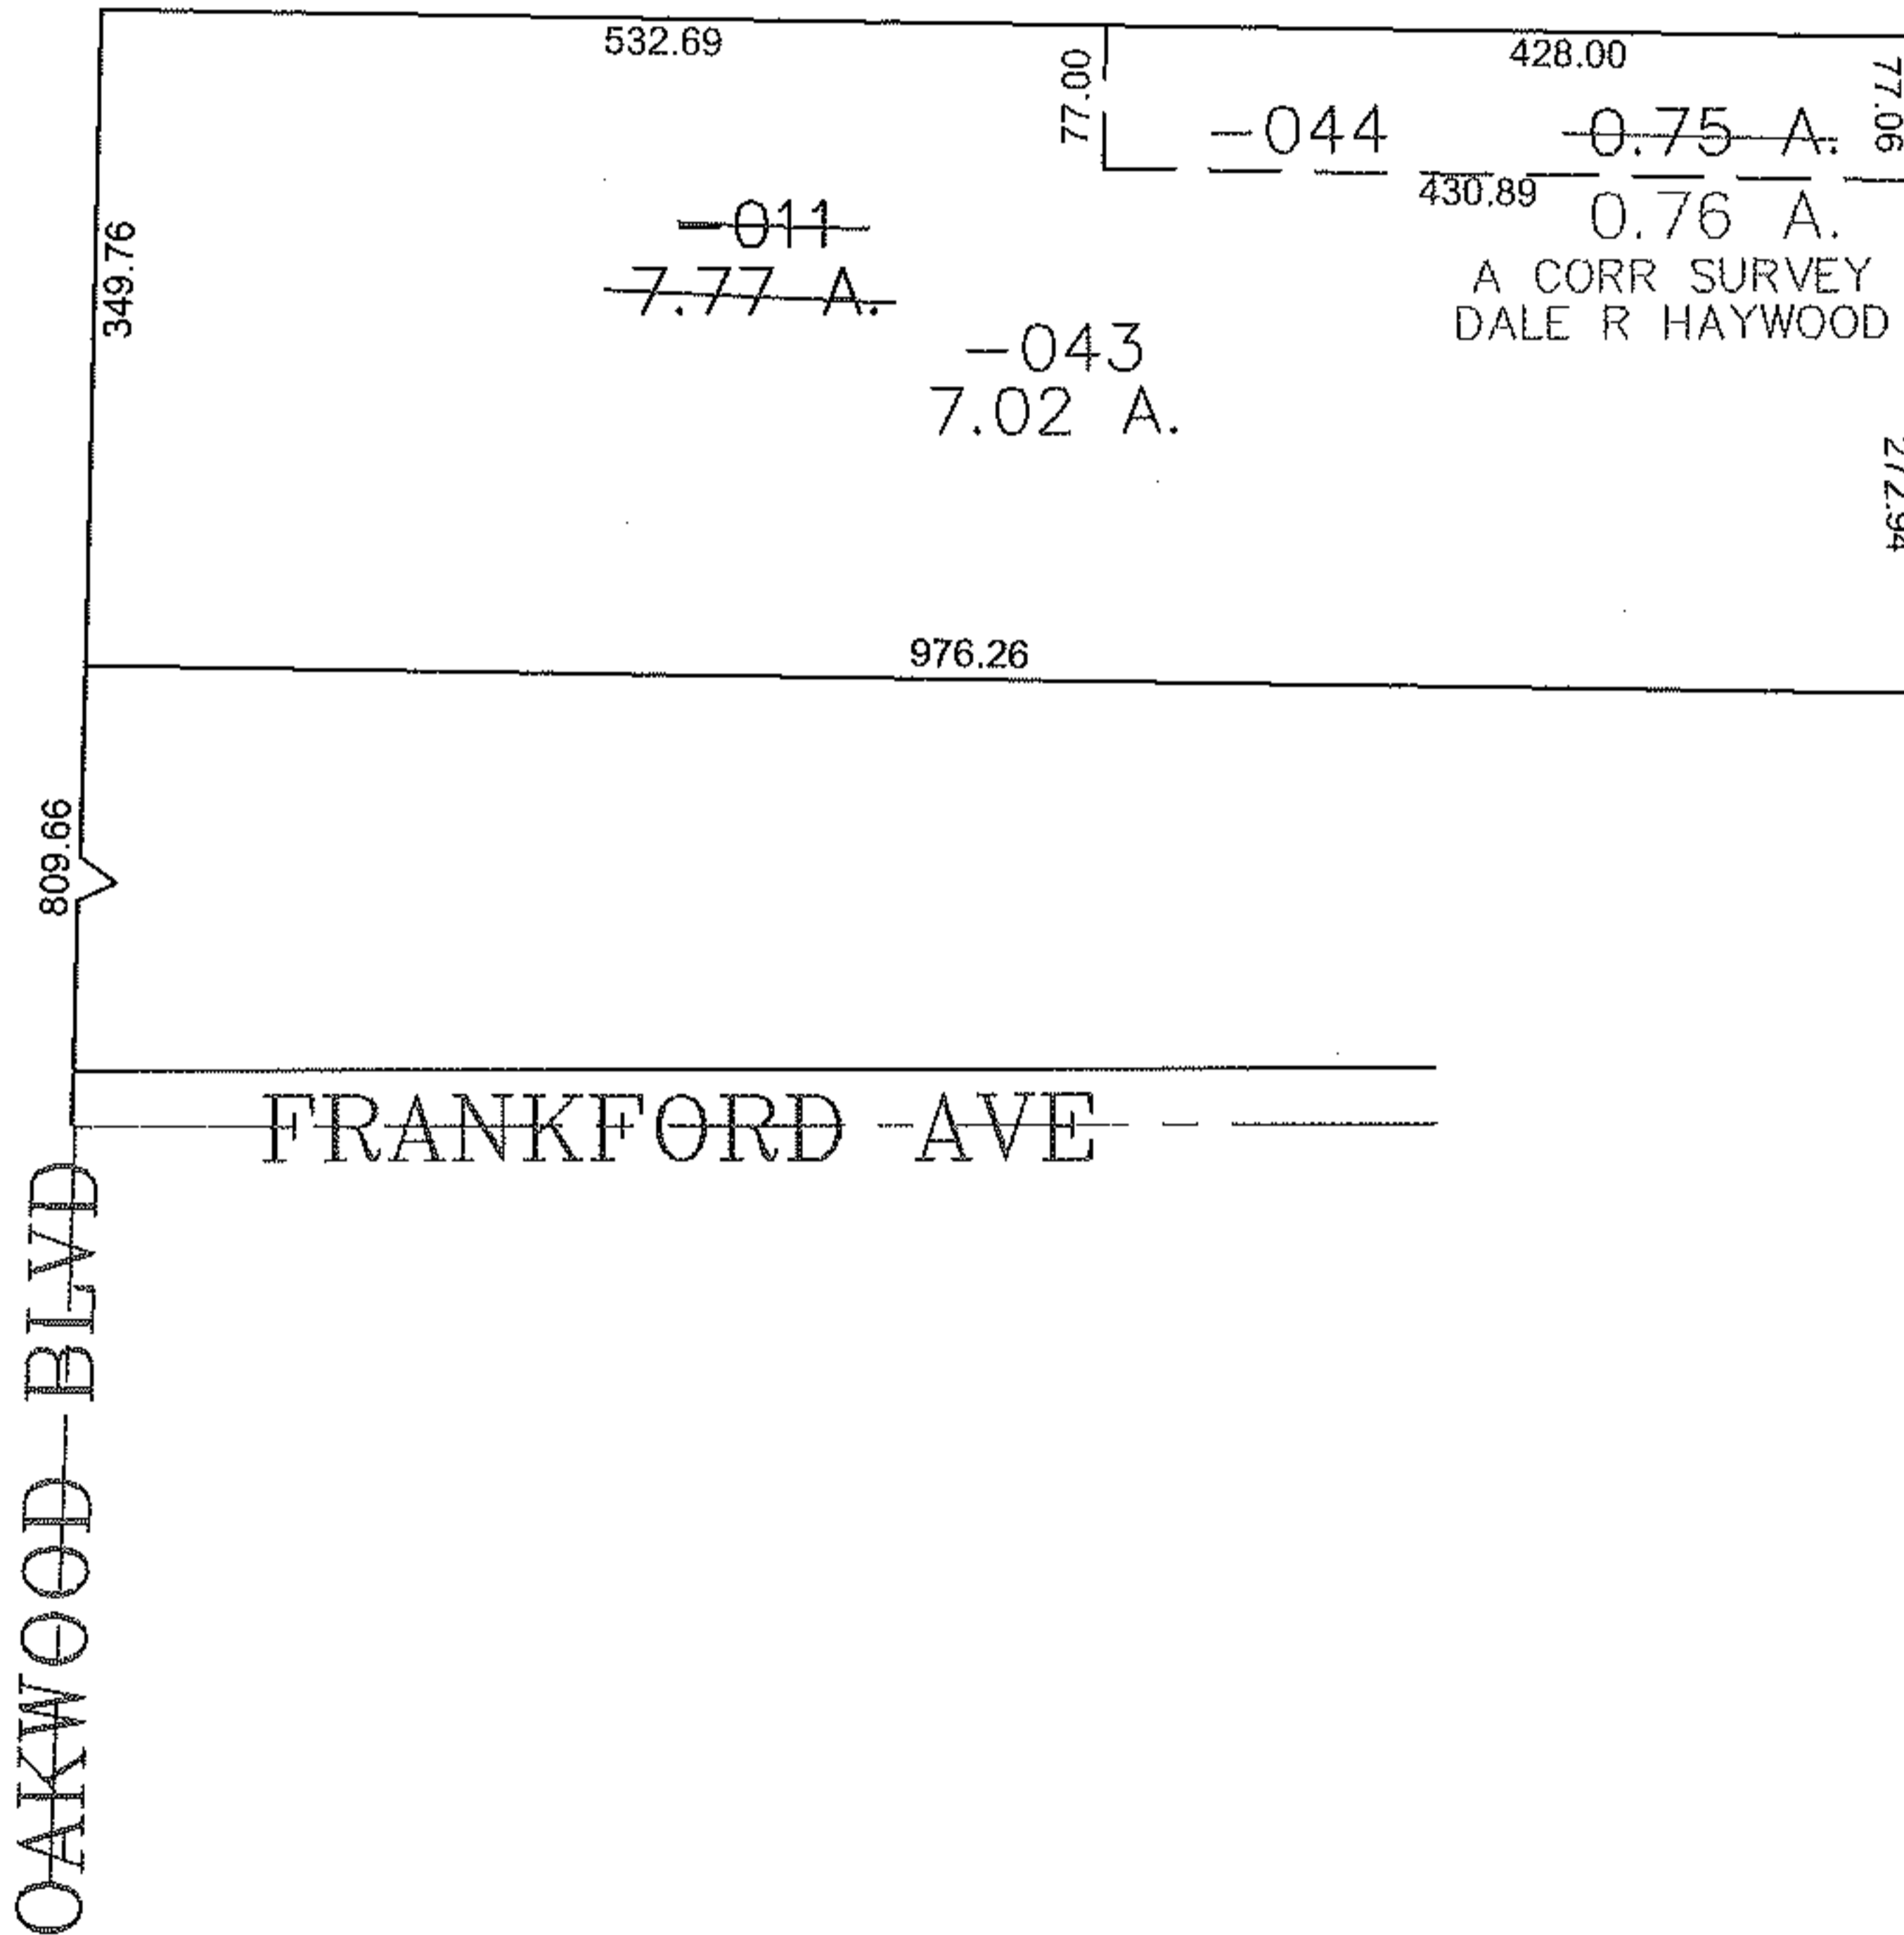


PARENT PARCEL: 03-00-104-101-011

CHILD PARCEL: 03-00-104-101-043, -044

STARTING POINT: CENTERLINE OF FRANKFORD AVE & NW CORNER OF RIDGE-VUE HEIGHTS

10-02801

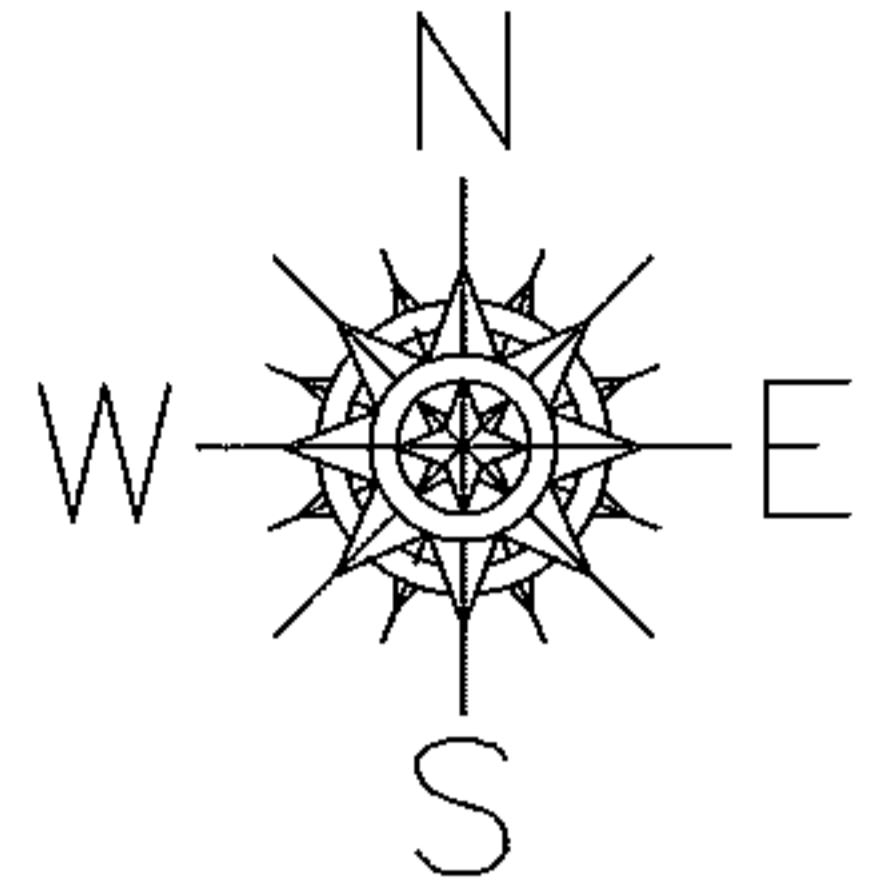

SPLITS/DEEDS PROCESSED

LORAIN COUNTY TAX MAP DEPARTMENT
226 MIDDLE AVE. ELYRIA, OHIO

SURVEYED BY:	DALE HAYWOOD
CLOSURE:	0.00 : 10,000
MAP PAGE(S):	03-00-104-B
APPROVED BY:	JAH DATE: 2-15-10
SCALE:	1" = 200 PRIOR INSTRUMENT: DV 756/419