

PARENT PARCEL: 02-01-003-125-012

CHILD PARCEL: DROP FROM REGISTER

STARTING POINT: XXXXXX



13-02804-C

DROP FROM REGISTER

~~02-01-003-125-012~~


~~BUILDING ON LEASED LAND~~

NOT ON THE AUDITOR'S DUPLICATE

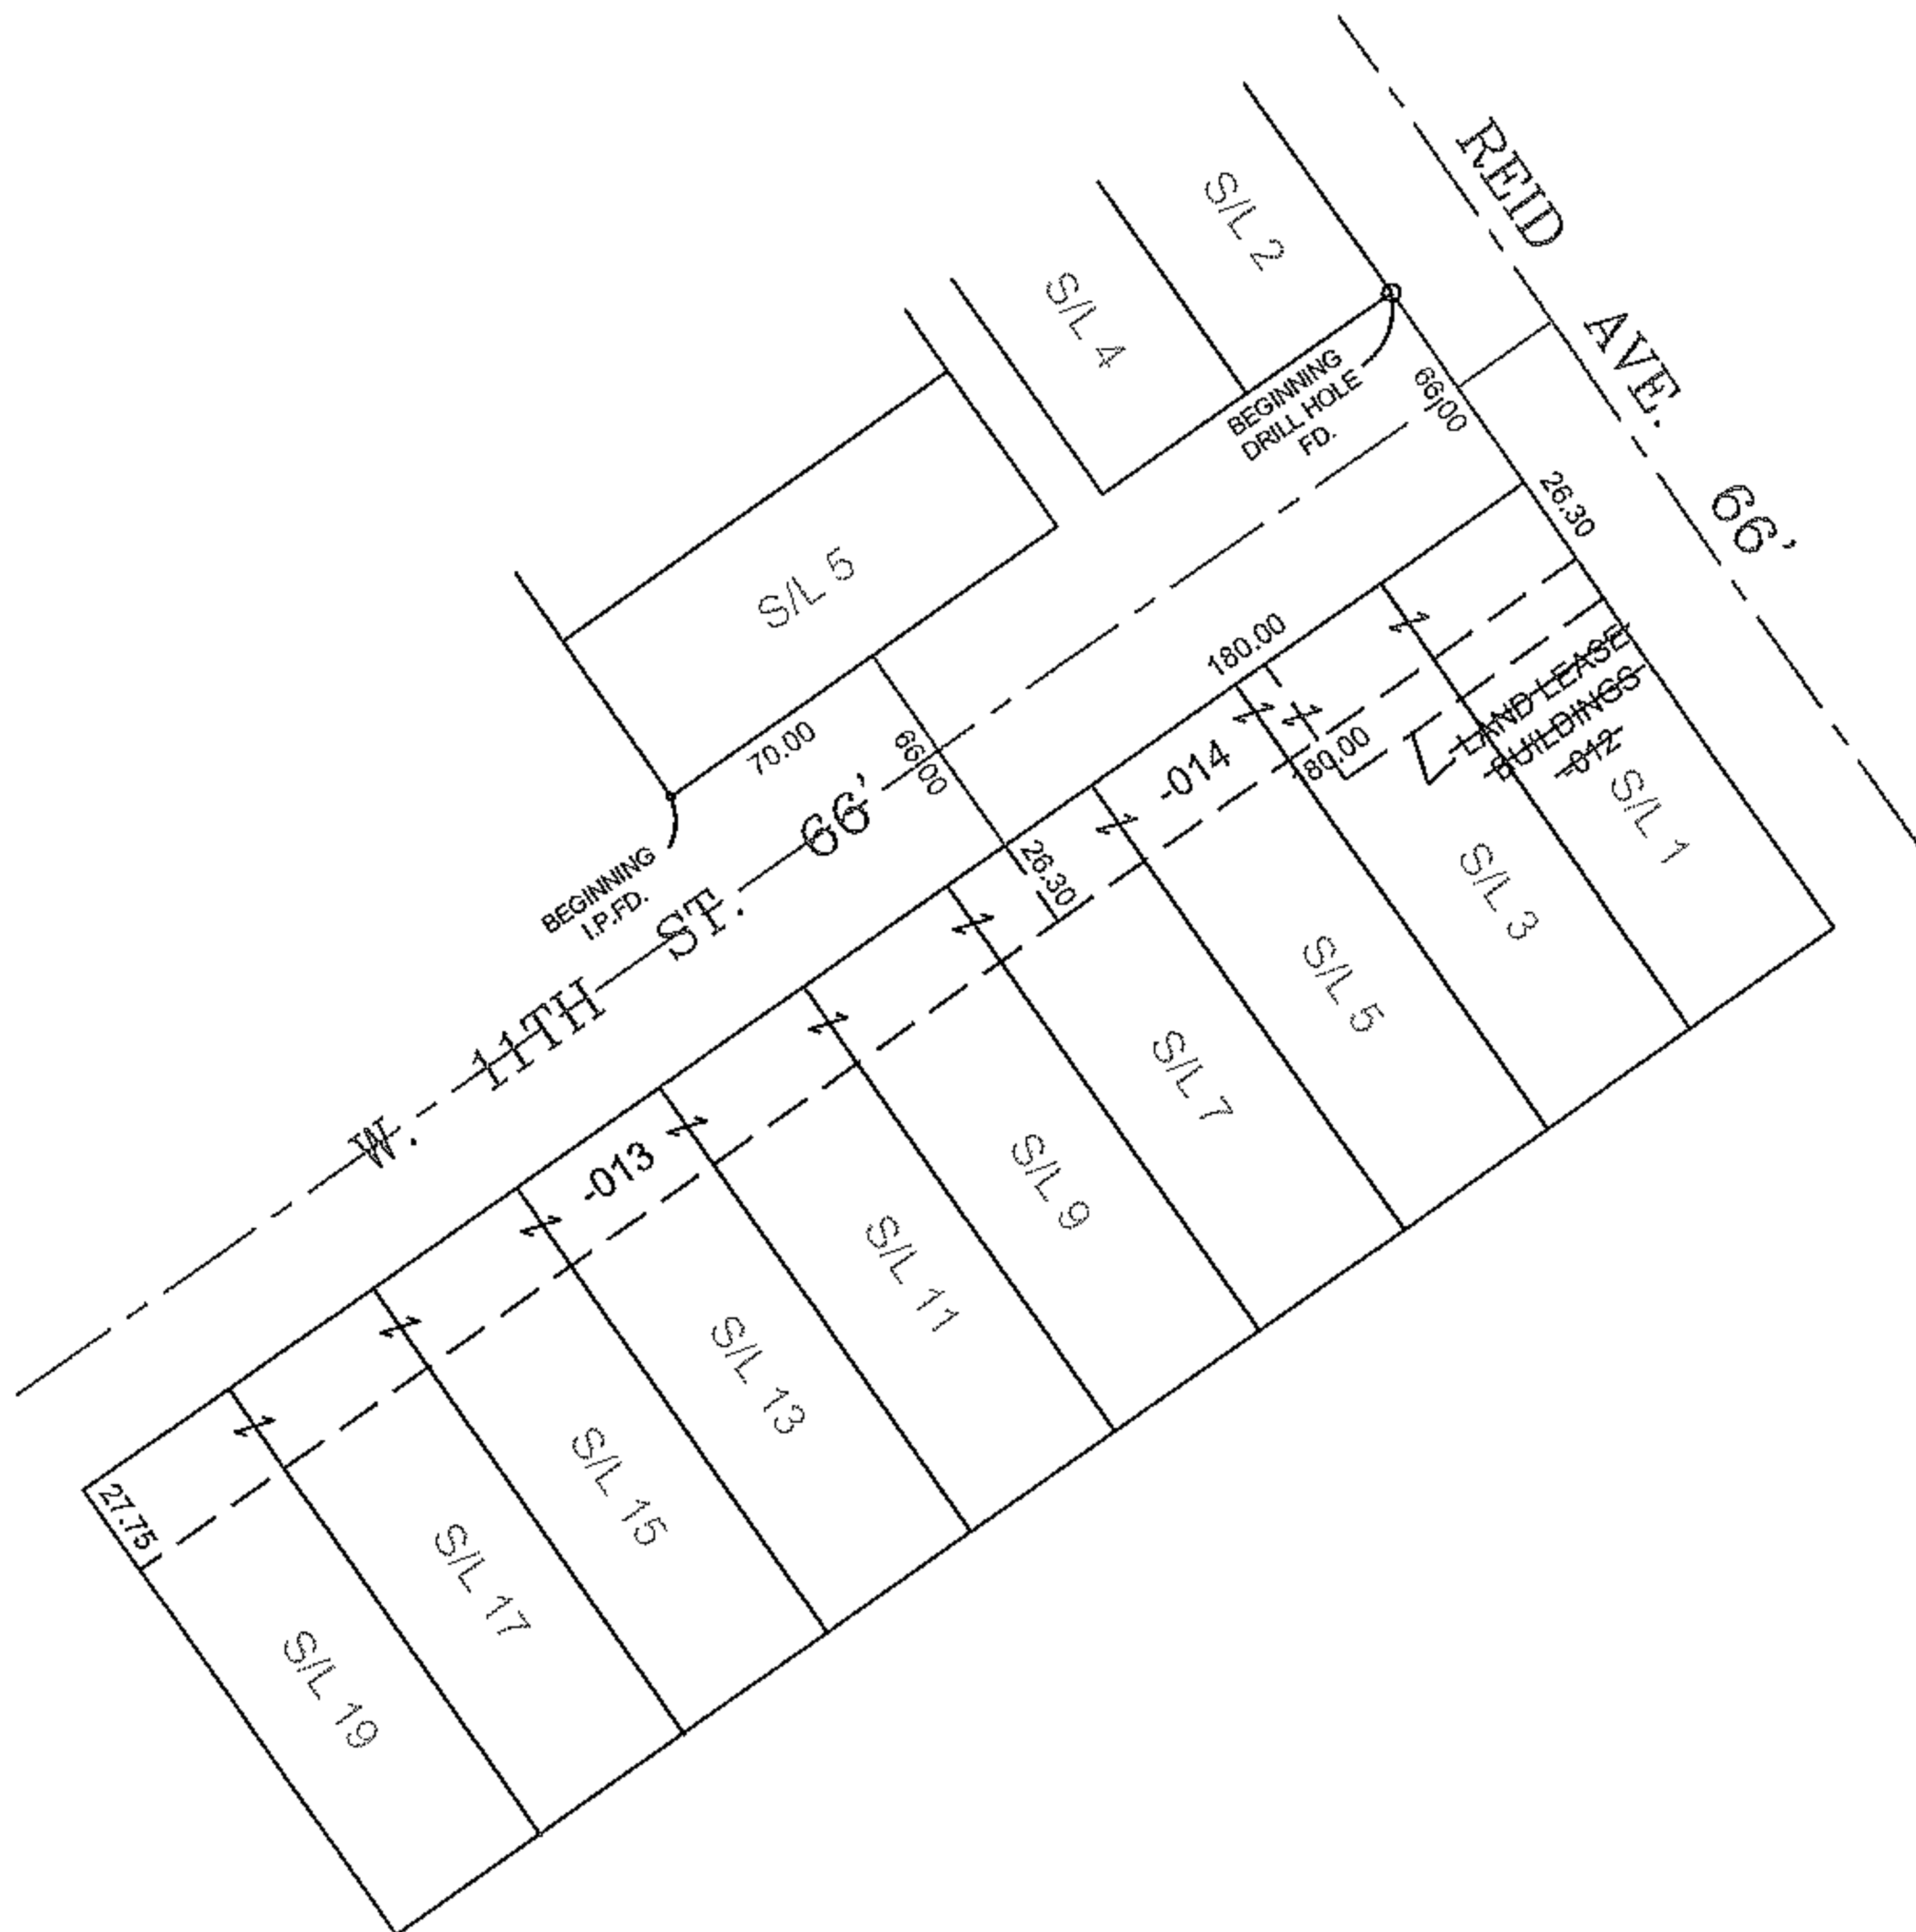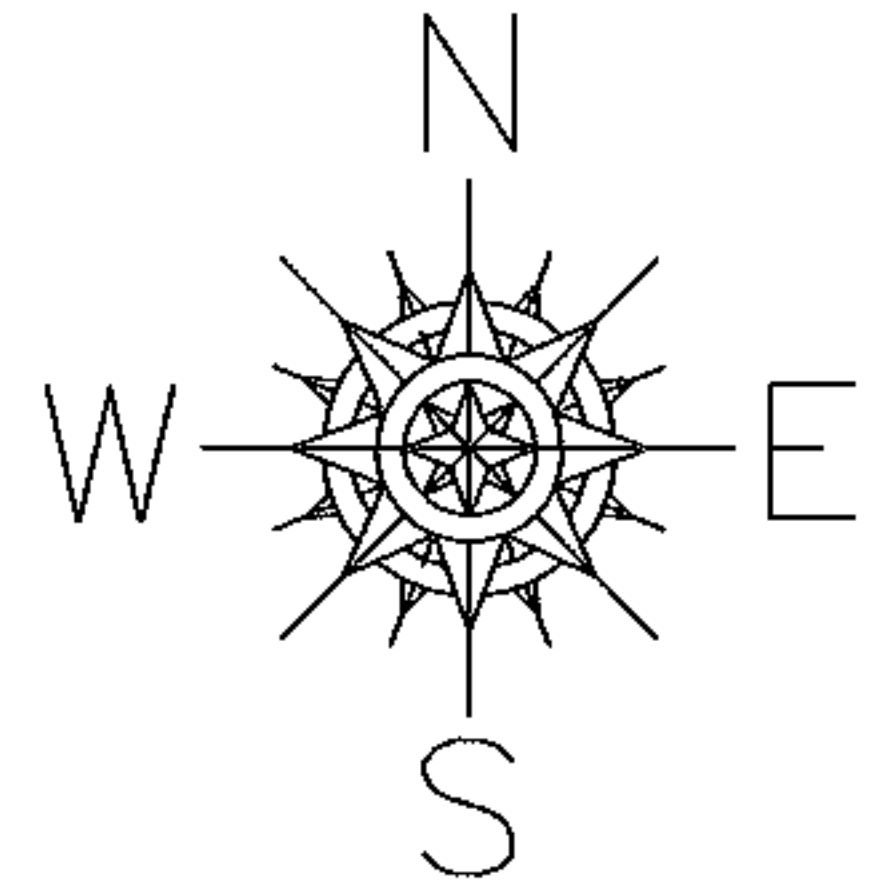

PRIOR INSTRUMENT: OR 1307/949

PRIOR INSTRUMENT: 19960412695

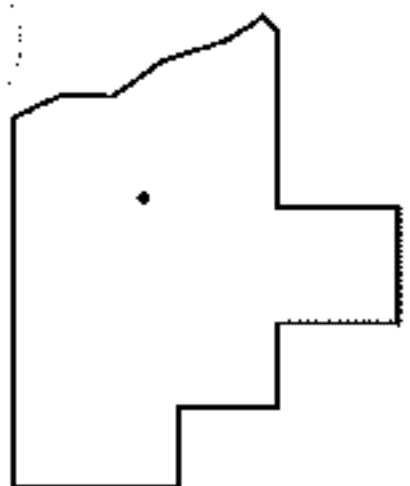

SPLITS/DEEDS PROCESSED

LORAIN COUNTY TAX MAP DEPARTMENT
226 MIDDLE AVE. ELYRIA, OHIO

SURVEYED BY: PAT MCGANNON

CLOSURE: 0.01 : 10,000

MAP PAGE(S): 02-01-003-C

APPROVED BY: TJS DATE: 9/17/13

SCALE: 1" = 100