


PARENT PARCEL: 05-00-001-000-206, 202

CHILD PARCEL: 05-00-001-000-259 THRU -263

STARTING POINT: CENTERLINE OF COOPER FOSTER PARK RD & OAK POINT RD

10-02804

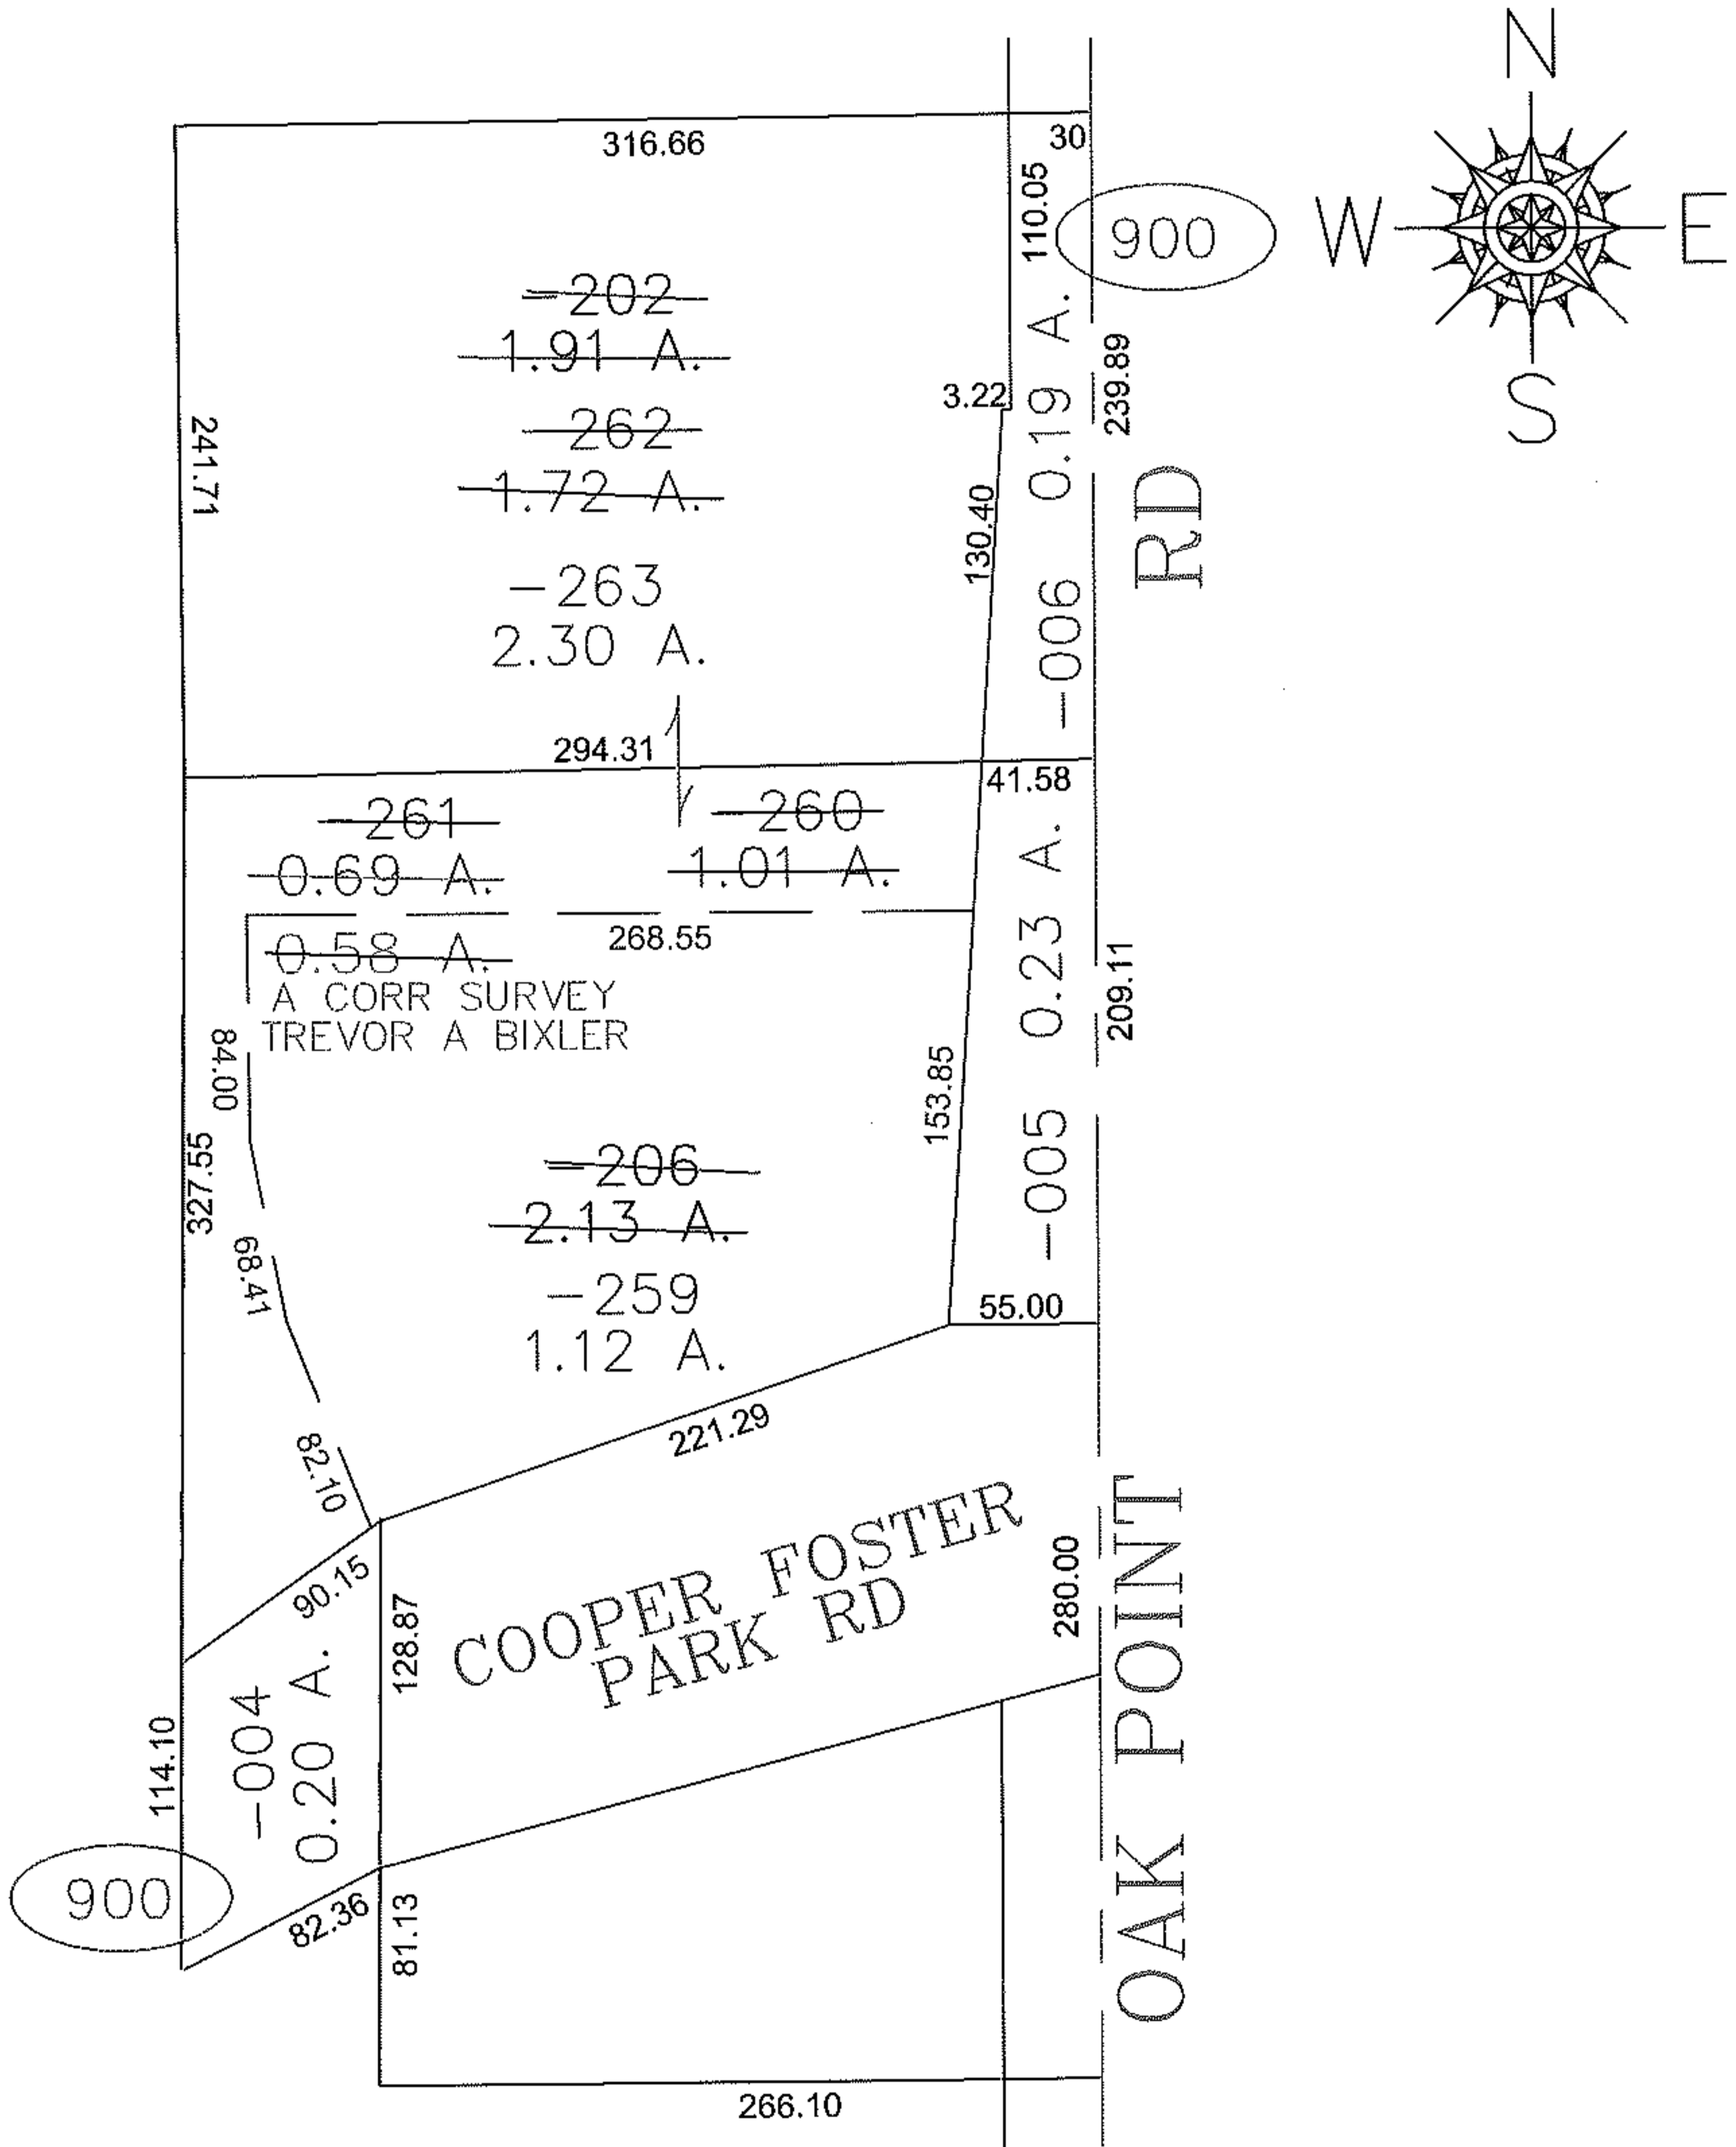

SPLITS/DEEDS PROCESSED

LORAIN COUNTY TAX MAP DEPARTMENT  
226 MIDDLE AVE. ELYRIA, OHIO

SURVEYED BY: TREVOR A BIXLER

CLOSURE: 0.00 : 10.000

MAP PAGE(S): 05-00-001-B

APPROVED BY: JAH DATE: 2-24-10

SCALE: 1" = 100 PRIOR INSTRUMENT: 20060178812