
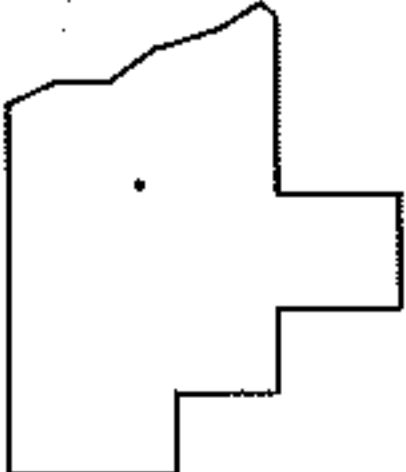
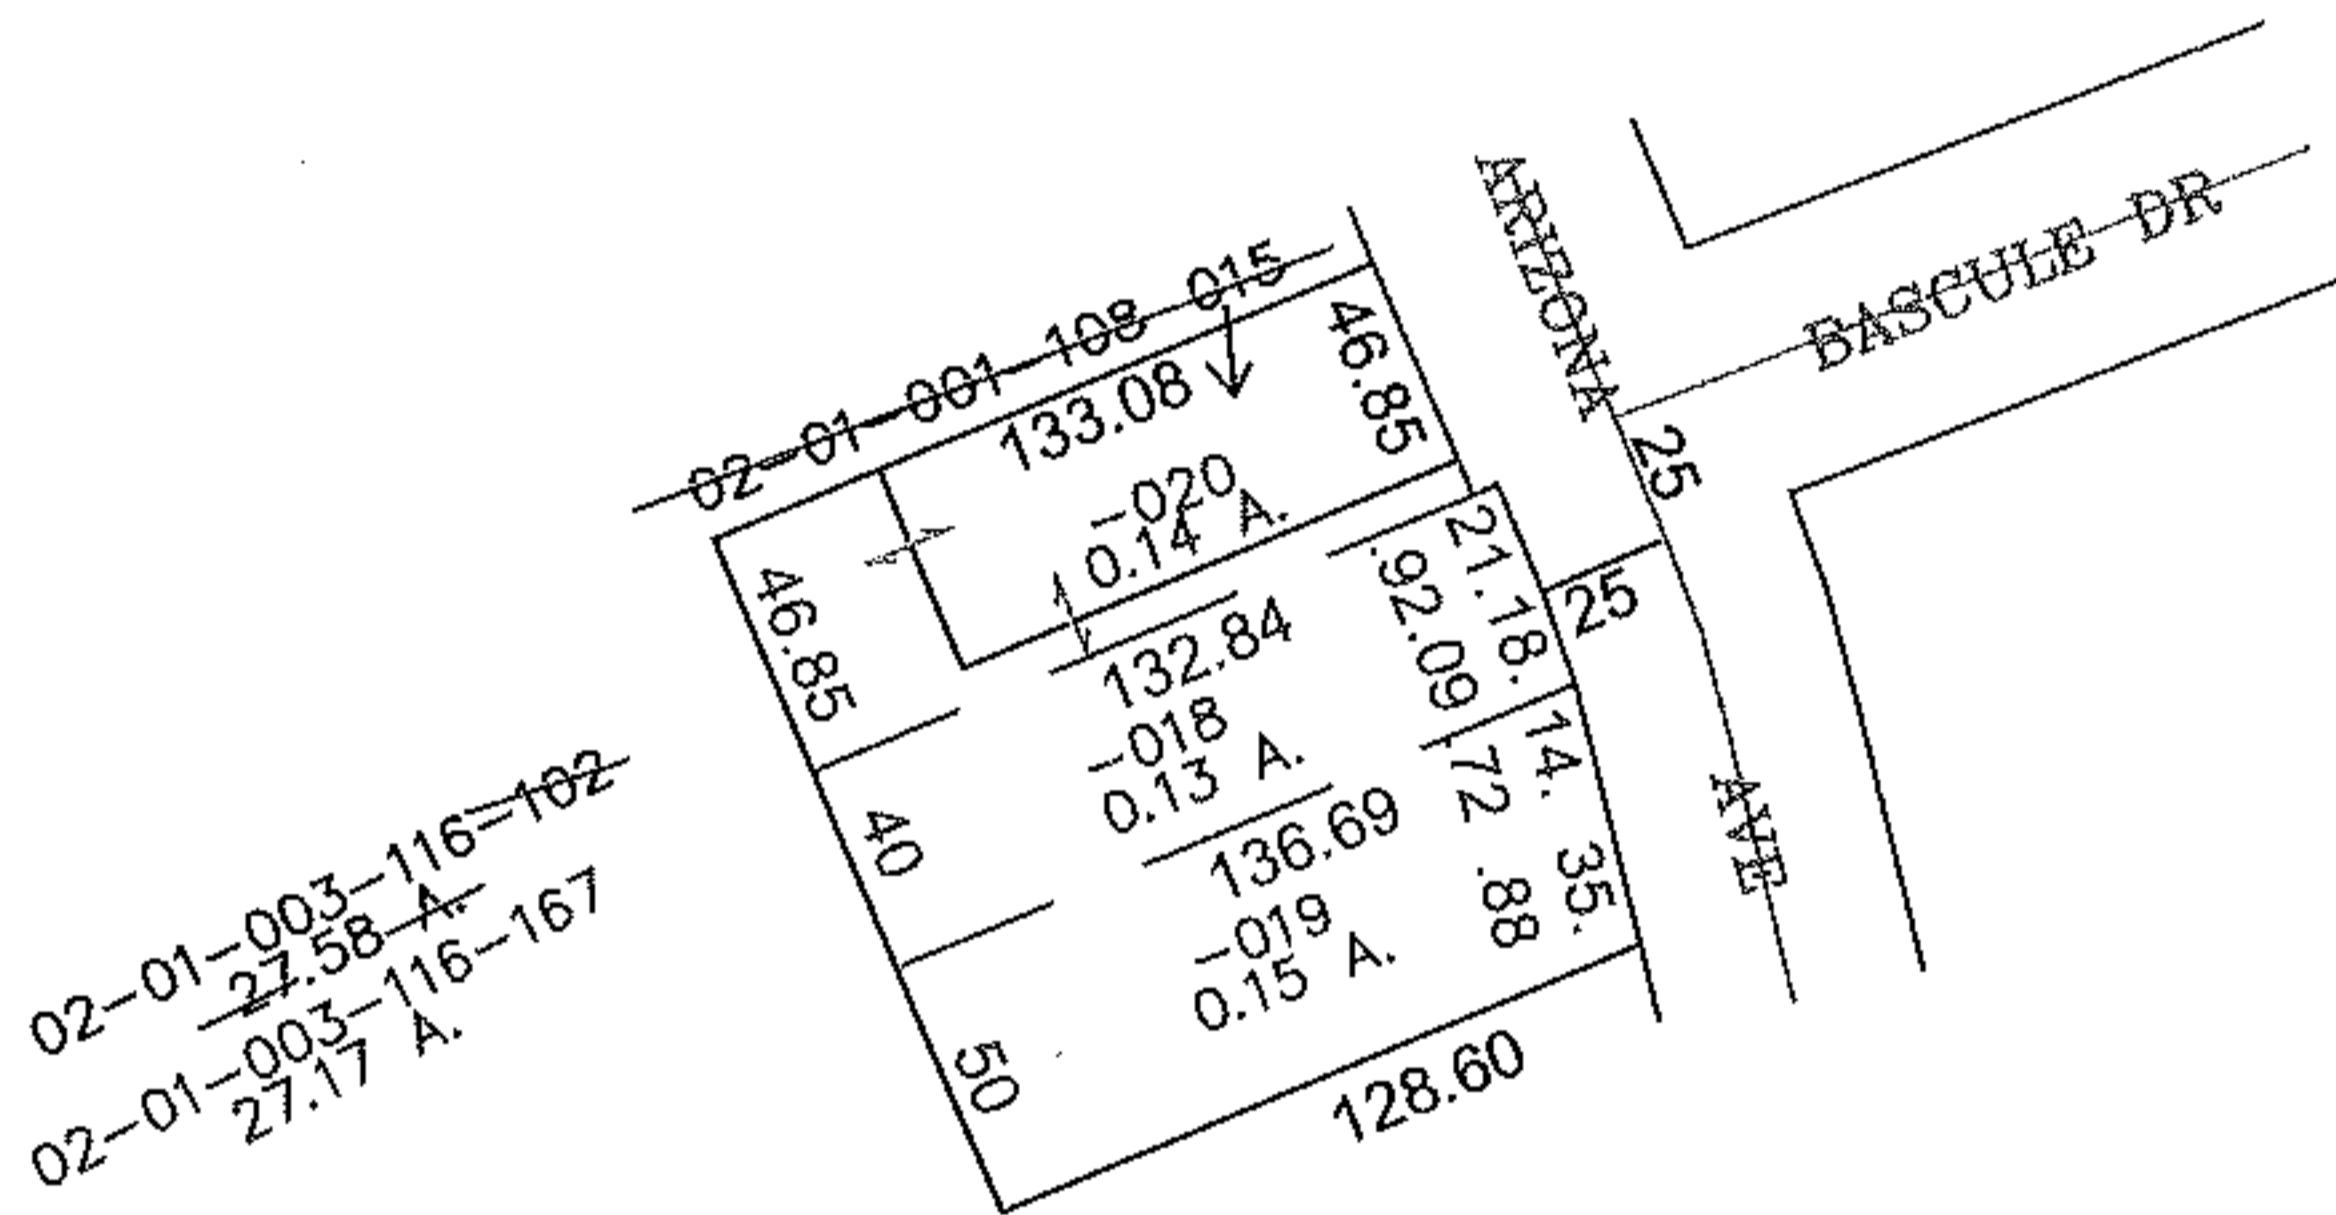


PARENT PARCEL: 02-01-003-116-102, 02-01-001-108-015

CHILD PARCEL: 02-01-001-108-018 THRU -020 02-01-003-116-167

STARTING POINT: CENTERLINE OF ARIZONA AVE & BASCULE DR

10-02805

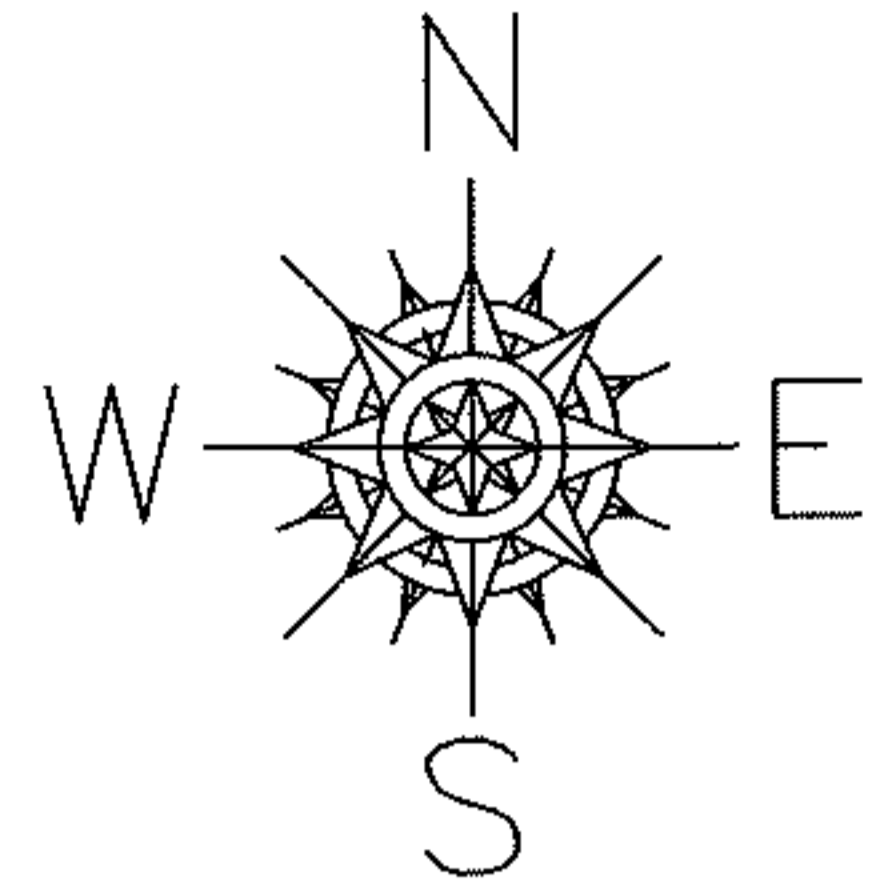

SPLITS/DEEDS PROCESSED

LORAIN COUNTY TAX MAP DEPARTMENT  
226 MIDDLE AVE. ELYRIA, OHIO

SURVEYED BY: MICHAEL BRAMHALL

CLOSURE: 0.00 : 10,000

MAP PAGE(S): 02-01-003-A

APPROVED BY: JAH DATE: 2-25-10

SCALE: 1" = 100 PRIOR INSTRUMENT: DV 1389/99