
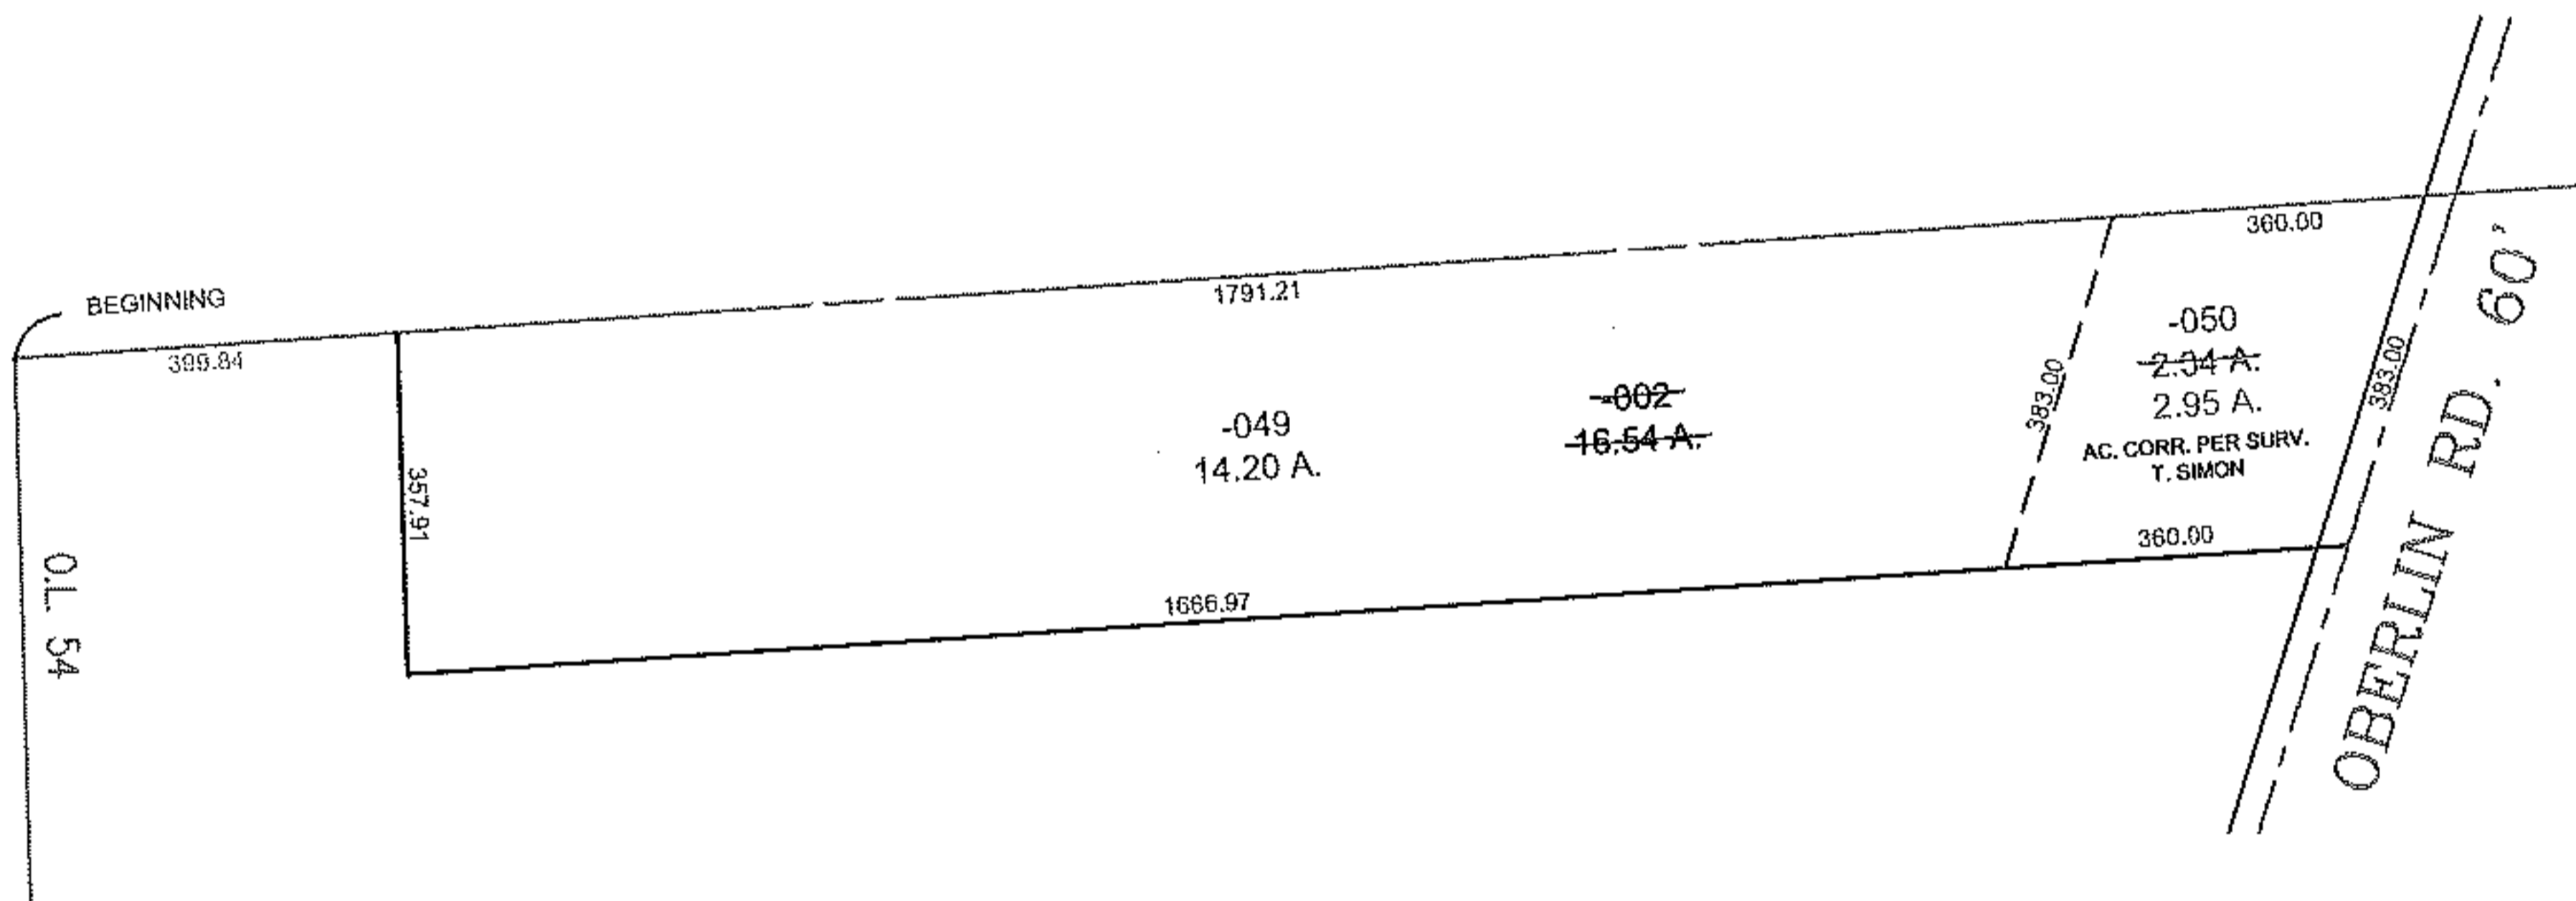


PARENT PARCEL: 05-00-054-000-002

CHILD PARCEL: 05-00-054-000-049 & -050

STARTING POINT: I.P. FOUND, N.W. CORNER OF O.L. 54, AMHERST TWP.

10-02808

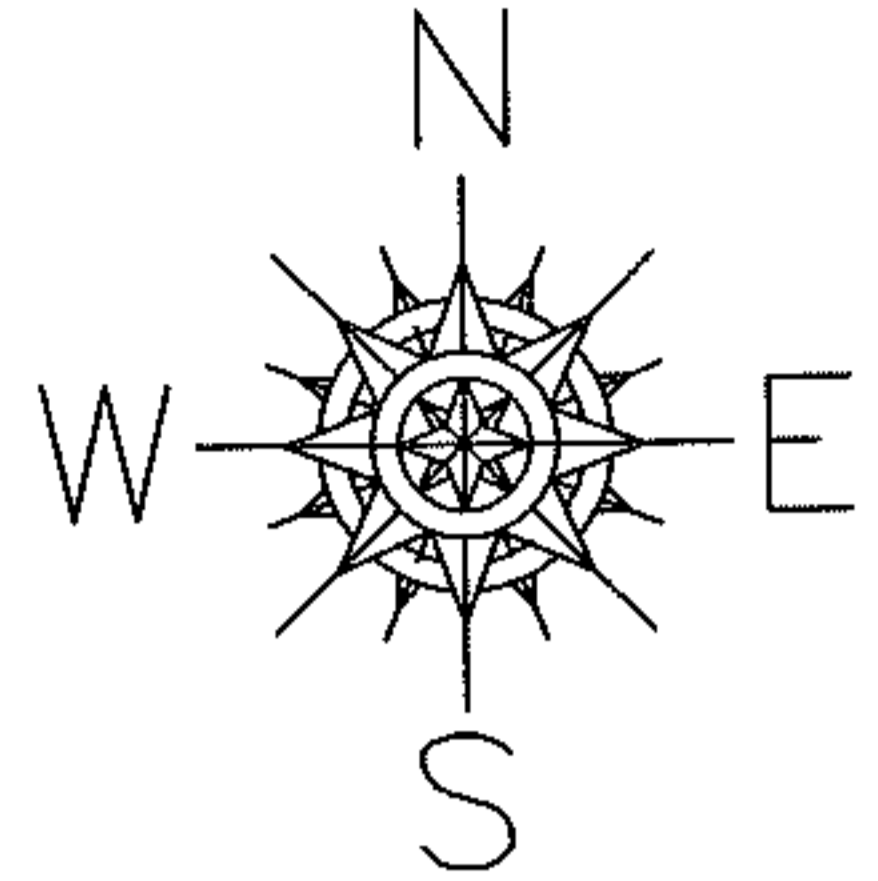

SPLITS/DEEDS PROCESSED

LORAIN COUNTY TAX MAP DEPARTMENT
226 MIDDLE AVE. ELYRIA, OHIO

SURVEYED BY: THOMAS A. SIMON

CLOSURE: 0.01 : 10,000

MAP PAGE(S): 5-G

APPROVED BY: TJS DATE: 03/02/10

SCALE: 1" = 400 PRIOR INSTRUMENT: OR 1037/24