
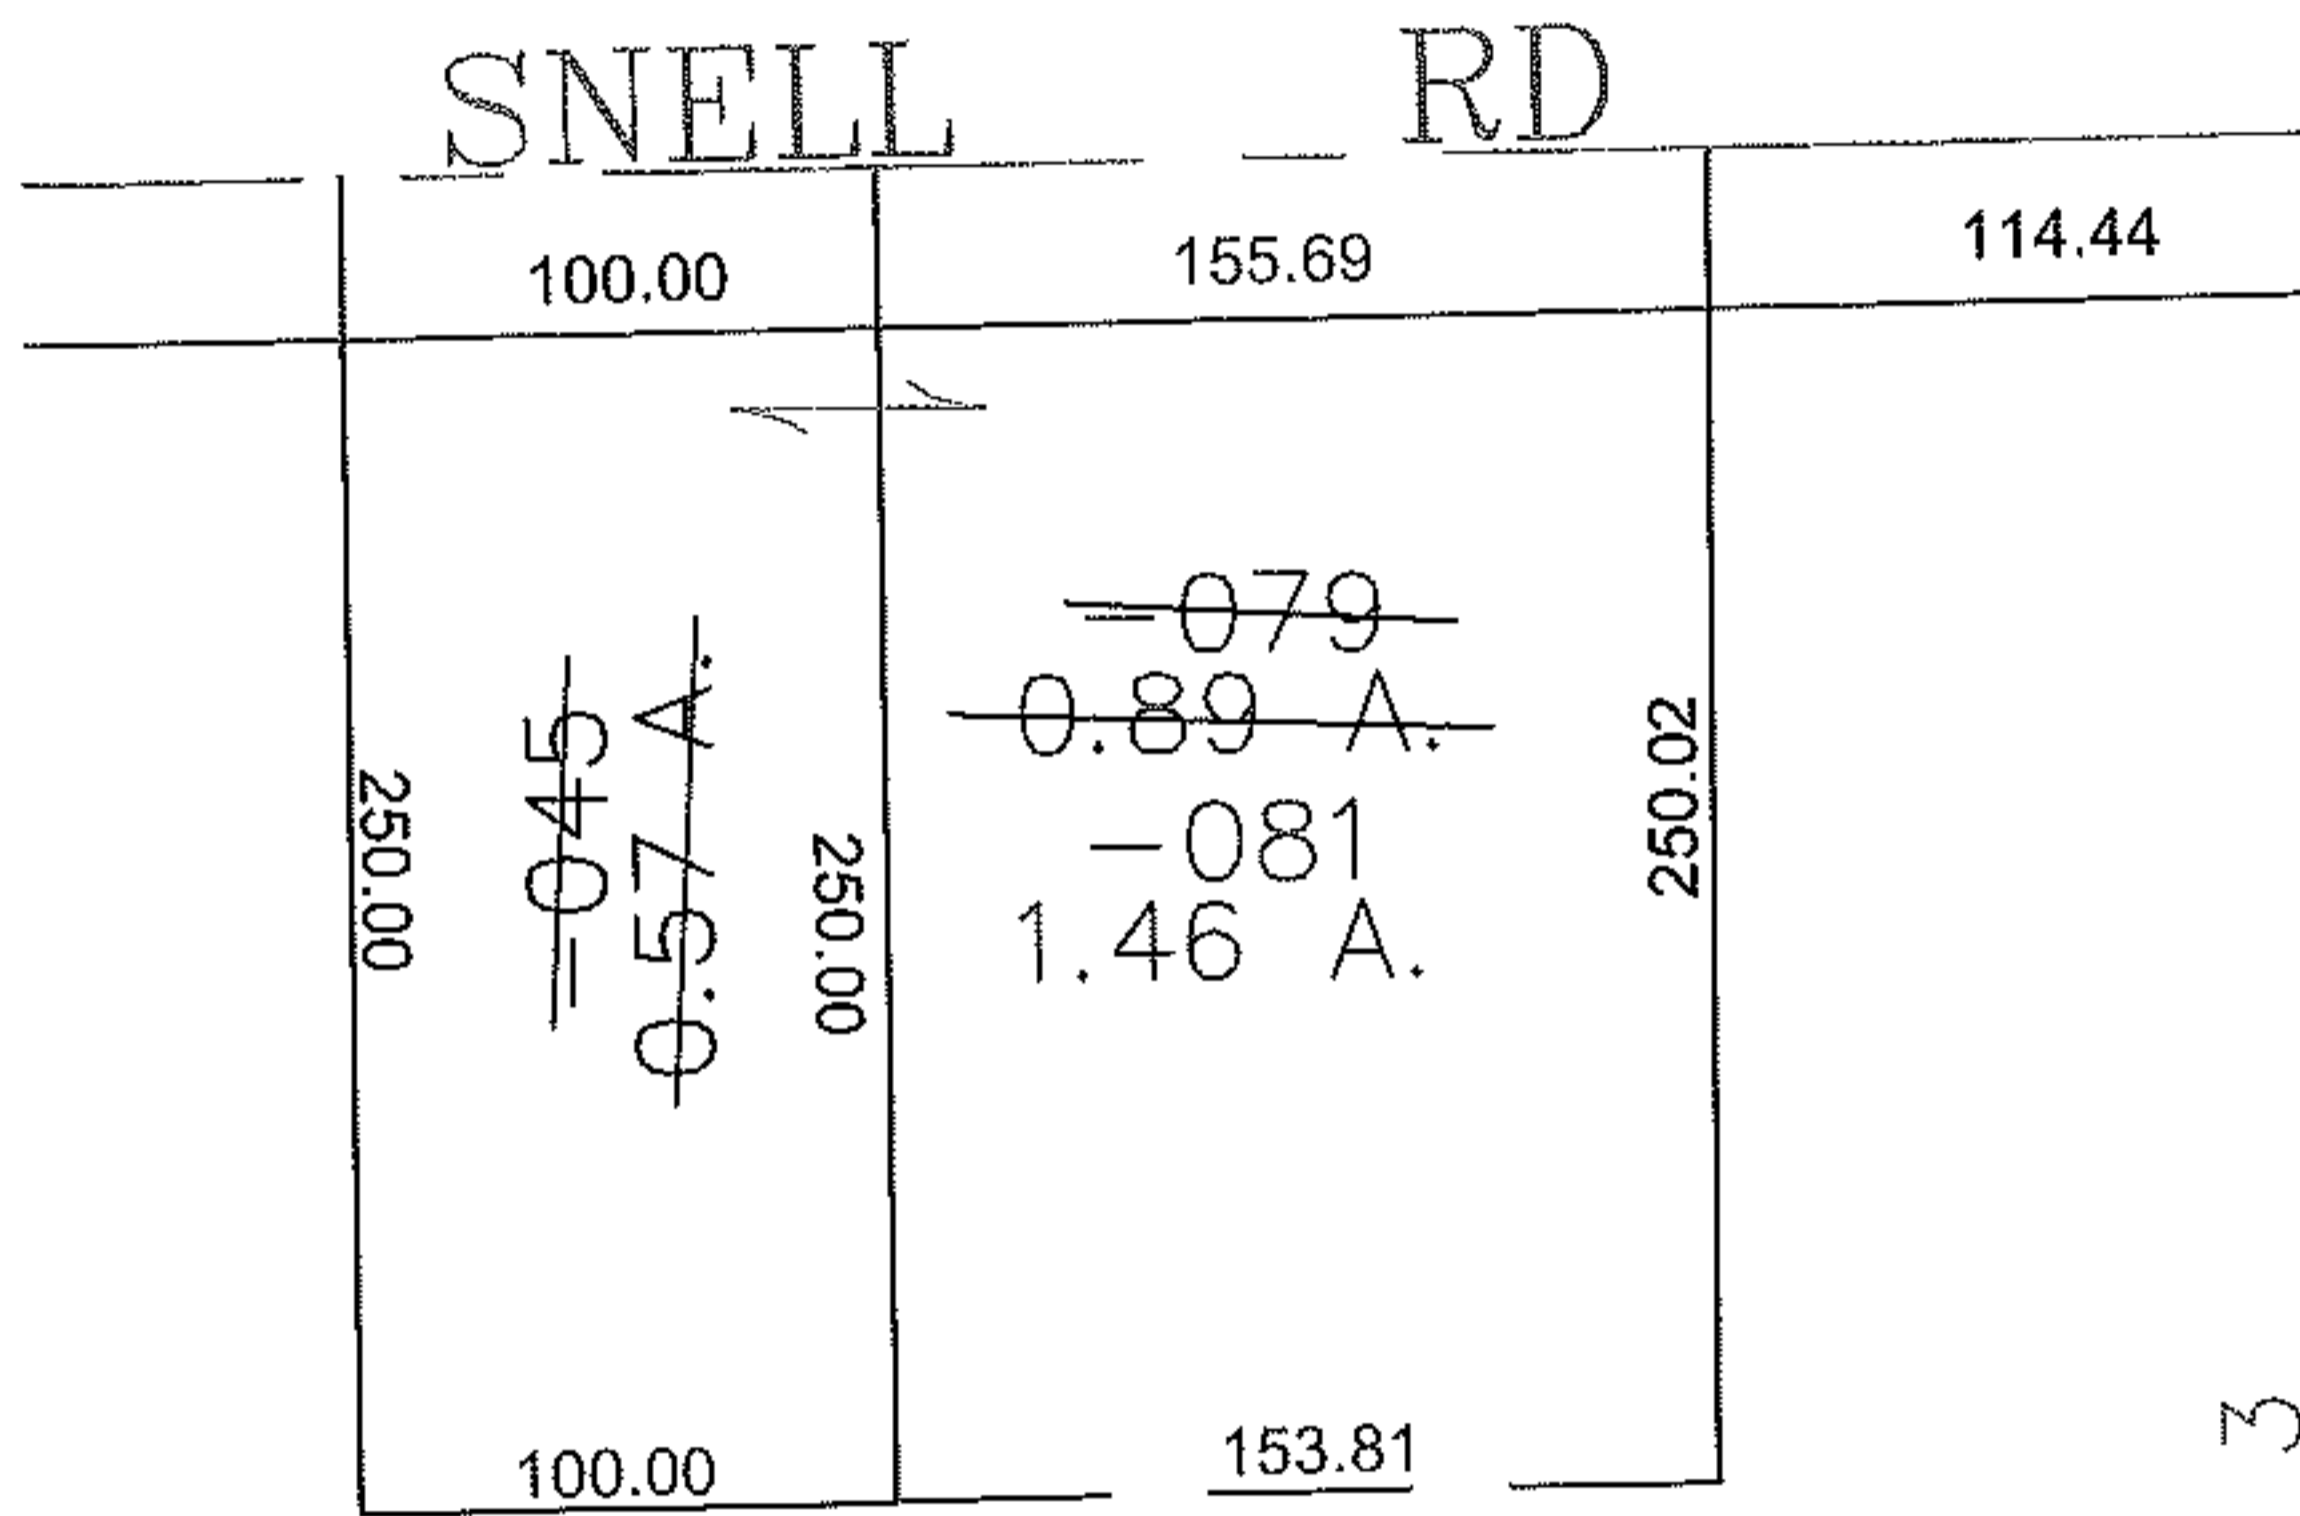


PARENT PARCEL: 12-00-003-000-078, -045


CHILD PARCEL: 12-00-003-079 THRU -081

STARTING POINT: CENTERLINE OF CENTERLINE OF SNELL RD & O.L. 3

10-02809

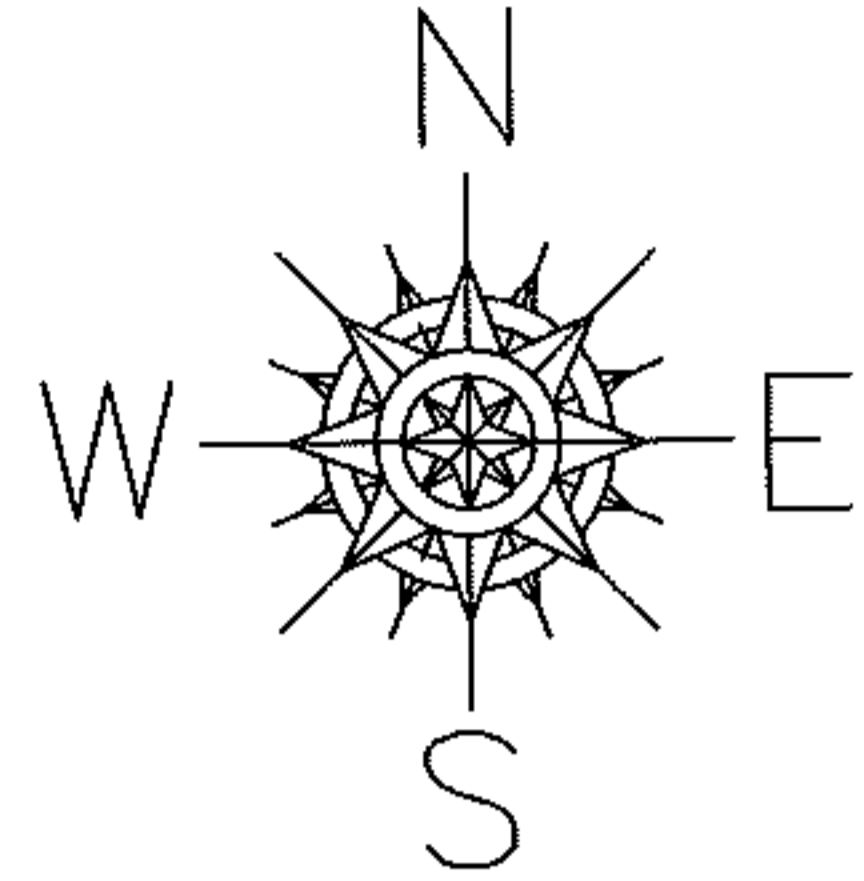

~~-078~~
38.16 A.
~~-080~~
37.27 A.

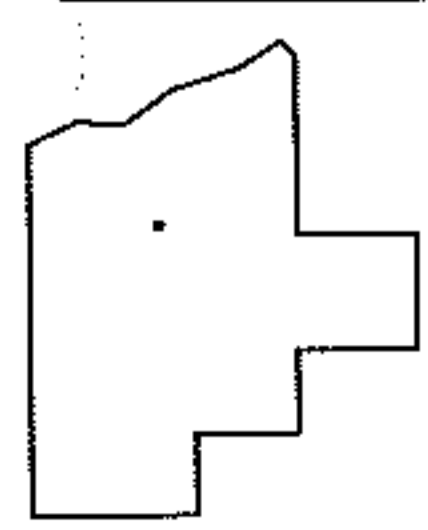

SPLITS/DEEDS PROCESSED

LORAIN COUNTY TAX MAP DEPARTMENT
226 MIDDLE AVE. ELYRIA, OHIO

SURVEYED BY: DALE R HAYWOOD

CLOSURE: 0.00 : 10,000

MAP PAGE(S): 12-00-003-B

APPROVED BY: JAH DATE: 3-9-2010

SCALE: 1" = 100 PRIOR INSTRUMENT: 20070218633