
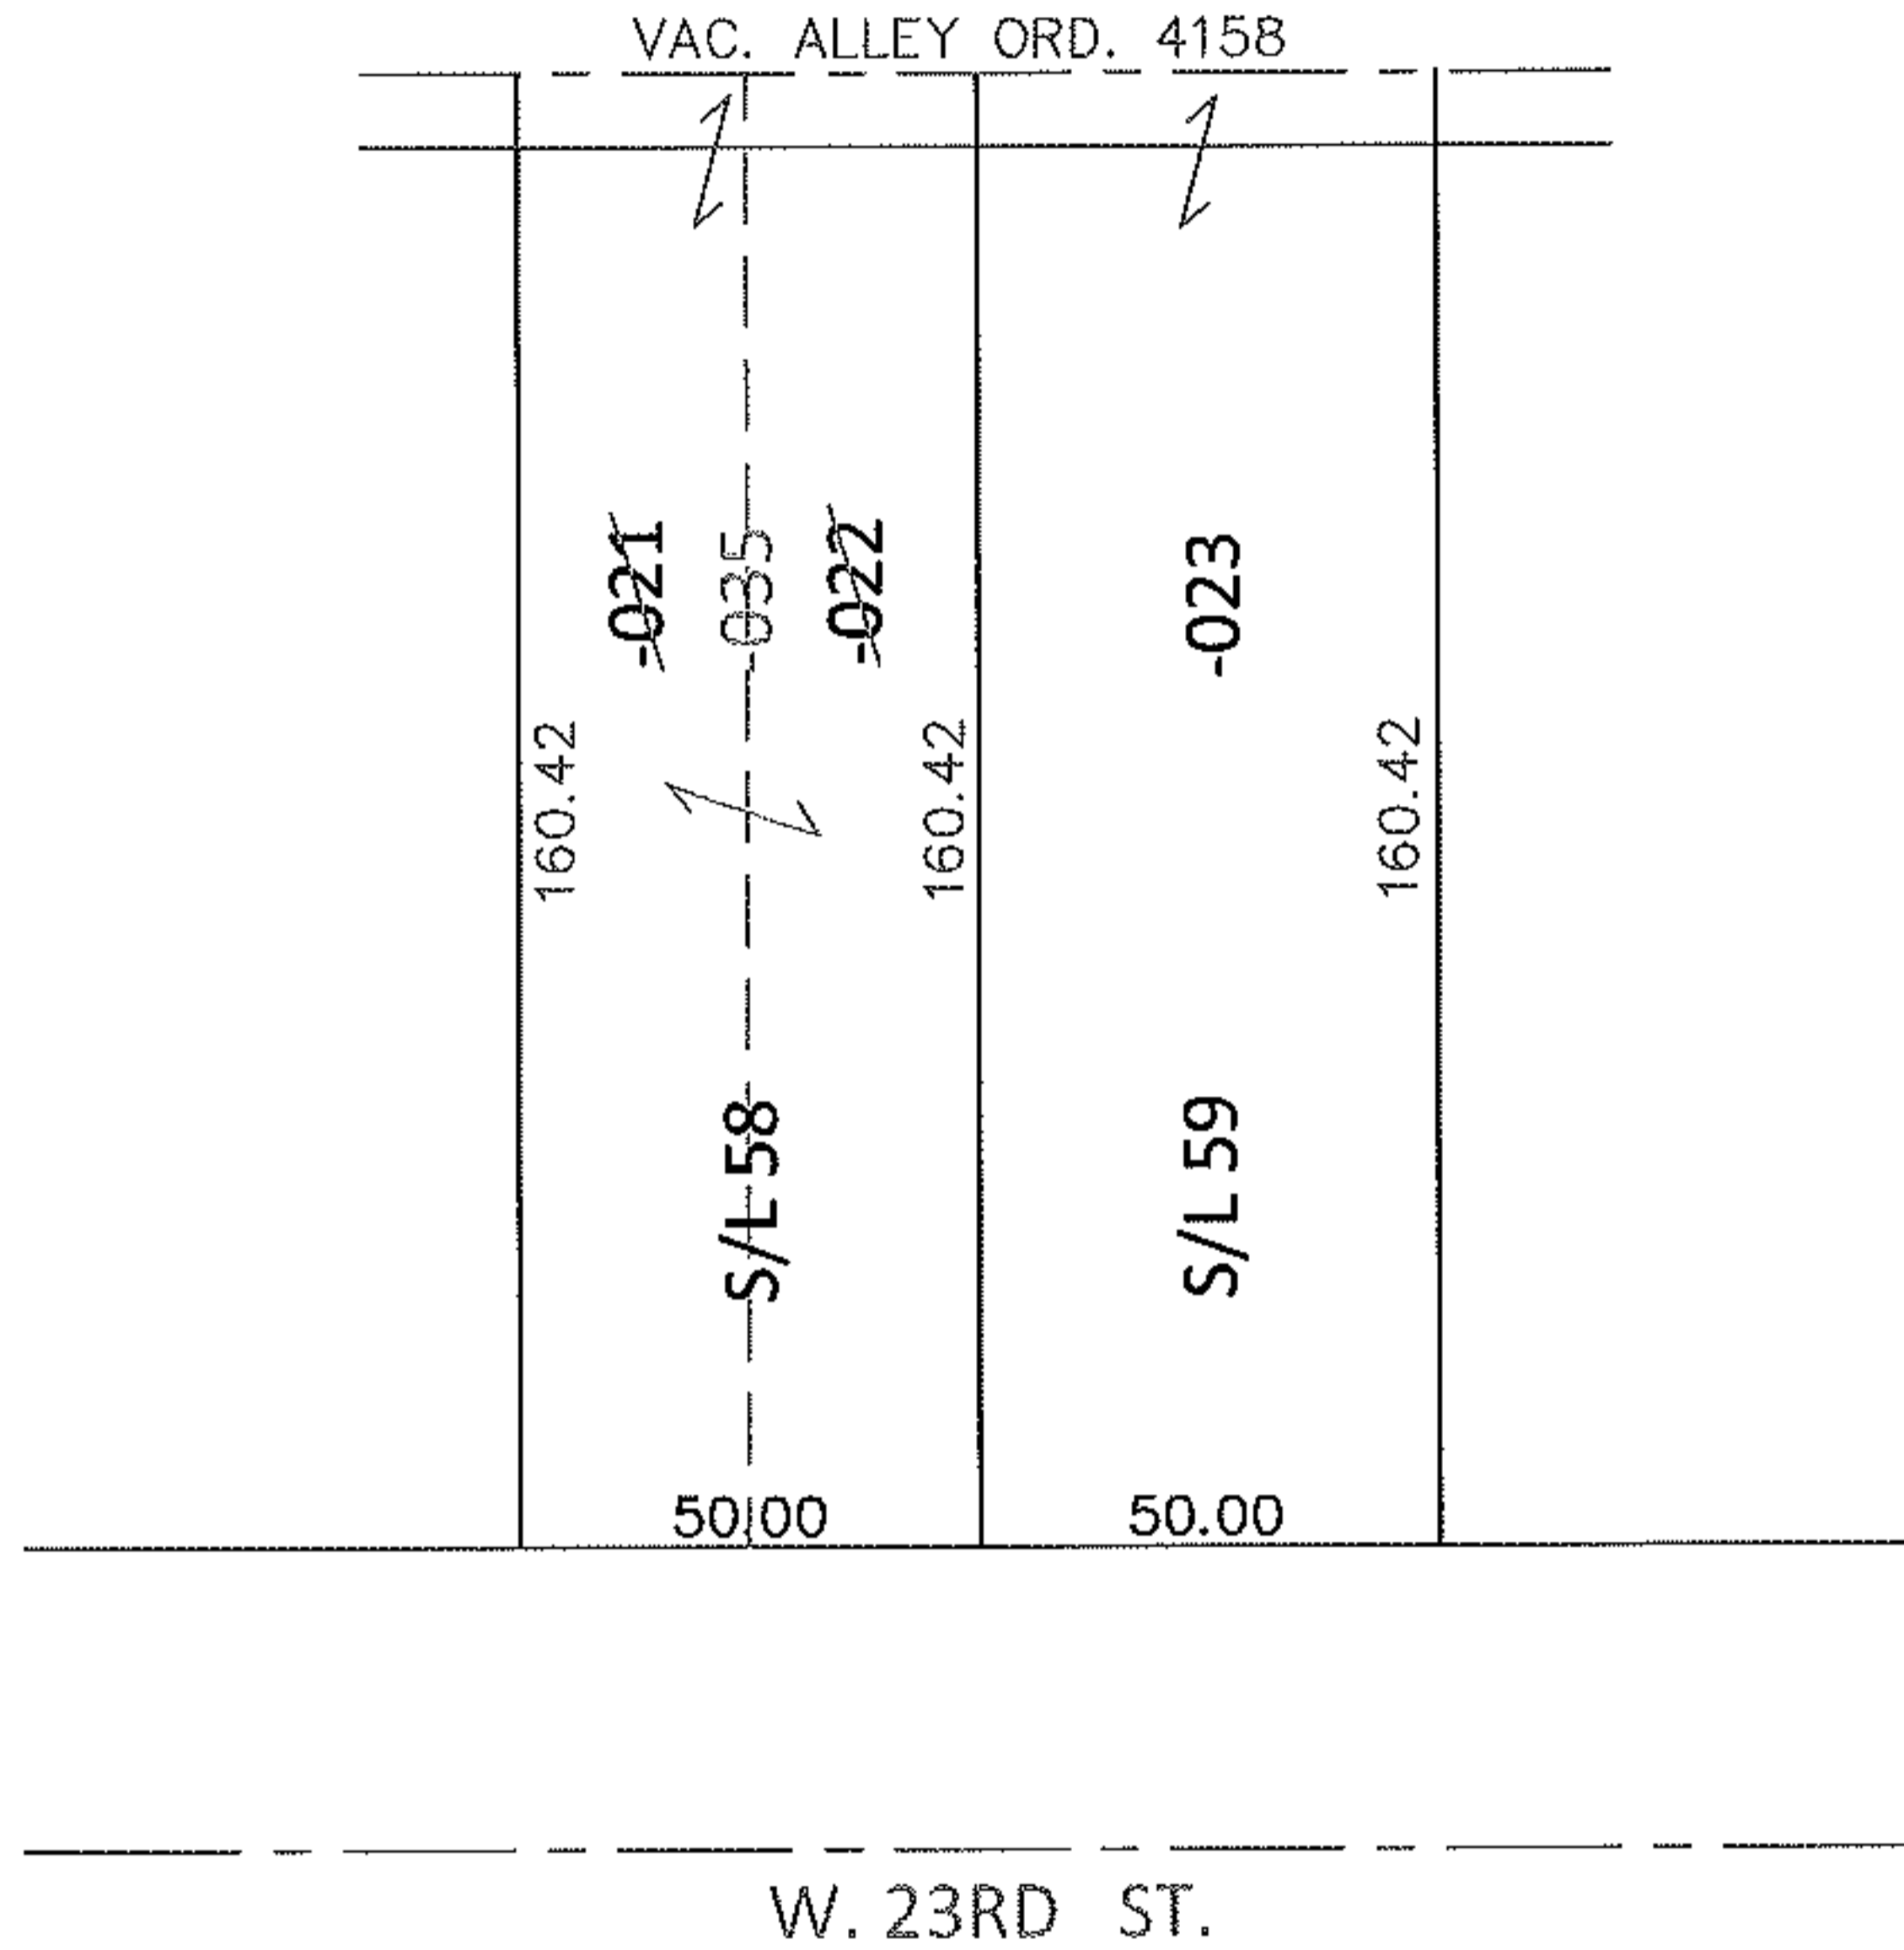


PARENT PARCEL: 02-01-006-155-021, -022, -023

CHILD PARCEL: 02-01-006-155-023, -035

STARTING POINT: S/L'S 57 & 58 IN STANG'S 2ND SUB. (VOL.4 PG.18)

13-02810-C

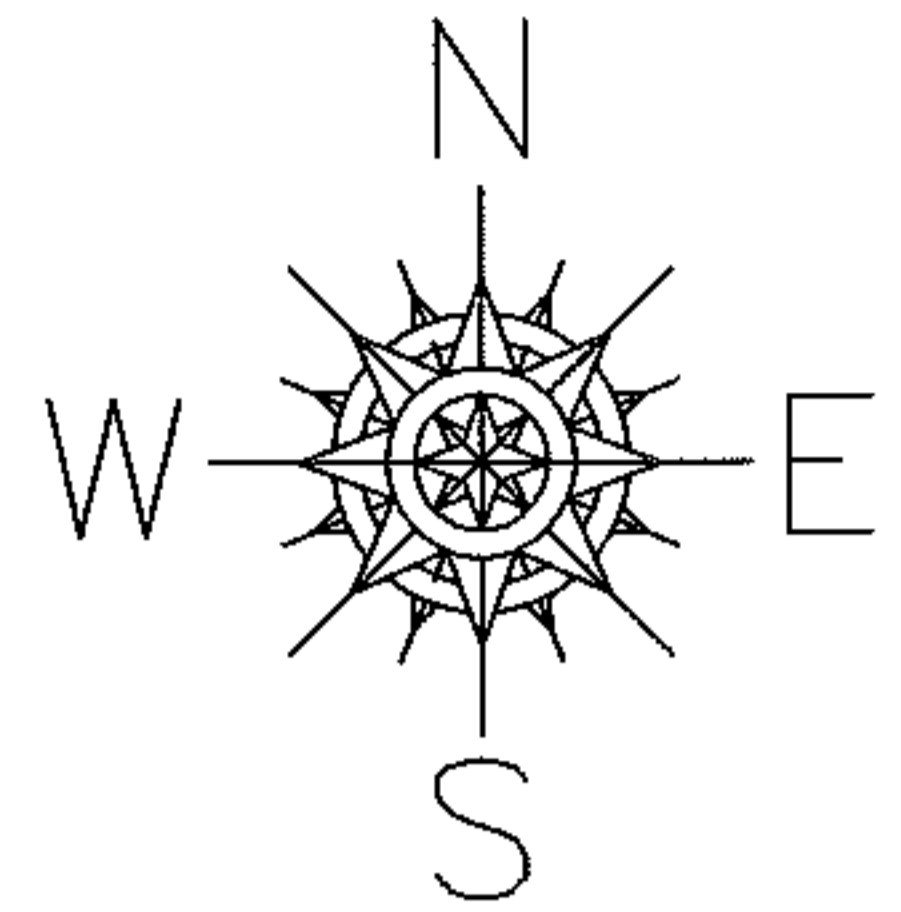


DEPTH CORRECTION

02-01-006-155-023  
160.42  
50 X 152.00

COMBINATION & DEPTH CORRECTION

~~02-01-006-155-021~~    ~~02-01-006-155-022~~  
~~25 X 152~~                      ~~25 X 152~~  
02-01-006-155-035  
50 X 160.42

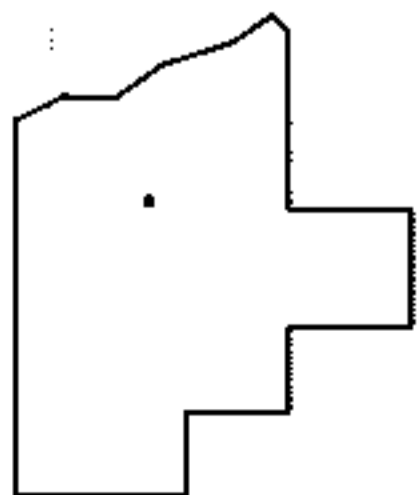

SPLITS/DEEDS PROCESSED

LORAIN COUNTY TAX MAP DEPARTMENT  
226 MIDDLE AVE. ELYRIA, OHIO

SURVEYED BY: N/A  
CLOSURE: N/A  
MAP PAGE(S): 02-01-006-F  
APPROVED BY: RRM    DATE: 9-23-13  
SCALE: 1" = 50'    PRIOR INST.: 20130465622