
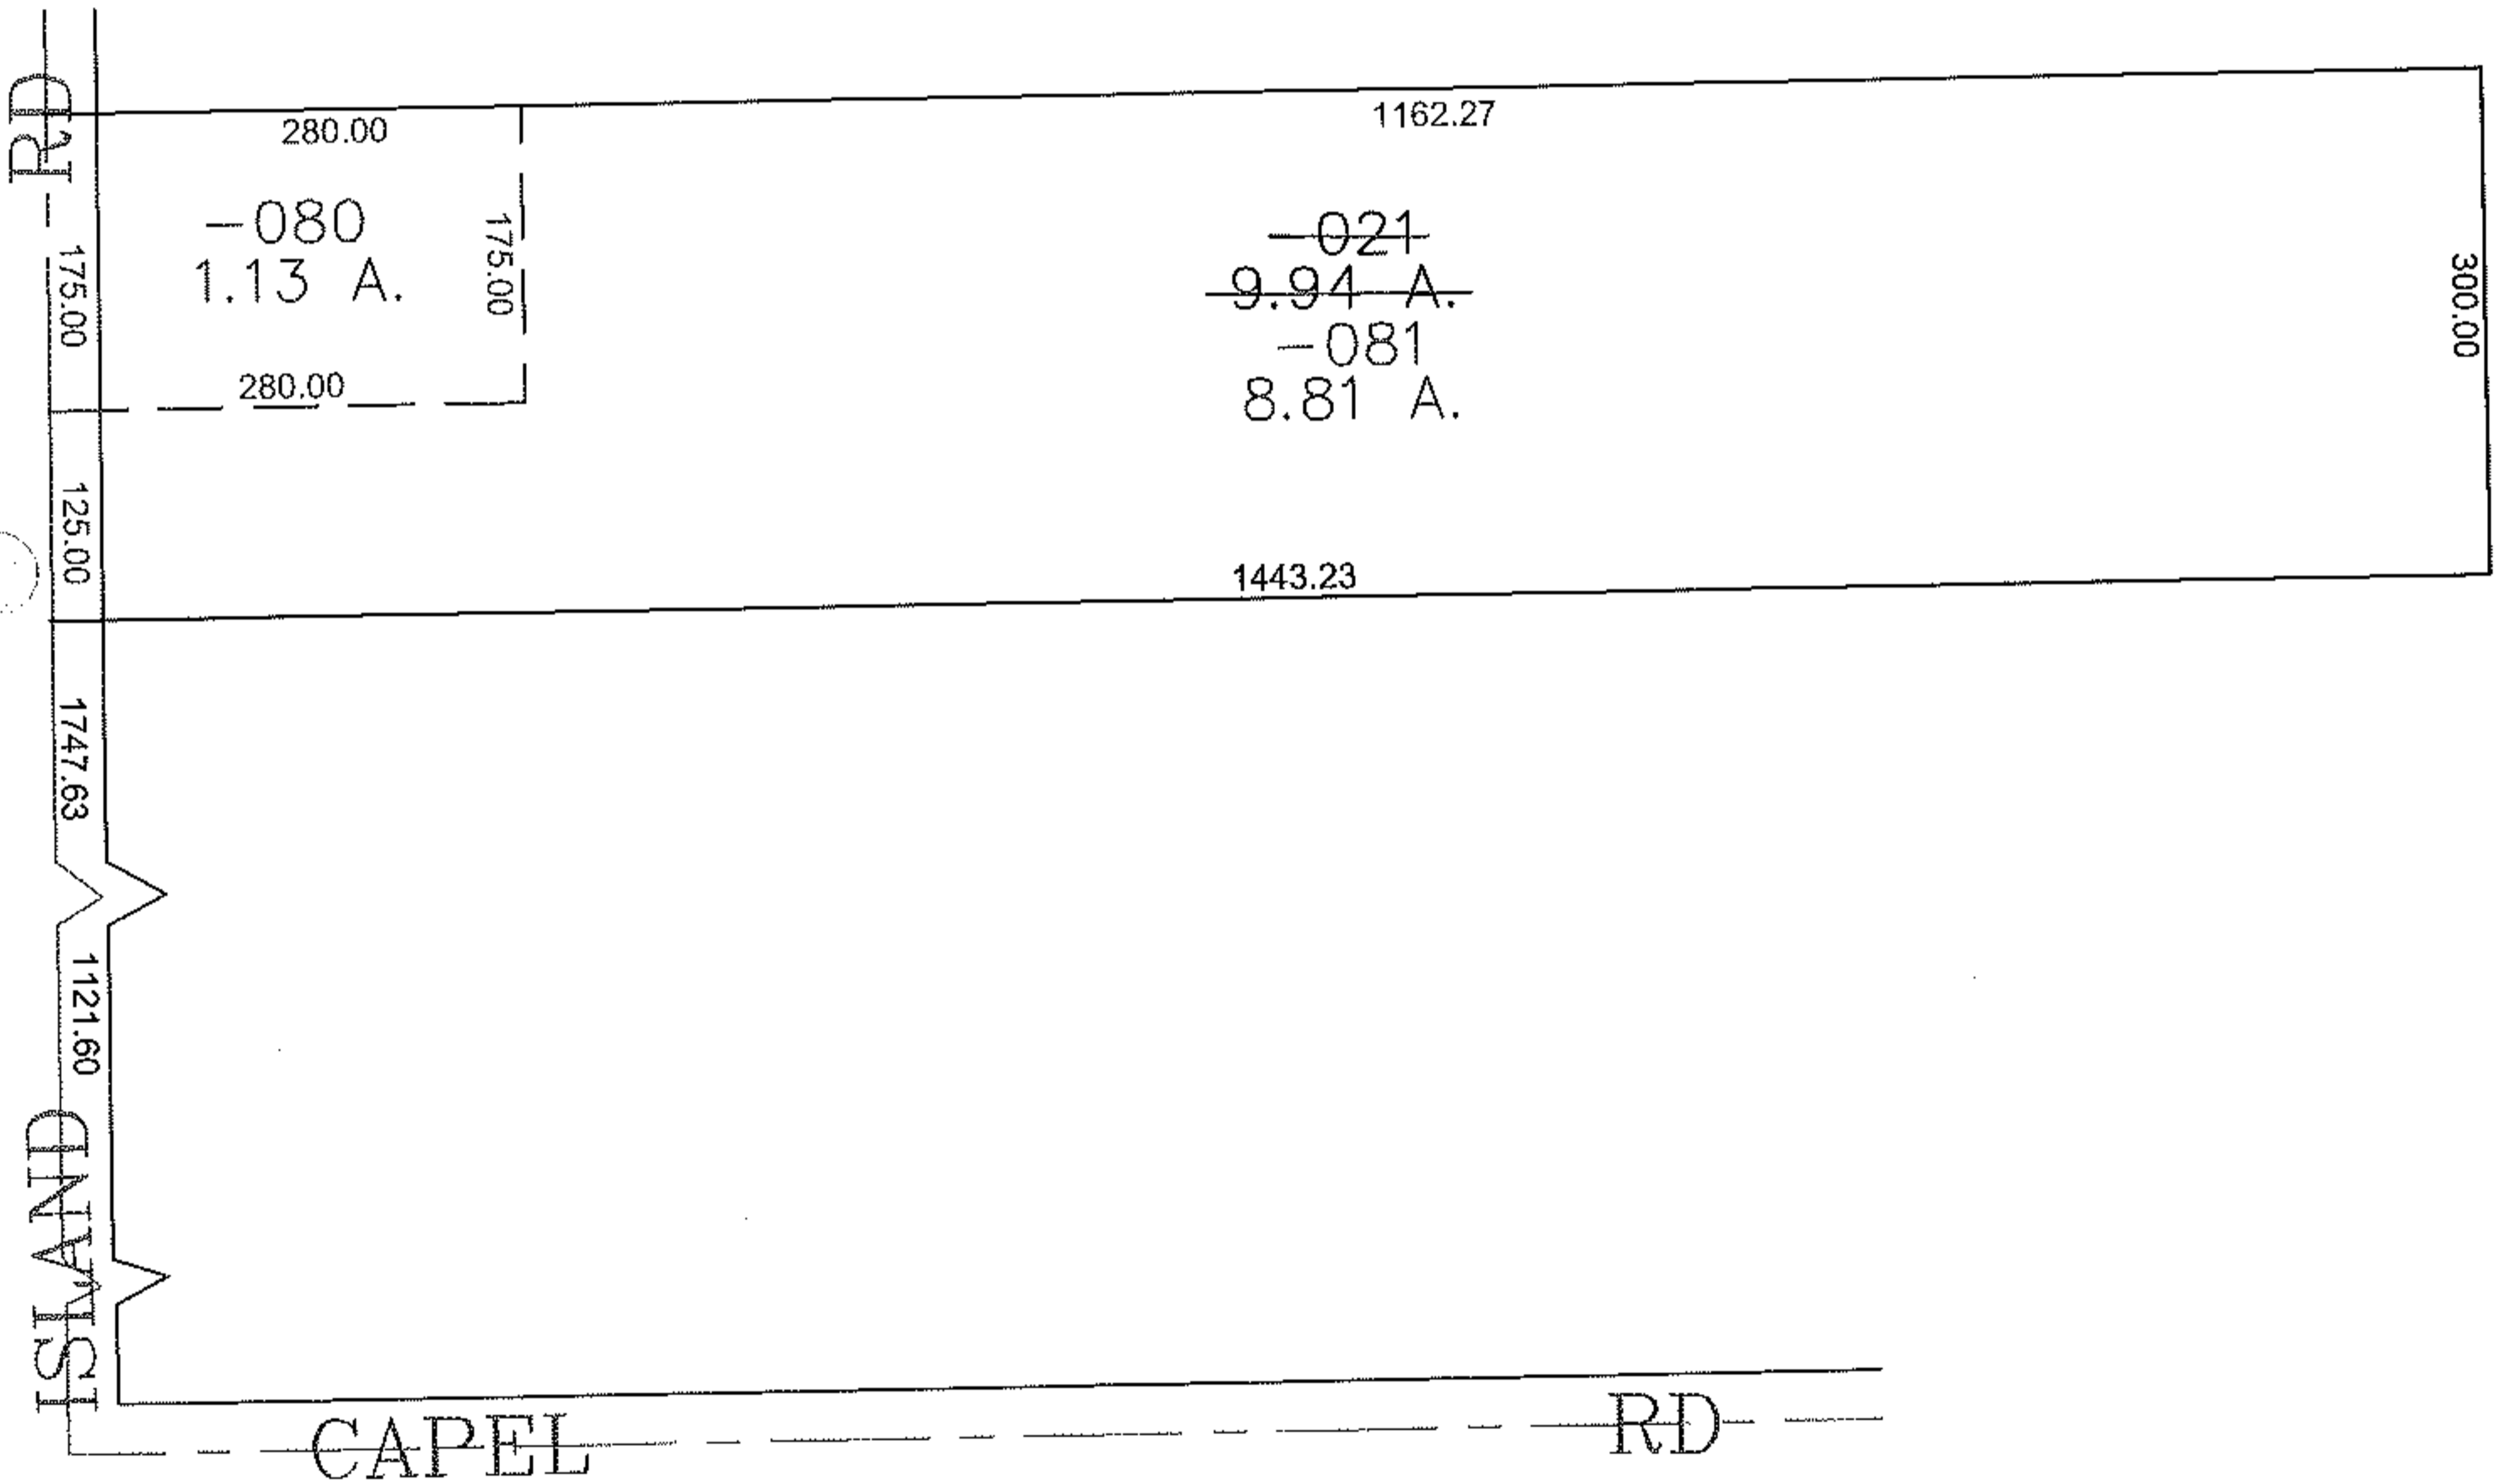


PARENT PARCEL: 11-00-024-000-021

CHILD PARCEL: 11-00-024-000-080, -081

STARTING POINT: CENTERLINE OF CAPEL RD & ISLAND RD

10-02813

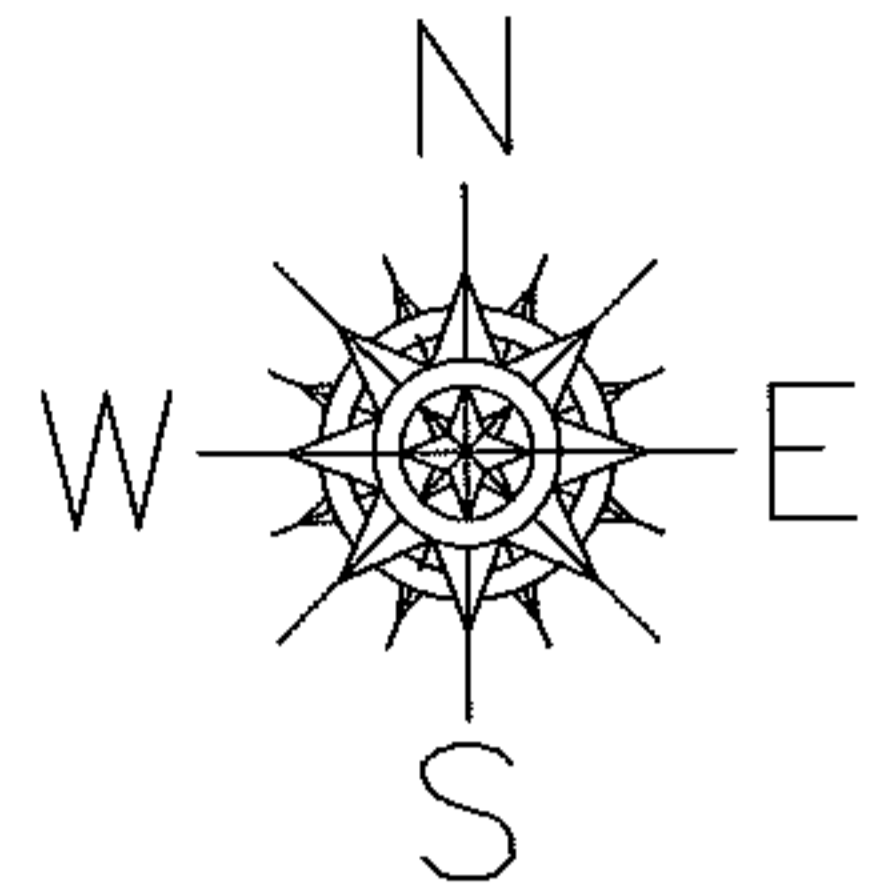

**SPLITS/DEEDS PROCESSED**

LORAIN COUNTY TAX MAP DEPARTMENT  
226 MIDDLE AVE. ELYRIA, OHIO

SURVEYED BY: DALE HAYWOOD  
 CLOSURE: 0.00 : 10.000  
 MAP PAGE(S): 11-00-024-A  
 APPROVED BY: JAH DATE: 3-22-10  
 SCALE: 1" = 200 PRIOR INSTRUMENT: DV 1341/611