
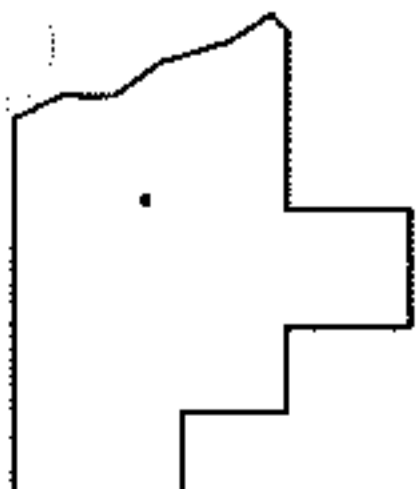
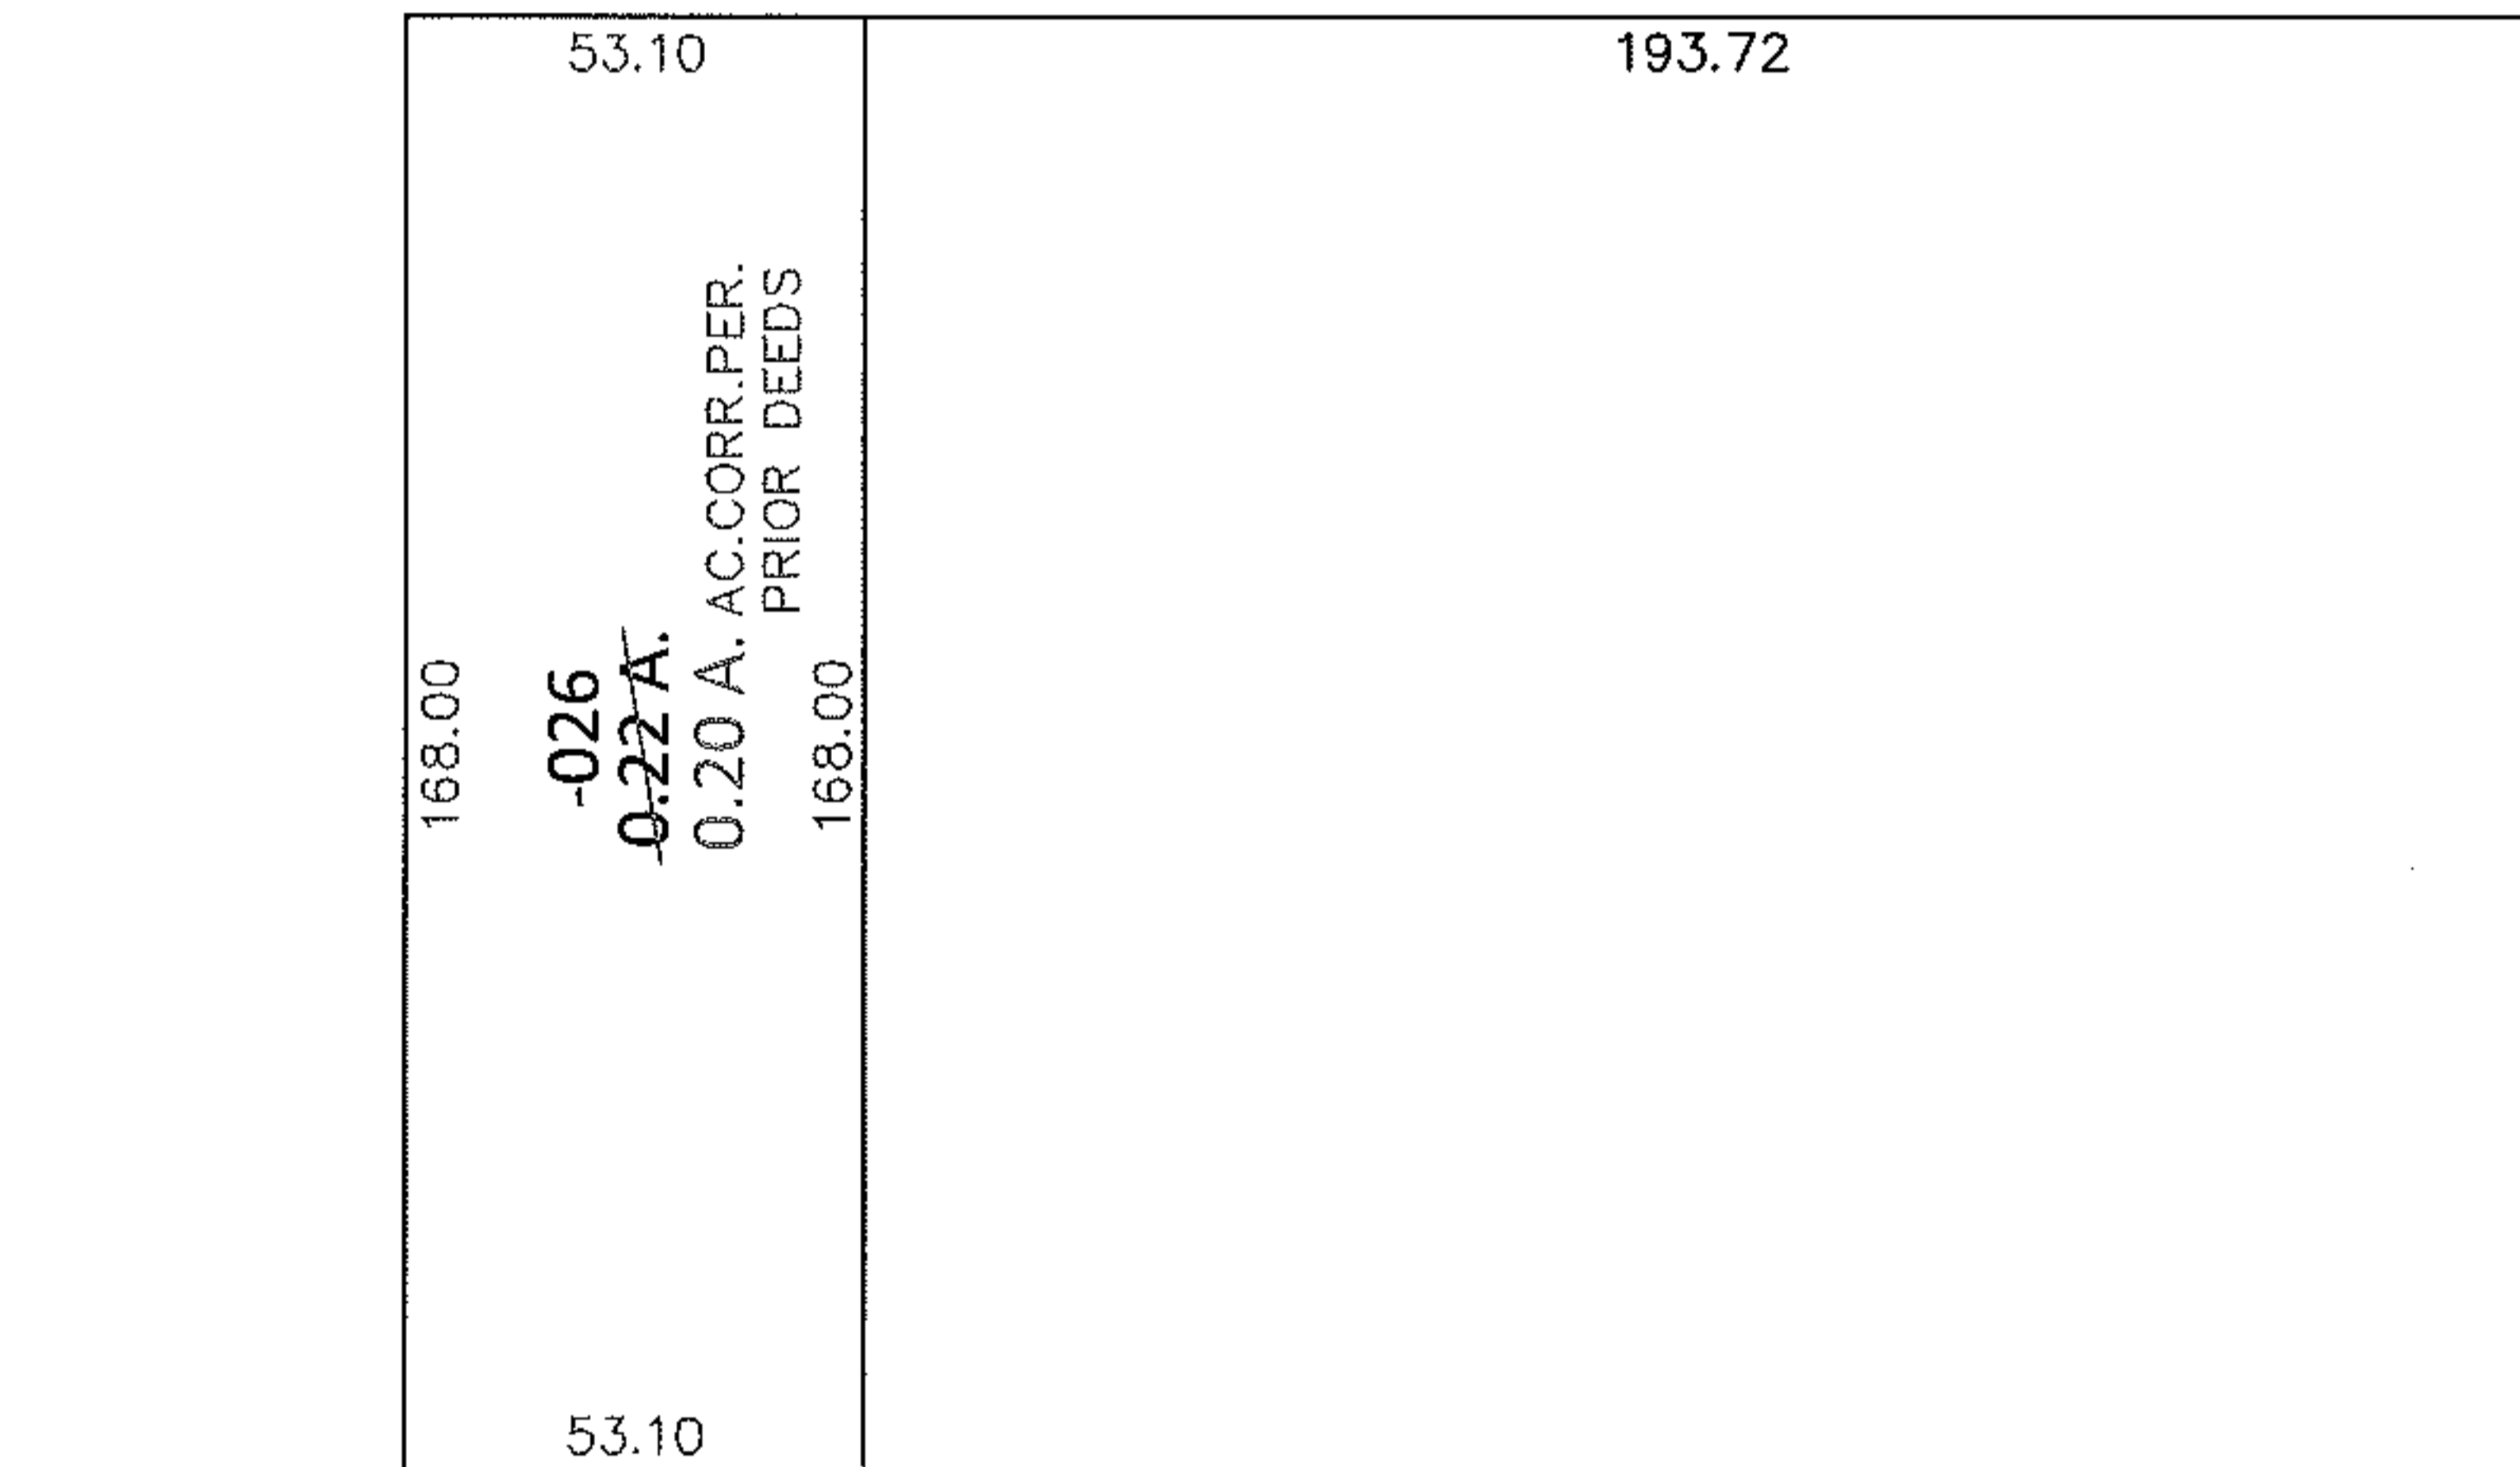


PARENT PARCEL: 06-24-035-101-026

CHILD PARCEL: \_\_\_\_\_

13-02816-A

STARTING POINT: NORTHEAST CORNER OF LAND CONVEYED TO J.E. WISE (DV 218/279)

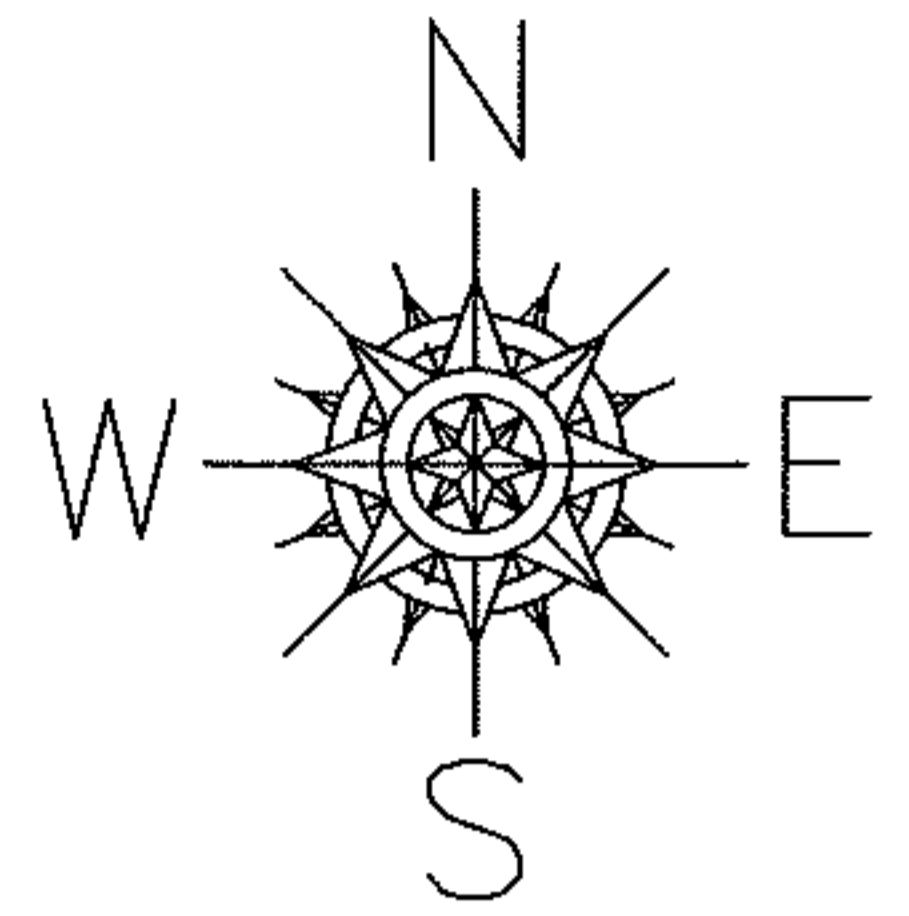

**SPLITS/DEEDS PROCESSED**

LORAIN COUNTY TAX MAP DEPARTMENT  
226 MIDDLE AVE. ELYRIA, OHIO

SURVEYED BY: N/A

CLOSURE: N/A

MAP PAGE(S): 6-60

APPROVED BY: RRM DATE: 10-7-13

SCALE: 1"= 50' PRIOR INST.: 20130481024